


B.M. # 5 - "□" cut on T.C. Northmost Inlet
So. corner East side Sunbelt Dr.
60' Rt. Sta. 22+40
ELEV. 628.21

NOTE: All Driveway Radii are 10' unless otherwise noted

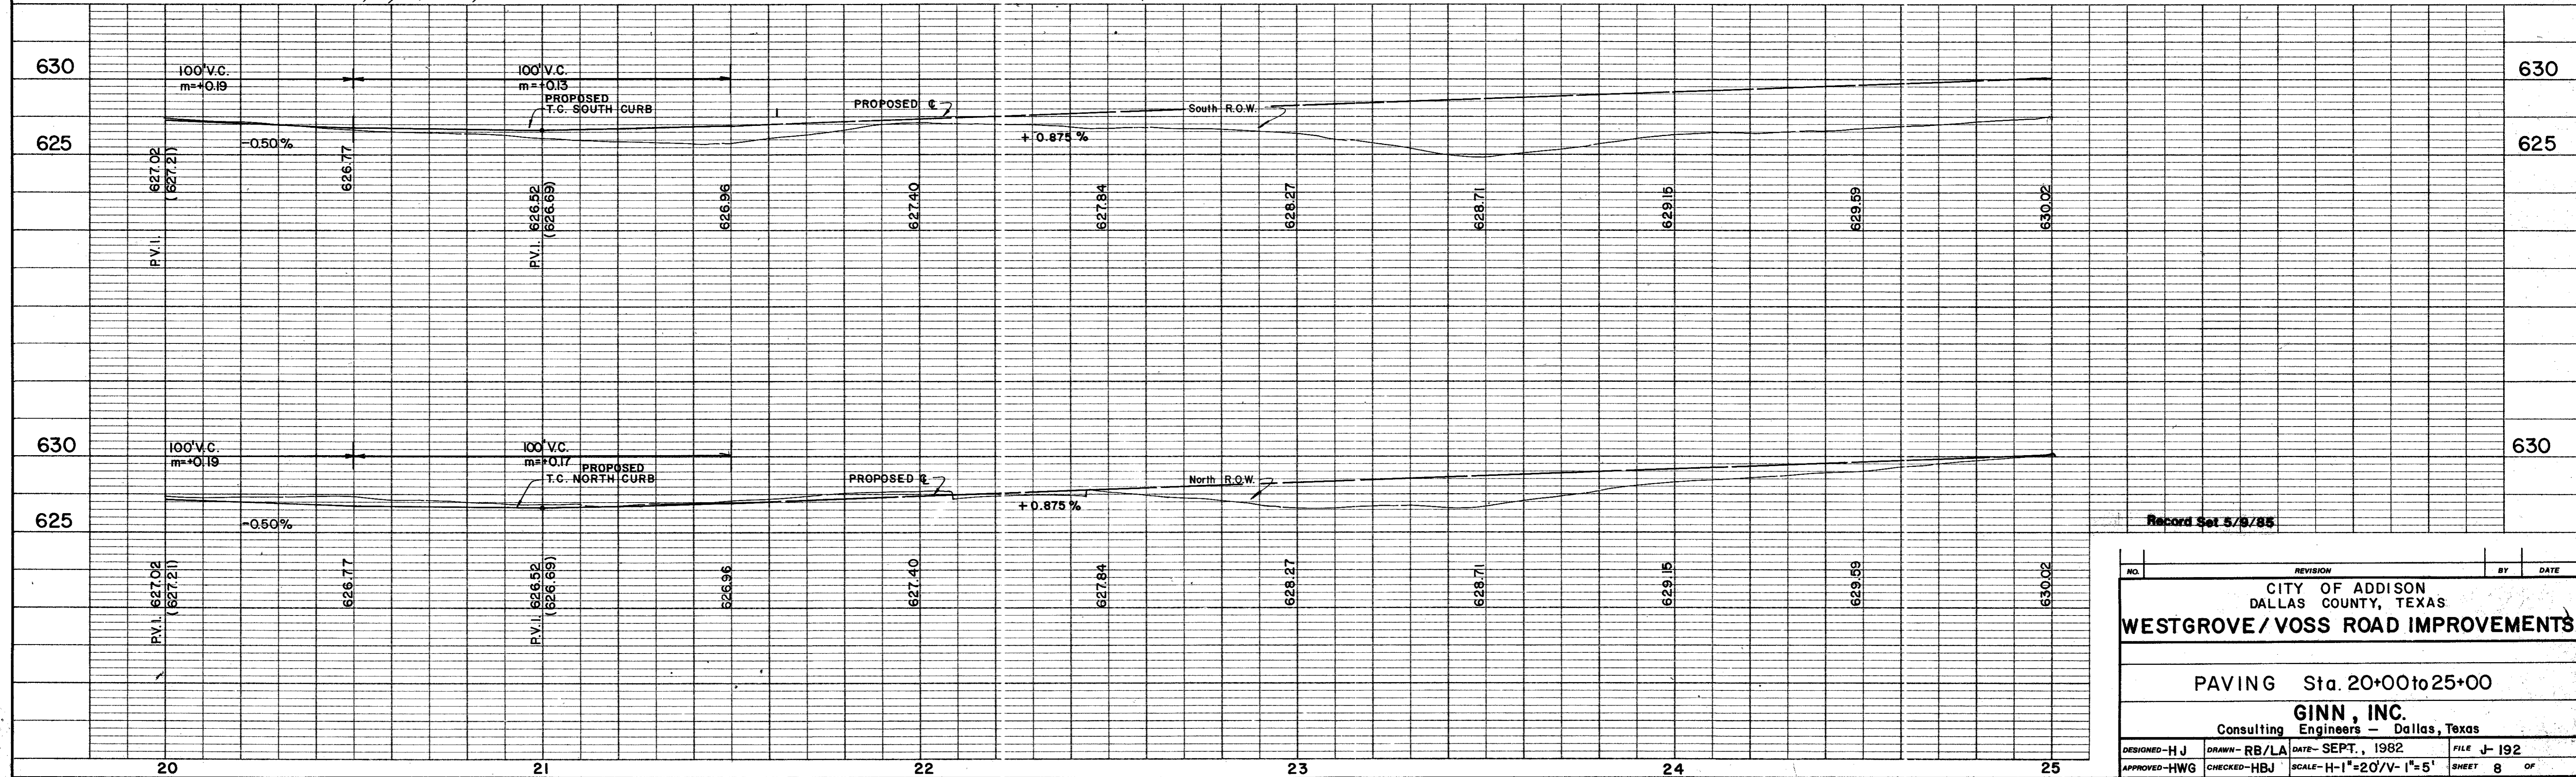

NO.	REVISION	BY	DATE
CITY OF ADDISON DALLAS COUNTY, TEXAS			
WESTGROVE / VOSS ROAD IMPROVEMENTS			
PAVING Sta. 20+00 to 25+00			
GINN, INC. Consulting Engineers - Dallas, Texas			
DESIGNED - HJ	DRAWN - RB/LA	DATE - SEPT., 1982	FILE - J-192
APPROVED - HWG	CHECKED - HBJ	SCALE - H-1"=20'/V-1"=5'	SHEET 8 OF