

Q DATA
 ACADEMY DR.
 $\Delta = 45^{\circ}00'00''$
 $R = 235.00'$
 $T = 97.34'$
 $L = 184.57'$


FOR CONTINUATION
 SEE SHT. 34

FOR DETAIL SEE SHT. 34

STA. 54 + 35
 1 - 10" Rec'd Inlet
 T.C. = 660.08
 Opening = 659.08
 INV = 656.08

STA. 54 + 35
 1 - 10" Rec'd Inlet
 T.C. = 660.08
 Opening = 659.08
 INV = 656.08

B.M.#9 - "□" cut on T.C. No. side Sojourn Ln.
 55' Rt. Sta. 51+25
 E.L.V. 660.49

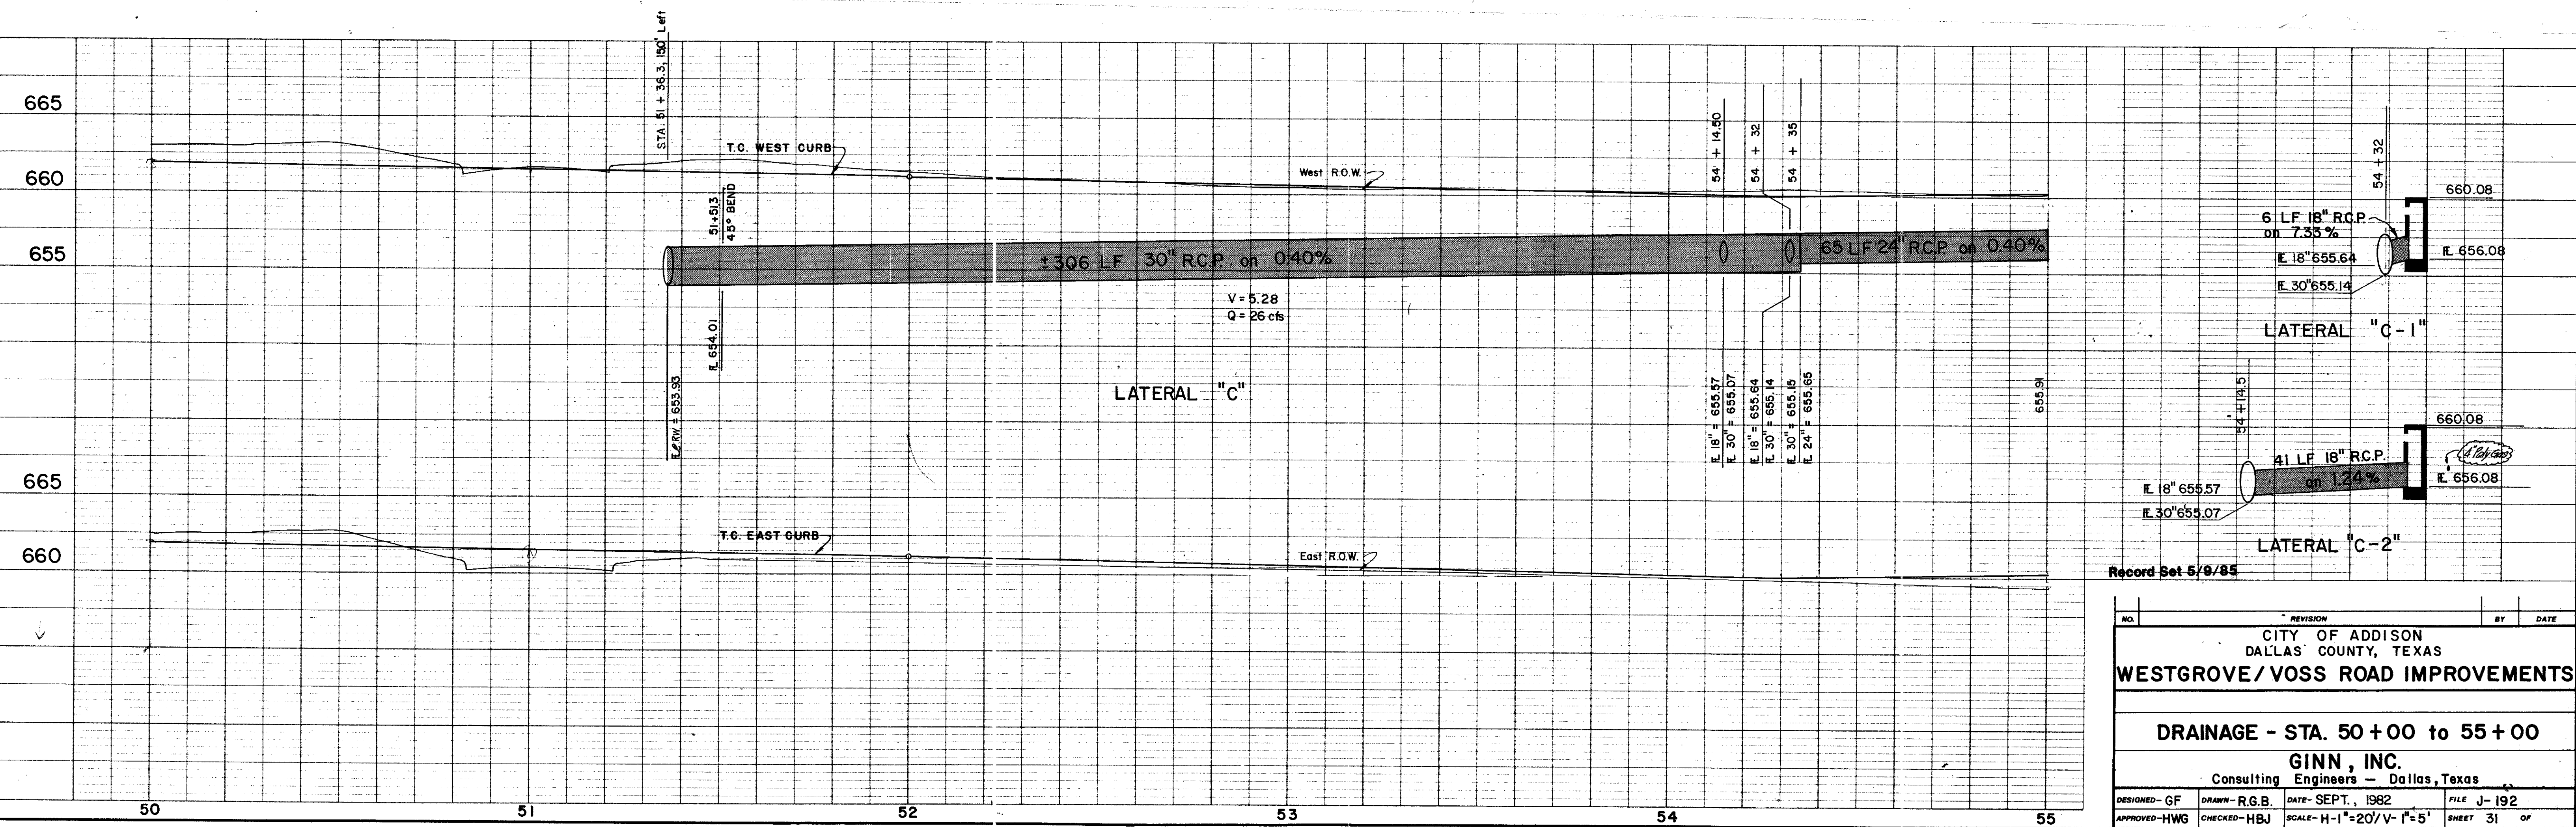

NO.	REVISION	BY	DATE
CITY OF ADDISON DALLAS COUNTY, TEXAS WESTGROVE/VOSS ROAD IMPROVEMENTS DRAINAGE - STA. 50+00 to 55+00 GINN, INC. Consulting Engineers - Dallas, Texas			
DESIGNED - GF	DRAWN - R.G.B.	DATE - SEPT., 1982	FILE J-192
APPROVED - HWG	CHECKED - HBJ	SCALE - H-1"=20'/V-1"=5'	SHEET 31 OF