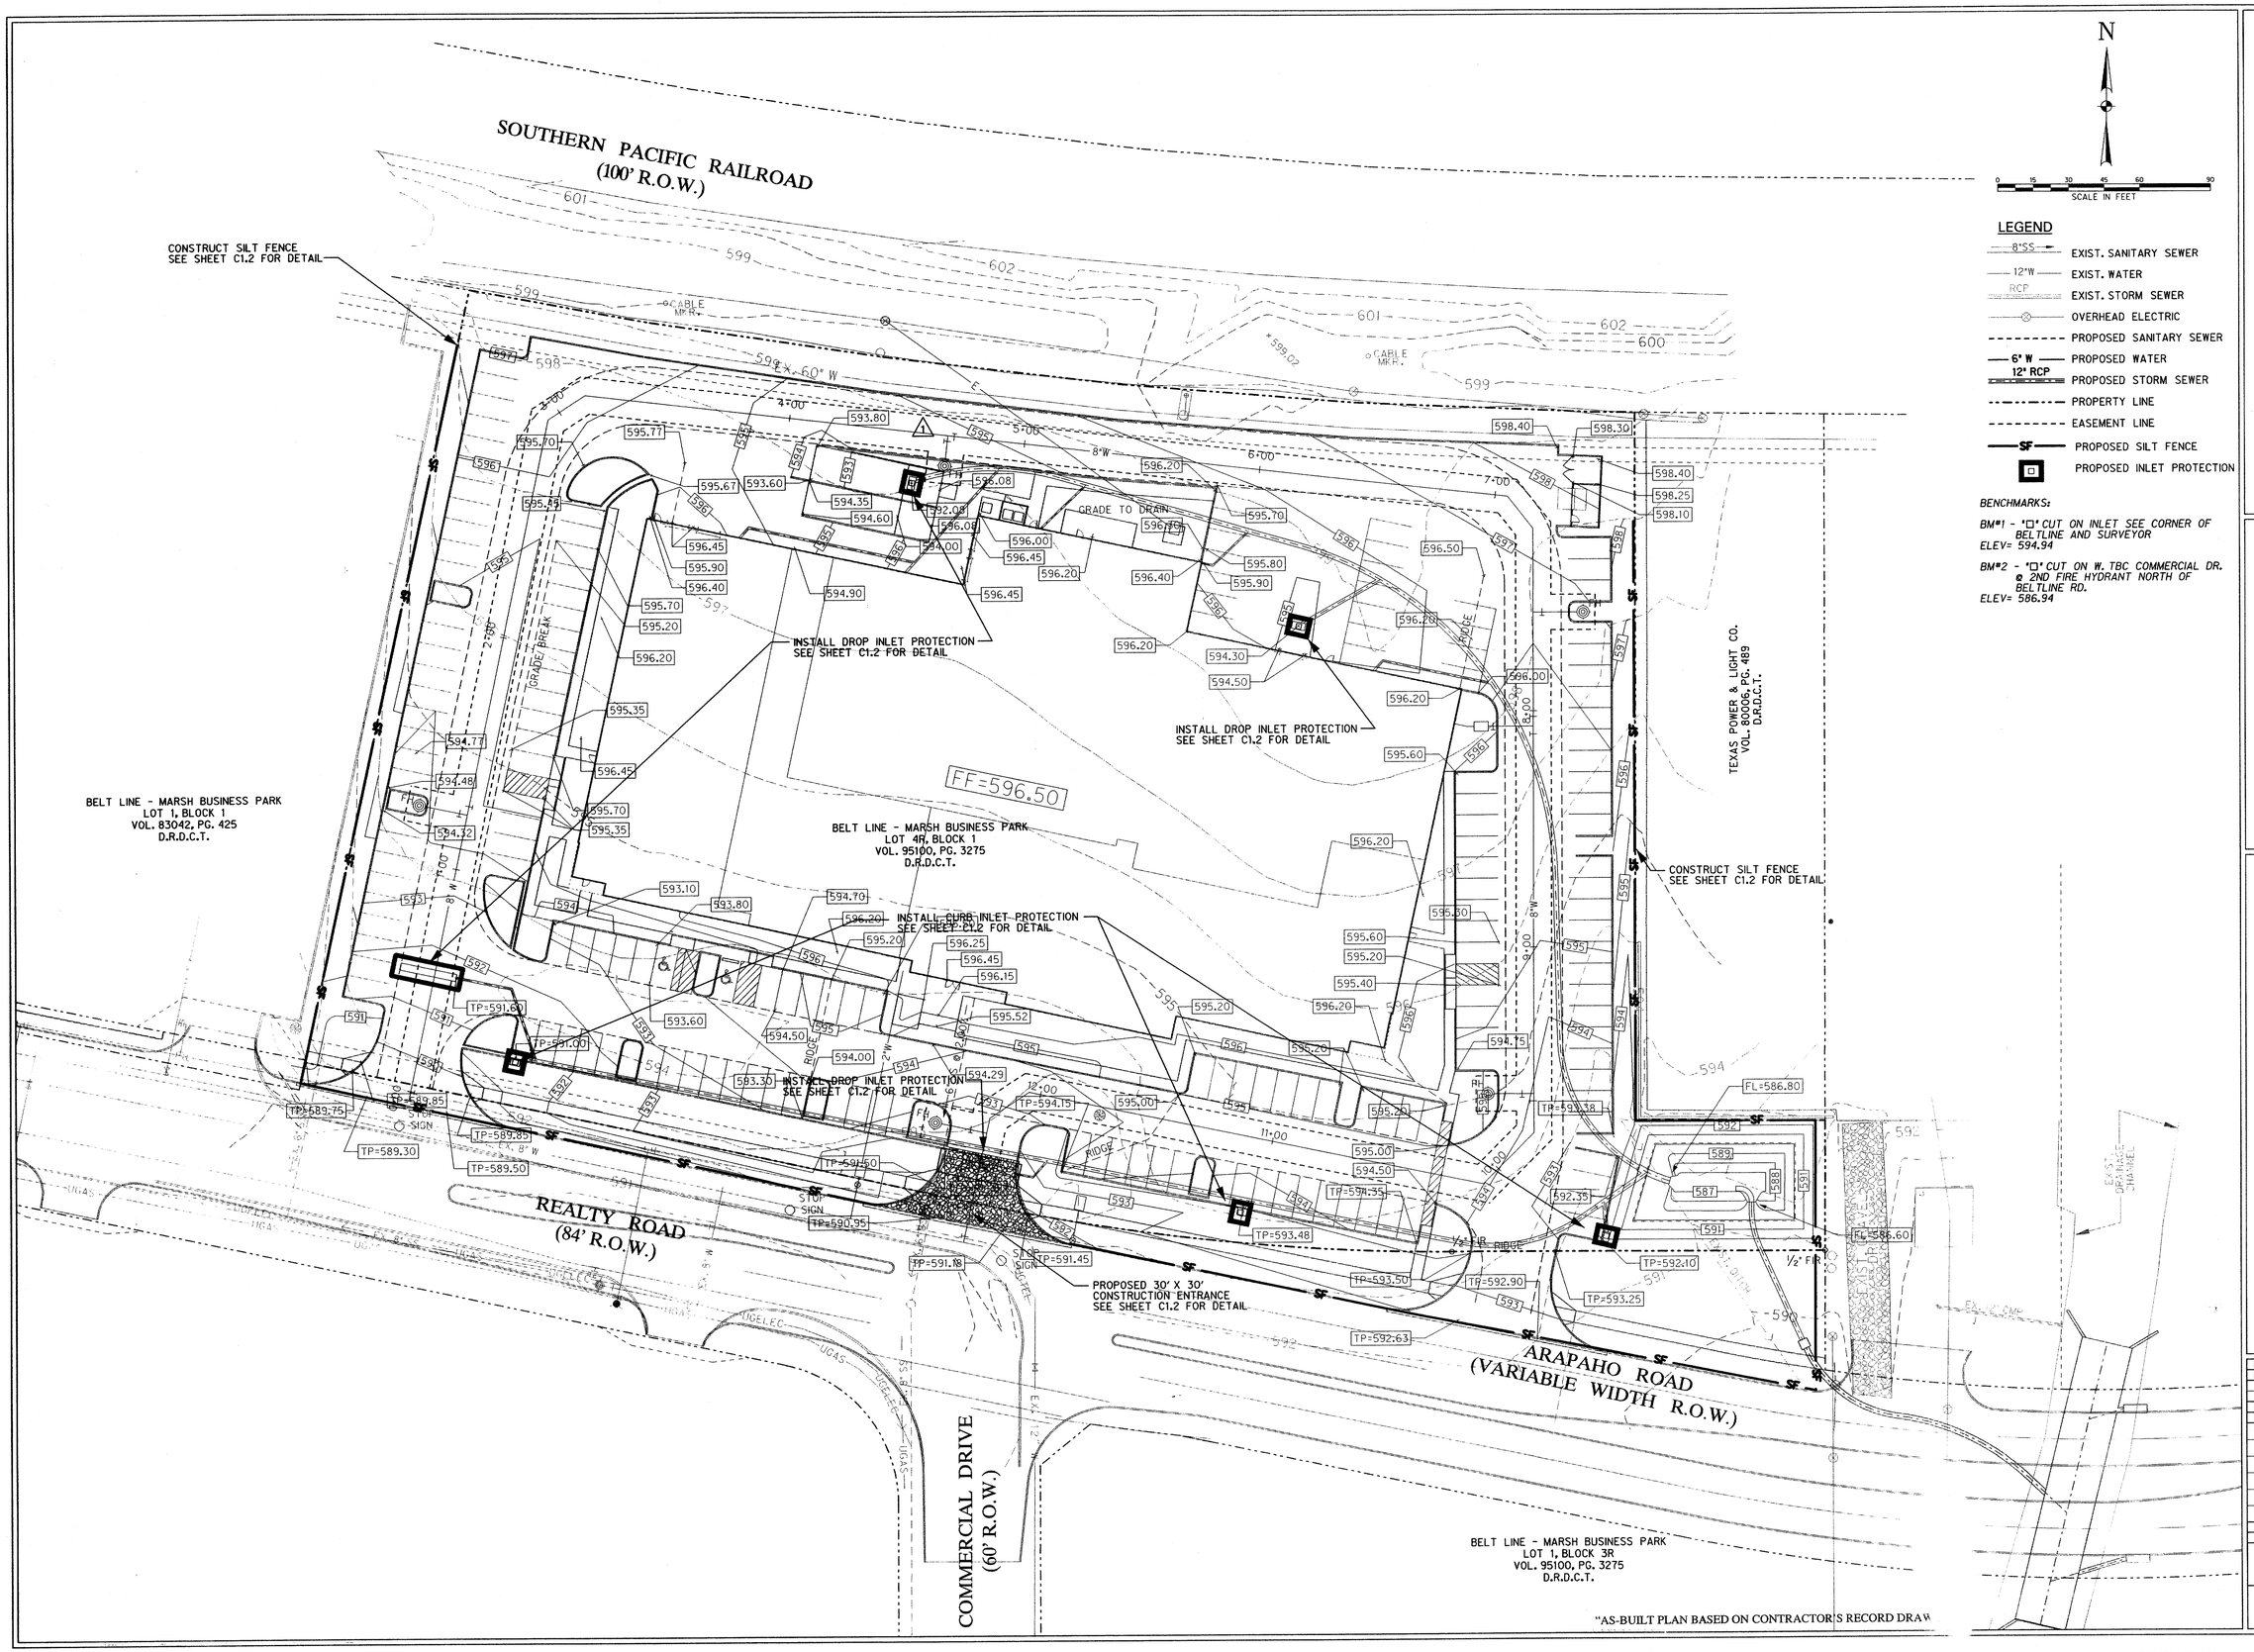

N

SCALE IN FEET

LEGEND

- EXIST. SANITARY SEWER
- EXIST. WATER
- EXIST. STORM SEWER
- OVERHEAD ELECTRIC
- PROPOSED SANITARY SEWER
- PROPOSED WATER
- PROPOSED STORM SEWER
- PROPERTY LINE
- EASEMENT LINE
- PROPOSED SILT FENCE
- PROPOSED INLET PROTECTION

BENCHMARKS:

BM#1 - "□" CUT ON INLET SEE CORNER OF BELTLINE AND SURVEYOR
ELEV= 594.94

BM#2 - "□" CUT ON W. TBC COMMERCIAL DR. @ 2ND FIRE HYDRANT NORTH OF BELTLINE RD.
ELEV= 586.94

OSTEOMED CORPORATION FACILITY

ADDISON, TEXAS

THE SEAL APPEARING ON THIS DOCUMENT WAS AUTHORIZED BY DENNIS J. CHAVAN, P.E. #72584 ON 05-21-02.
PROPER NOTIFICATION TO THE RESPONSIBLE ENGINEER IS AN OFFENSE UNDER THE TEXAS ENGINEERING PRACTICE ACT. THE RECORD COPY OF THIS DRAWING IS ON FILE AT THE OFFICES OF HALFF ASSOCIATES, INC. 8616 NORTHWEST PLAZA DRIVE, DALLAS, TEXAS 75225

DENNIS J. CHAVAN
72584
REGISTERED
PROFESSIONAL ENGINEER
TEXAS

Halff Associates, Inc.
ENGINEERS · ARCHITECTS · SCIENTISTS · PLANNERS · SURVEYORS
8616 NORTHWEST PLAZA DRIVE
DALLAS, TEXAS 75225
TELEPHONE (214) 739-0000
FAX (214) 739-0095

Project No:	AVO # 20079
Issued:	05 / 13 / 02

Revisions:

No.	Date	Description
1	05/13/02	INLET RELOCATION
2	5 / 20 / 2002	AS PER SITE CHANGES

Drawn by: DD

Checked by: DJC

Sheet Title

EROSION CONTROL PLAN

C1.1

Sheet Number