

EDI ARCHITECTS, INC.
 ARCHITECTURE PLANNING ENGINEERING INTERIOR DESIGN
 AMERICAN BANK TOWER
 SUITE 100
 DALLAS, TEXAS 75201
 512 / 488-8308

Old Town 7-11/Strip Center
 Addison, Texas
 Ben Pinnell


DATE:
 14 MAR 85

SHEET NO:
A1.2
 OF SHEETS
 JOB NO: 8431.00


JOB NO SHEET

JOB NO SHEET

JOB NO SHEET

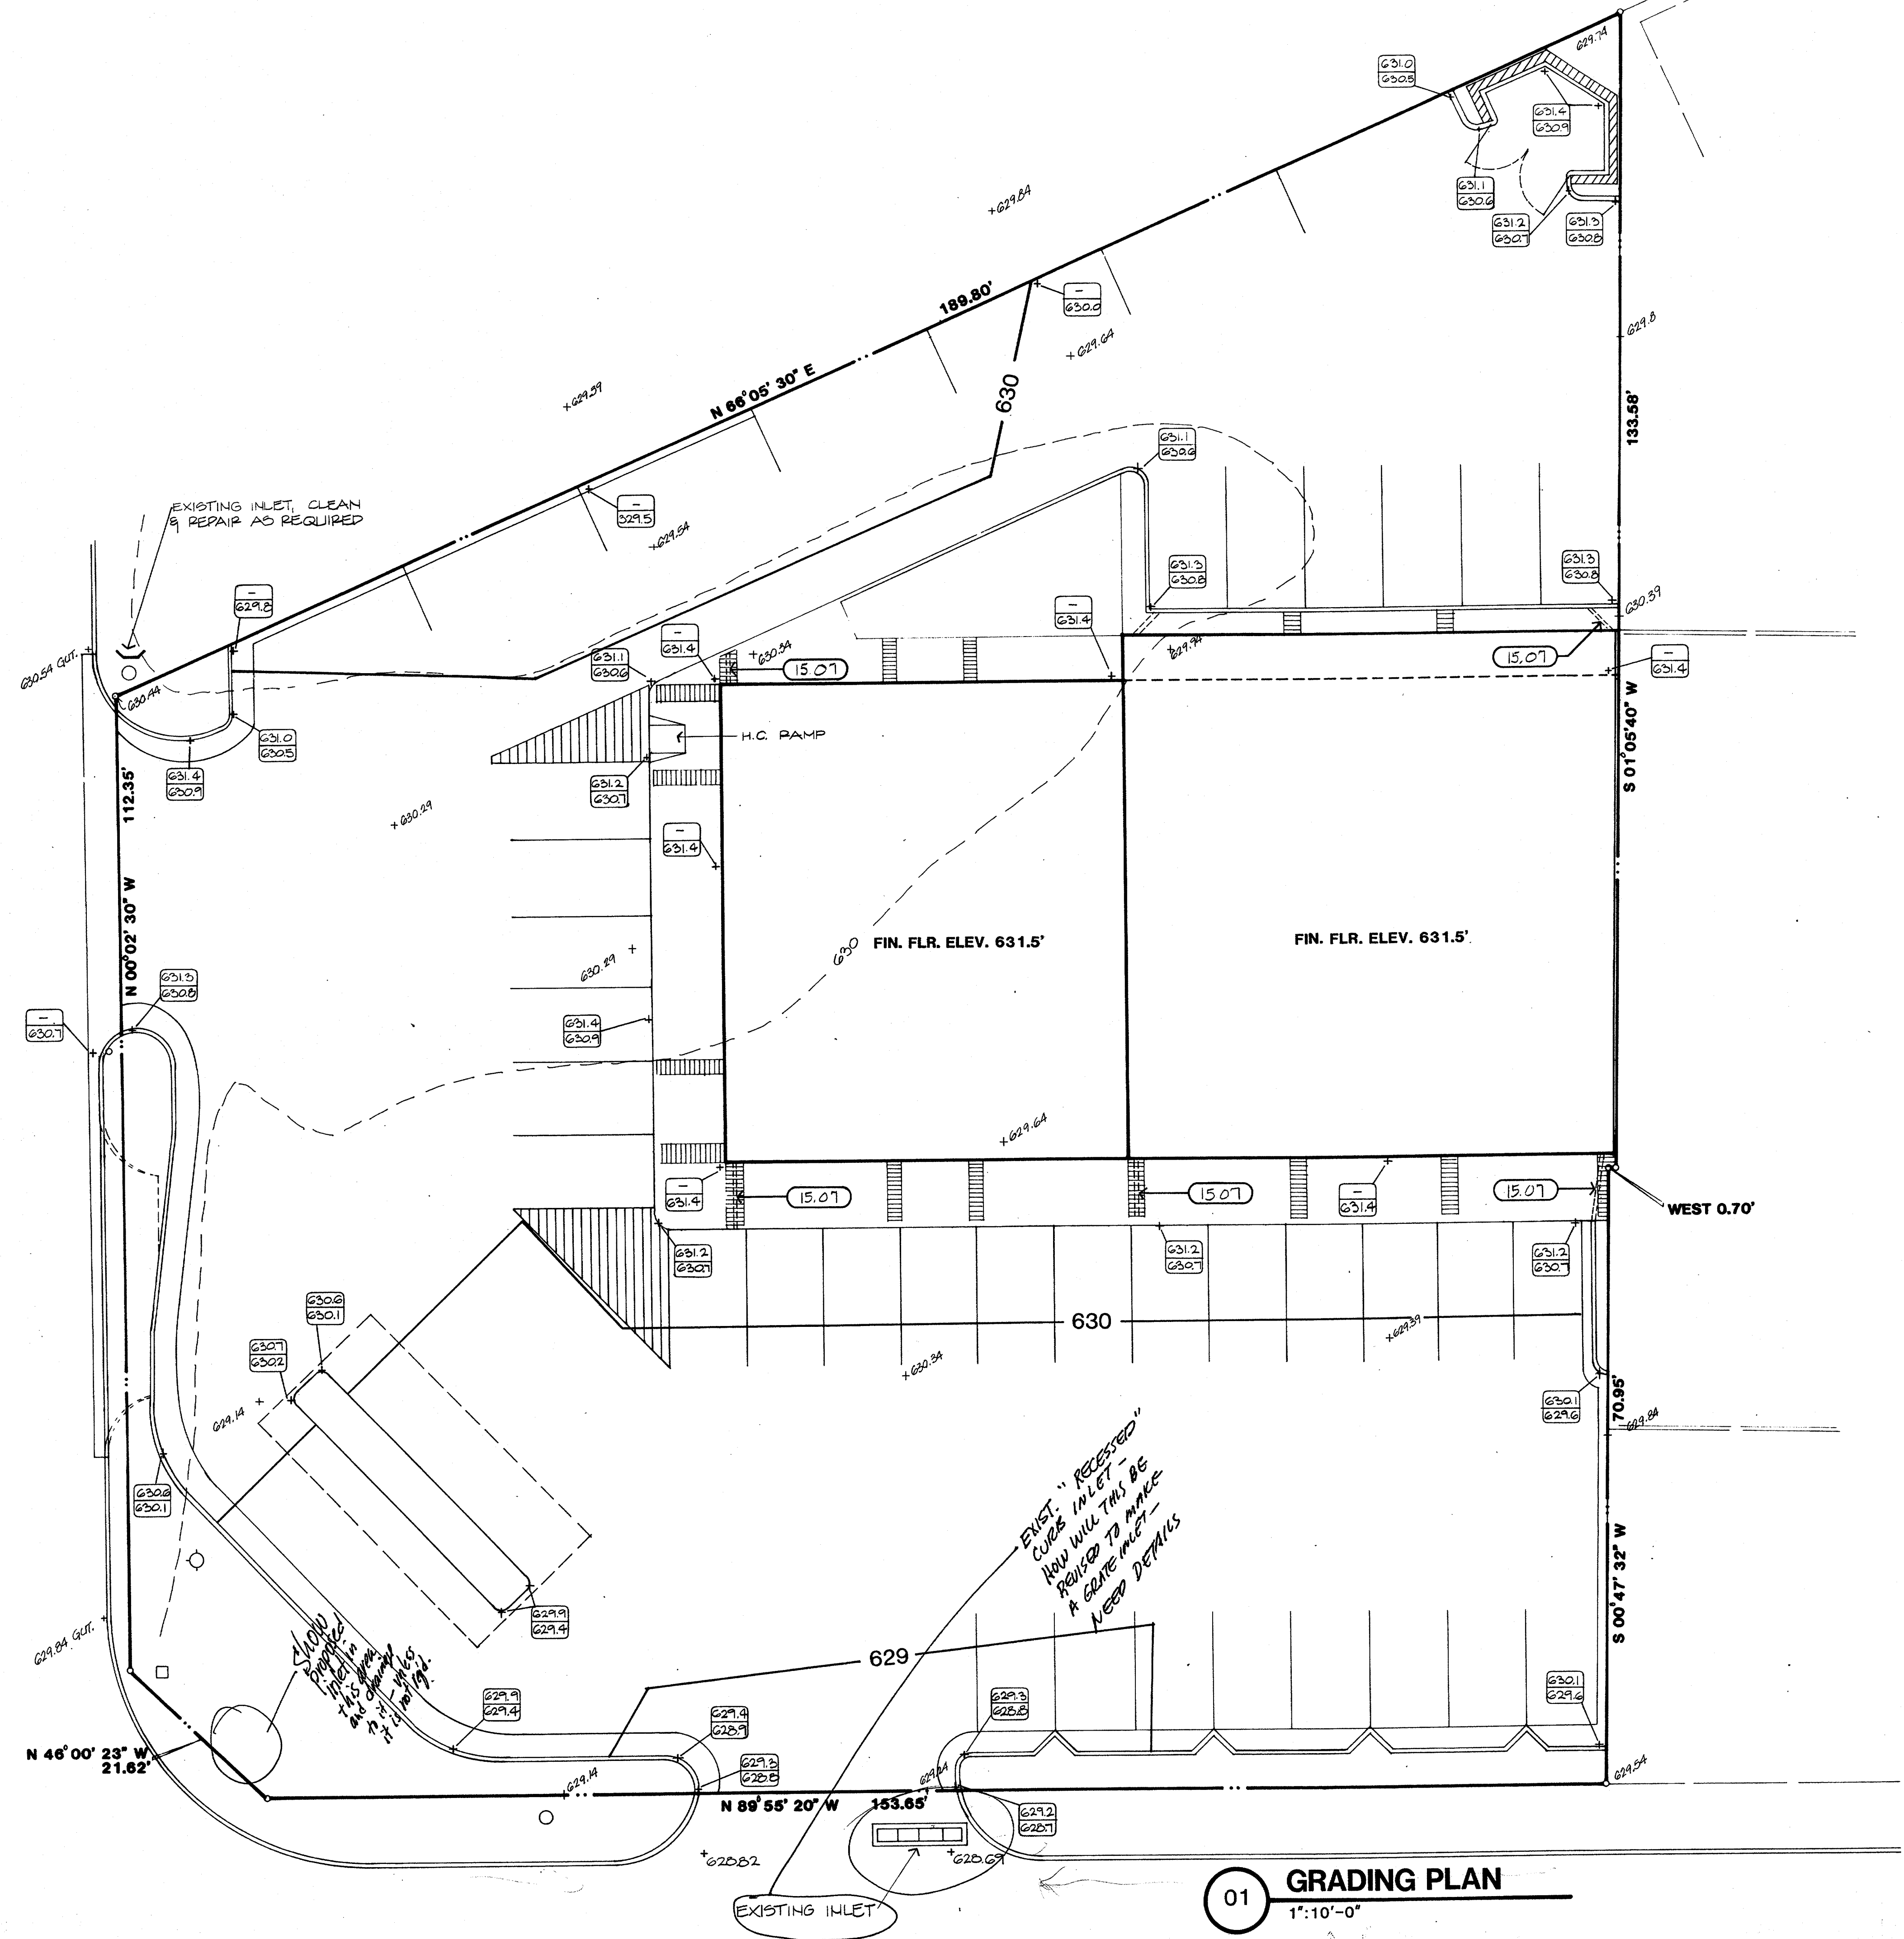

Legend
 [Symbol] - TOP OF CURB ELEVATION
 [Symbol] - BOTTOM OF CURB ELEVATION
 [Symbol] - SPOT ELEVATION

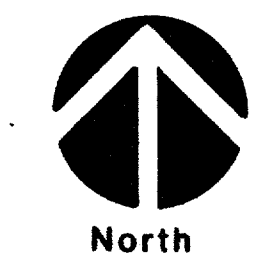

01 GRADING PLAN
 1"=10'-0"

ISSUED FOR PERMIT ONLY