


NOTES:

1. ALL PIPE WILL BE PVC CLASS 200 SDR 21 EXCEPT 1/2" WHICH WILL BE PVC CLASS 315 SDR 15.5.
2. ALL SLEEVES WILL BE PVC SCHEDULE 40 INSTALLED PRIOR TO PAVING BY IRRIGATION CONTRACTOR.
3. ALL SHRUB RISERS WILL BE 1/2" COPPER TYPE 'M'.
4. ONLY ONE ELECTRIC VALVE TO BE OPERATED AT ANY TIME.
5. IRRIGATION CONTRACTOR TO ADJUST RADIUS OF HEADS AS SHOWN.
6. THIS SYSTEM IS DESIGNED TO OPERATE ON A MINIMUM 45 P.S.I. WATER PRESSURE.
7. ALL HEADS ARE TORO WITH 12' NOZZLES UNLESS NOTED.
8. ALL ELECTRIC VALVES ARE "IRRI-TROL" ALL BRASS.

1. PROVIDE ELEVATION OF CANOPY SHOWING FIXED LIGHTING FIXTURES. - THEY MUST BE MIN 12' ABOVE GRADE UNLESS THEY ARE THE TOTALLY ENCLOSED TYPE.
2. PROVIDE PLAN VIEW OF ALL ELECTRICAL CONDUITS WITHIN A 20' RADIUS OF GAS PUMPS. THIS ALSO INCLUDES ALL LOW VOLTAGE WIRING AND PARKING LOT LIGHTS.

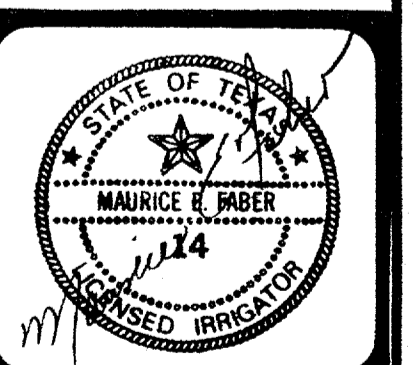


LEGEND		
● TORO 570P POP-UP SPRAY	⊗	N/A
○ TORO 570S SHRUB HEAD	⊗	N/A
○ TORO 570HP POP-UP SPRAY	△	N/A
⊕ IRRI-TROL ELECTRIC VALVE	□	N/A
⊕ N/A	—	PVC PIPE
⊕ N/A	—	PVC SCH. 40 SLEEVE
⊕ N/A	—	N/A
⊕ FEB20 1" #805 DOUBLE CHECK GATE VALVE ASSY	⊕	IRRI-TROL MC4 P-1 CONTROL

01 IRRIGATION PLAN
SCALE 1" = 10'-0"



ISSUED FOR PERMIT ONLY

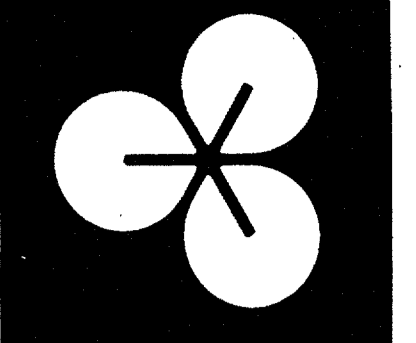

EDI ARCHITECTS, INC.
ARCHITECTURE PLANNING ENGINEERING INTERIOR DESIGN
AMERICAN BANK TOWER
SUITE 300
8640 WALNUT HILL LANE
DALLAS, TEXAS 75201
512 / 488-6505
512 / 750-1845

Old Town 7-11/Strip Center
Addison, Texas
Ben Pinnell

DATE: 14 MAR 85

SHEET NO:
A16
OF SHEETS
JOB NO. 8431.00