



C:\cadd\9401\0212\ASIT\add\10001.dwg
02 MAR 98
DART.TBL
\$(USER)

DWG No. C-9700-013

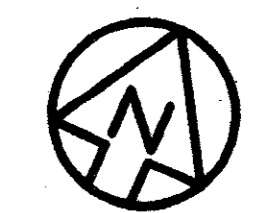

SCALE (IN FEET)
0 20 40 80

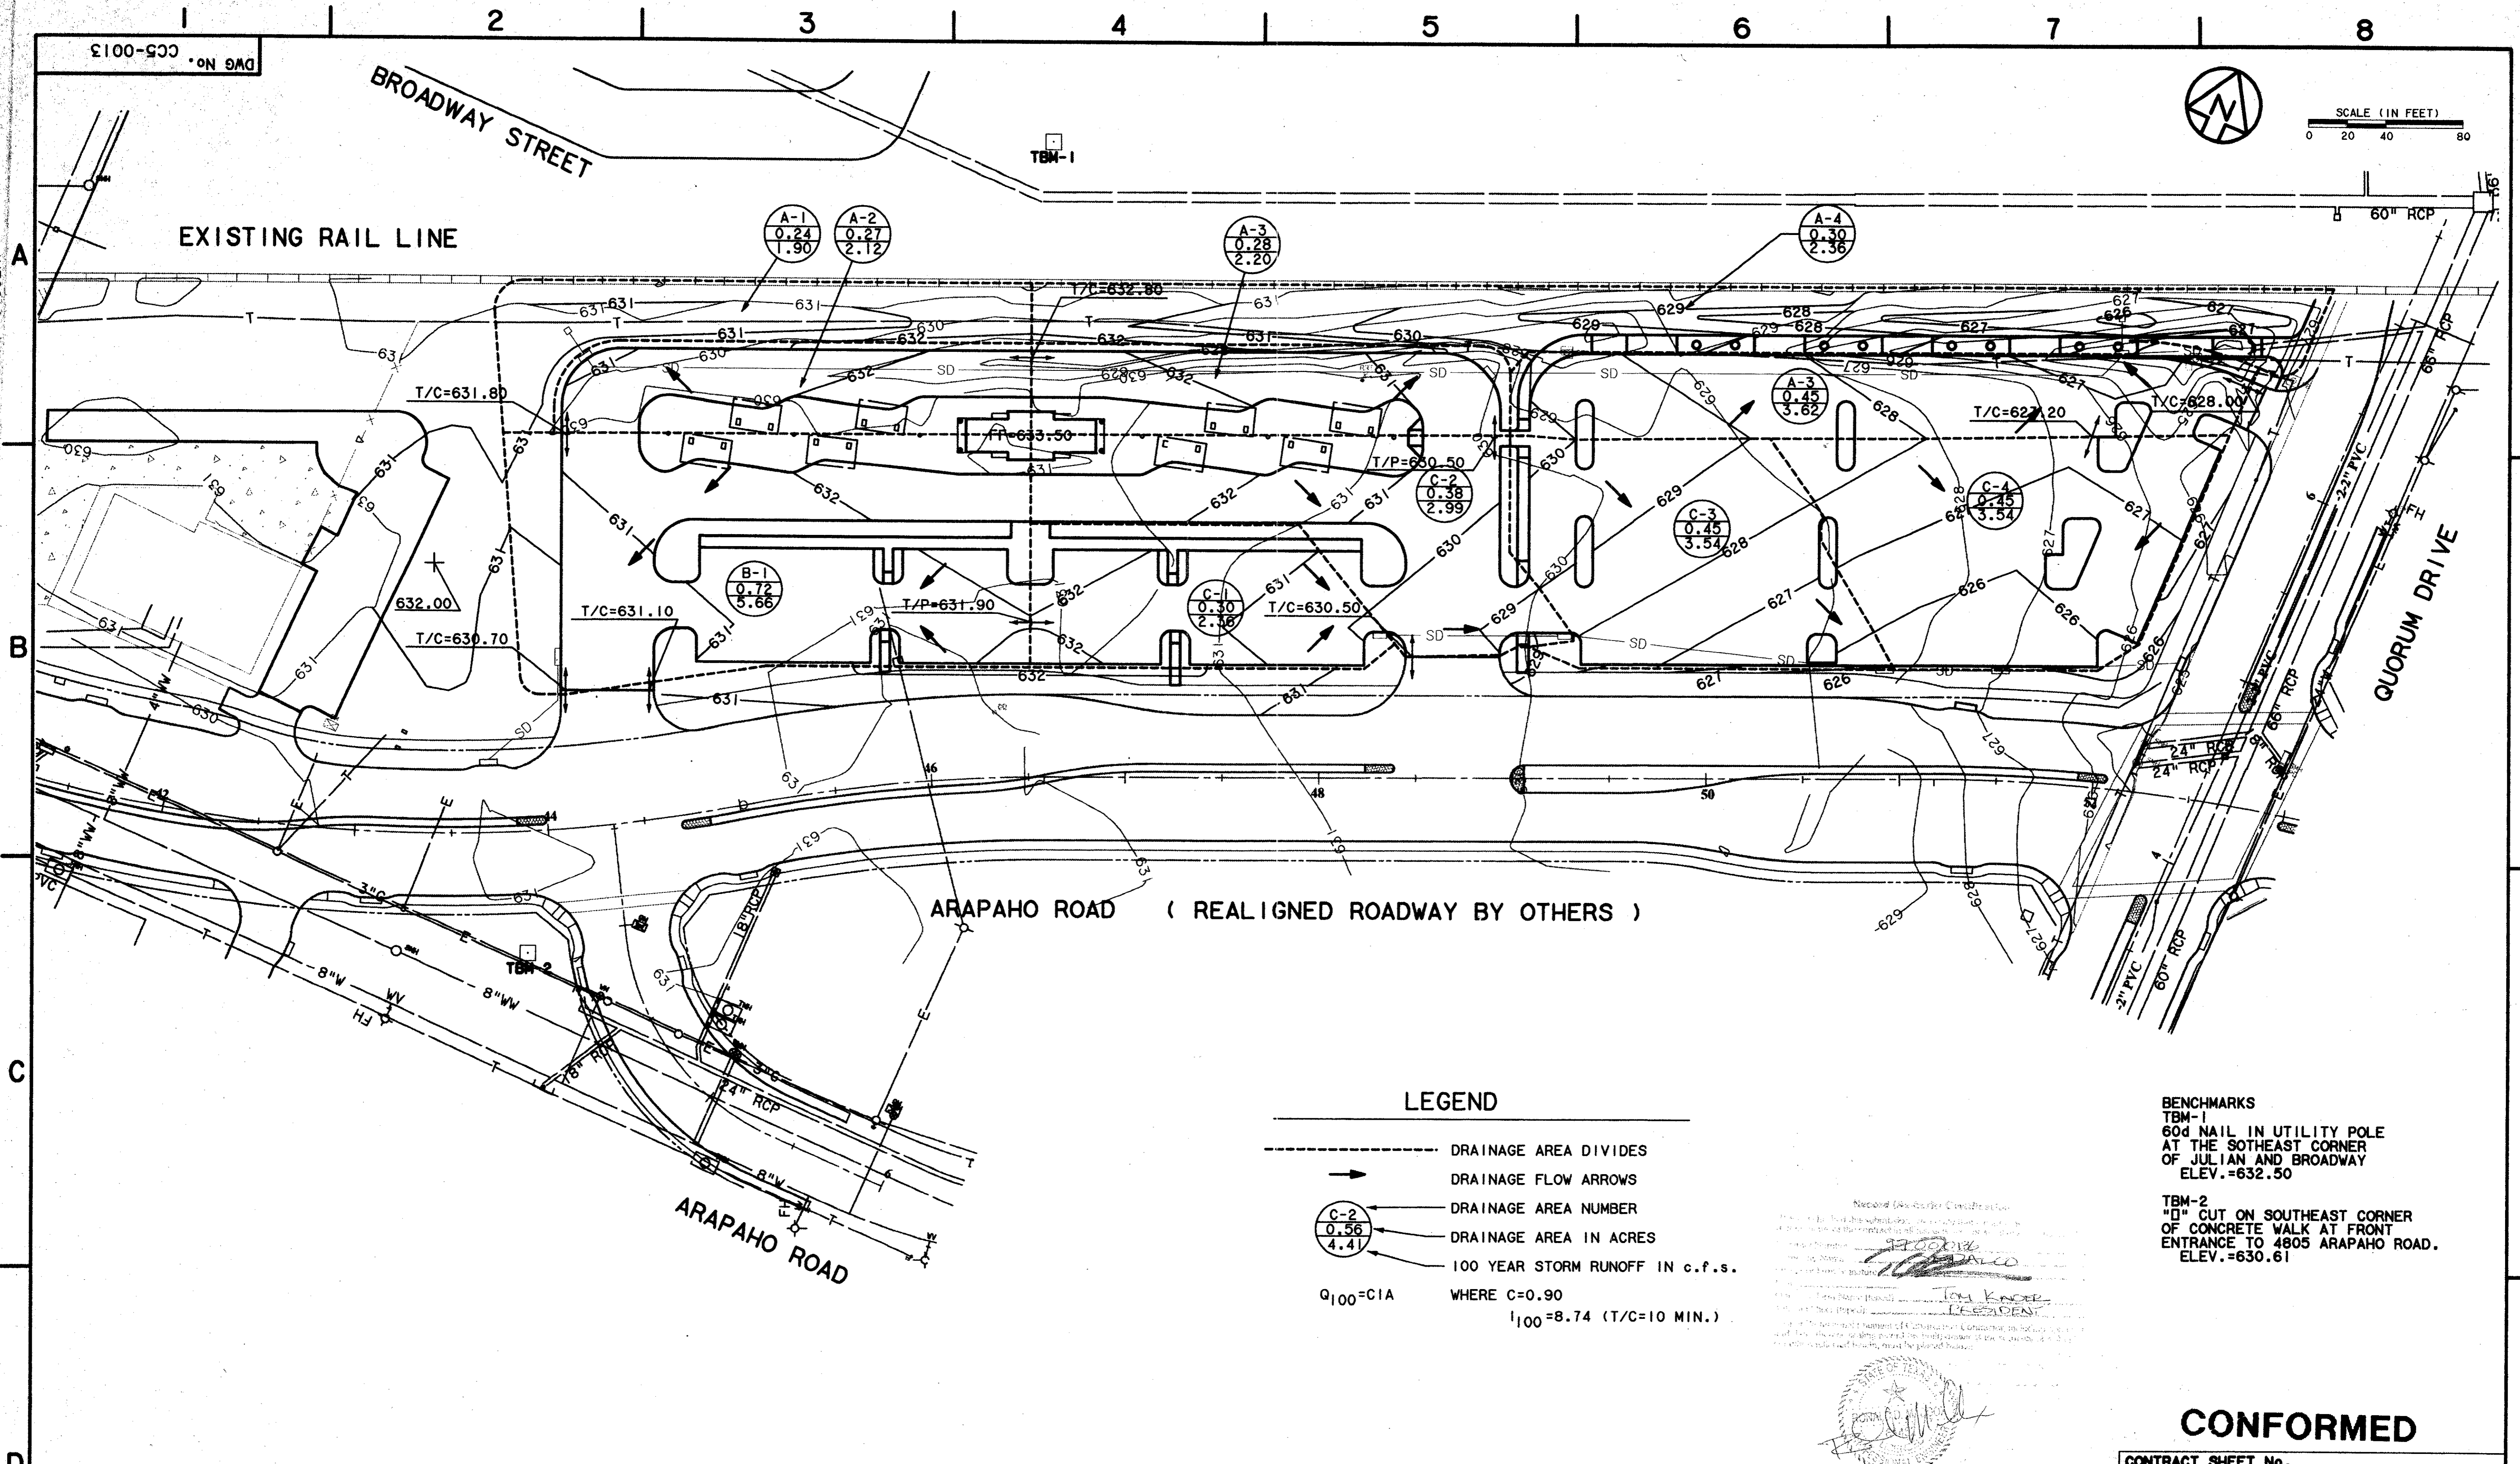

LEGEND

- DRAINAGE AREA DIVIDES
 - DRAINAGE FLOW ARROWS
 - DRAINAGE AREA NUMBER
 - DRAINAGE AREA IN ACRES
 - 100 YEAR STORM RUNOFF IN c.f.s.
- $Q_{100} = CIA$ WHERE $C = 0.90$
 $I_{100} = 8.74$ (T/C = 10 MIN.)

BENCHMARKS
TBM-1
60d NAIL IN UTILITY POLE
AT THE SOUTHEAST CORNER
OF JULIAN AND BROADWAY
ELEV. = 632.50


TBM-2
"I" CUT ON SOUTHEAST CORNER
OF CONCRETE WALK AT FRONT
ENTRANCE TO 4805 ARAPAHO ROAD.
ELEV. = 630.61

Tom Kruciak
DESIGNER

CONFORMED

CONTRACT SHEET No. 16 OF 95

REV	DATE	DESCRIPTION	BY	ENG	CHK	APP	REV	DATE	DESCRIPTION	BY	ENG	CHK	APP

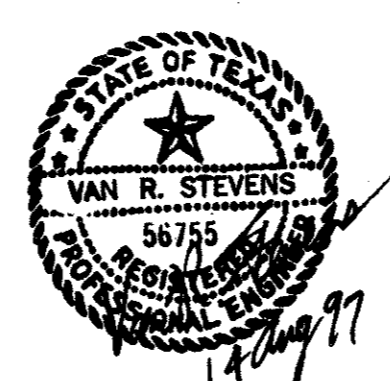

WENDY LOPEZ & ASSOC.
LOCKWOOD, ANDREWS & NEWMAN
THE SWA GROUP
GERARD & ASSOCIATES
ZAXON



WENDY LOPEZ & ASSOCIATES, INC.
ENGINEERING • SURVEYING • CONSTRUCTION SERVICES
1825 MARKET CENTER BLVD - SUITE 50
DALLAS, TEXAS 75207
(214) 746-7777

DART PROJECT



SCALE 1"=40'
DRAWN D. KRUCIAK
DESIGNED P. ZHAO
CHECKED V. STEVENS
IN CHARGE V. STEVENS
DATE AUG. 14, 1997

**ADDISON
TRANSIT CENTER
DRAINAGE AREA MAP**



CONTRACT C-97000136 DWG No. C-9700136 REV 0