$$$$DGN$$SPECIFICATION$$$$$$$$$$
$$$$$$STYTIME$$$$$$
$$PRF$$
$$USERNAME$$
$$PRF ROT$$
$$PEN$$
$$FILE6$$
$$FILE7$$
$$FILE8$$
$$FILE9$$
$$FILE10$$
$$FILE1$$
$$FILE2$$
$$FILE3$$
$$FILE4$$
$$FILE5$$

DWG No. CC5-0006

NOTE:
ALL SPOT ELEVATIONS SHOWN ARE TOP OF CURB TYPICAL, UNLESS OTHERWISE NOTED.

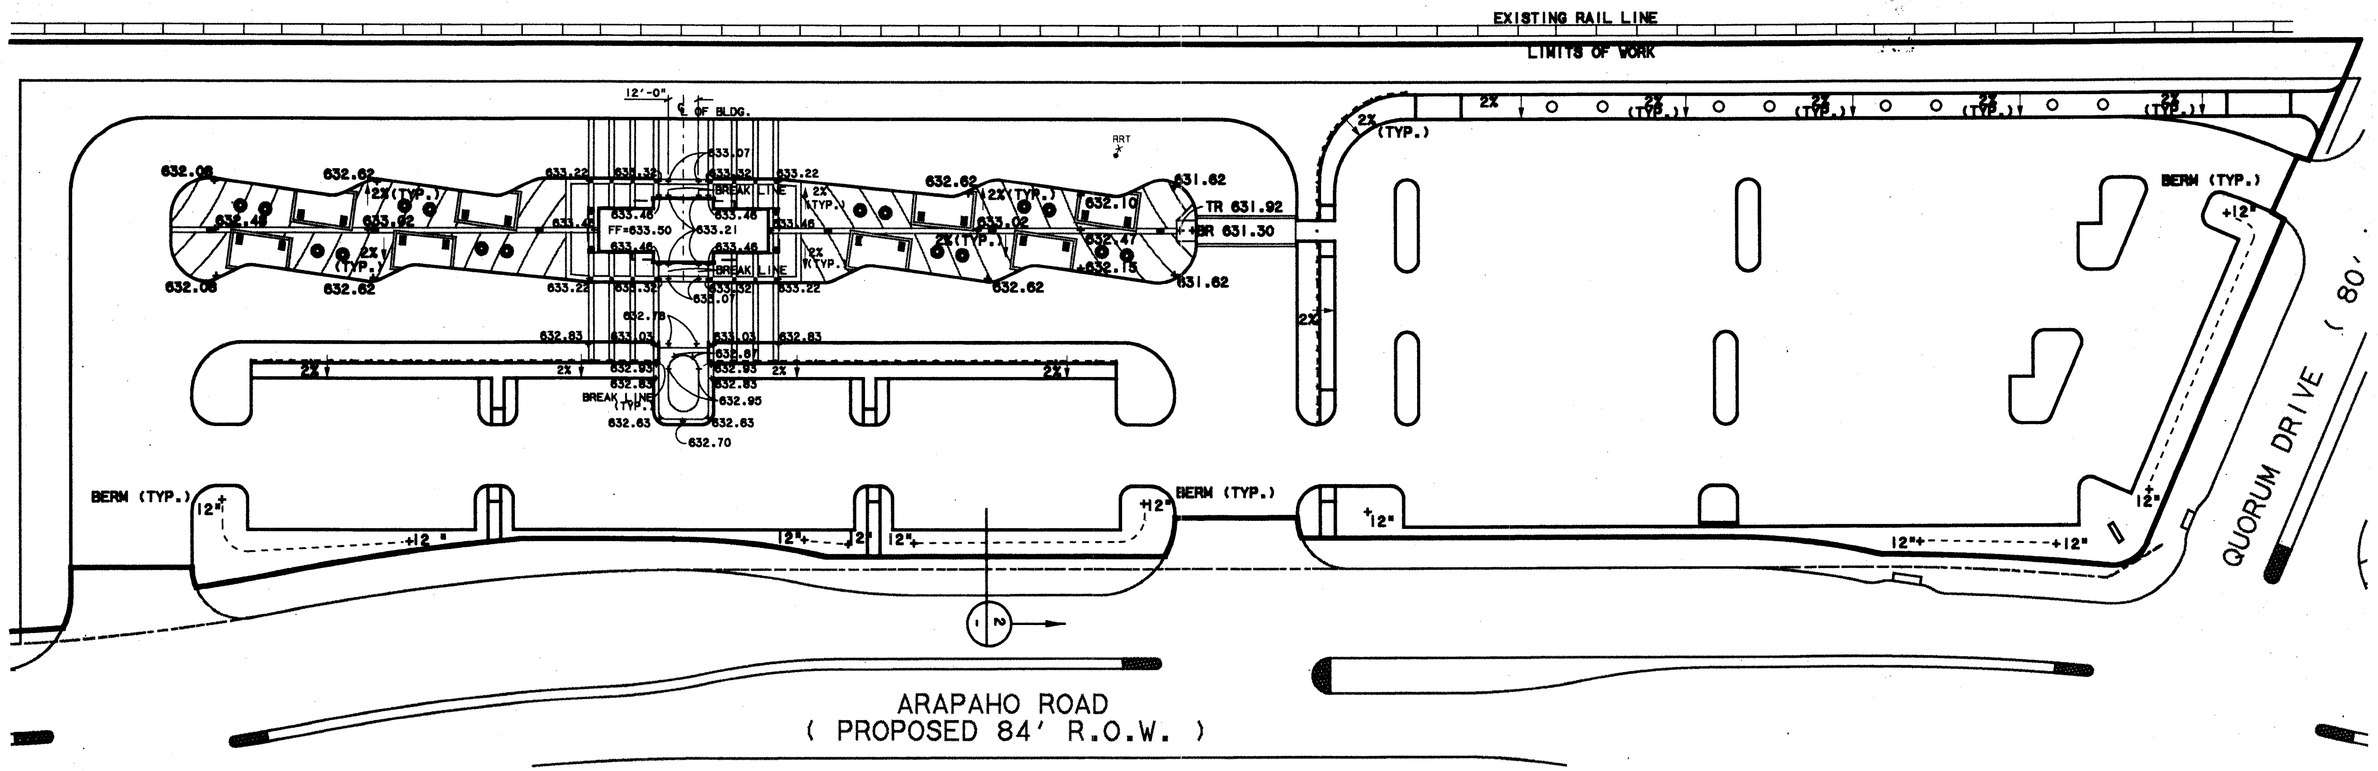

FINE GRADING PLAN (1)
SCALE: 1"=30'-0"

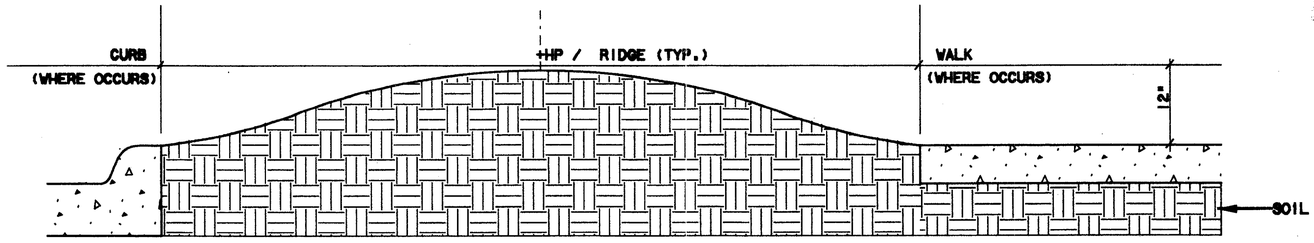

BERM SECTION - TYPICAL (2)
SCALE: 1"=1'-0"

Record Drawing Certification
97000136
TOM KADER
PRESIDENT
7-7-99

CONFORMED

CONTRACT SHEET No. 39 OF 95

REV	DATE	DESCRIPTION	BY	ENG	CHK	APP
0	8-7-97	ISSUED FOR CONSTRUCTION				

CHRISTOPHER MILLER — REGISTERED LANDSCAPE ARCHITECT — 3-7-96

SWA Group
2211 North Lamar
Dallas
Texas, 75202
214-954-0016
Landscape Architecture
Site Planning
Urban Design

WENDY LOPEZ & ASSOCIATES, INC.
ENGINEERING • SURVEYING • CONSTRUCTION SERVICES
1825 MARKET CENTER BLVD - SUITE 510
DALLAS, TEXAS 75207
(214) 748-7777

DART PROJECT

SCALE	1"=30'-0"
DRAWN	N. AMETON
DESIGNED	C. MILLER
CHECKED	C. MILLER
IN CHARGE	V. STEVENS
DATE	14 AUGUST 97

CAES

CONTRACT C-97000136

DWG No. CC5-0006

REV 0

ADDISON TRANSIT CENTER
FINE GRADING PLAN