DWG No. CC5-0009

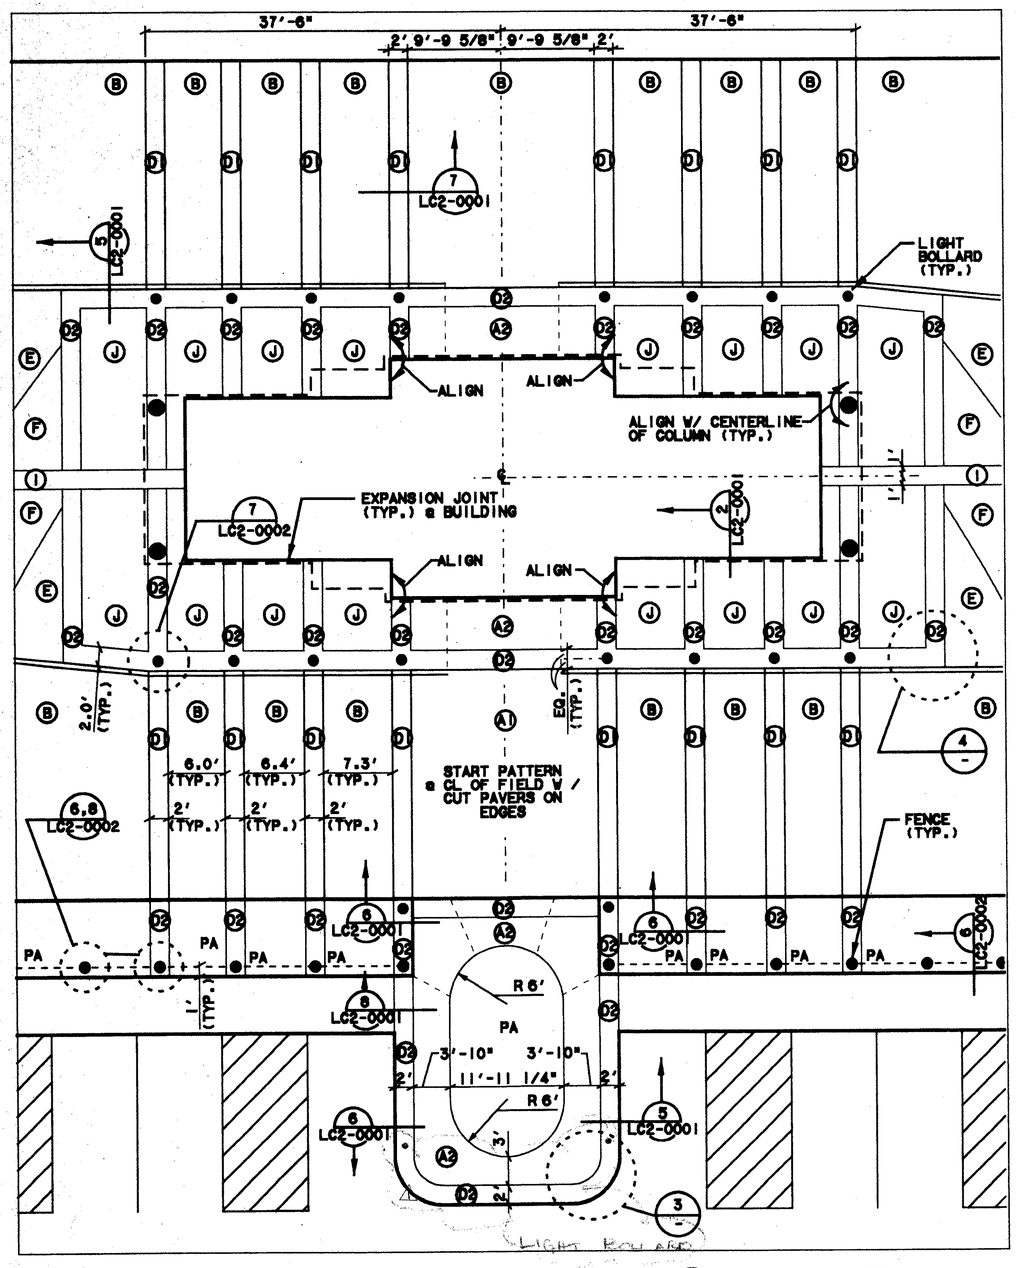

PLATFORM ENLARGEMENT PLAN B (2) CC5-0007 CC5-0008

SCALE: 1/8"=1'-0"

NOTE: PA = PLANTING AREA

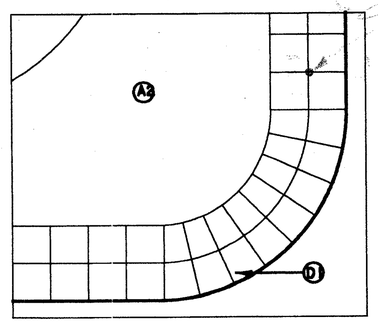

PAVING DETAIL (3) -

SCALE: 1/2"=1'-0"

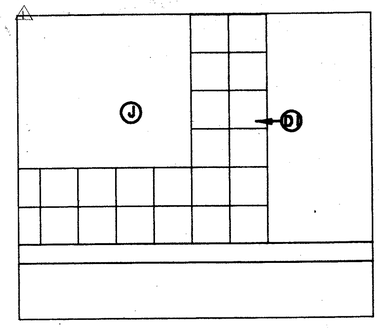

PAVING DETAIL (4) -

SCALE: 1/2"=1'-0"

PAVEMENT TYPES:

A TYPES - 12"X12" PAVER, COLOR - 'TERRA COTTA'

- (A1) - TYPE 1 - 8 CM AT ALL ROADWAY PATTERNS
- (A2) - TYPE 2 - 6 CM AT ALL OTHER PATTERNS
- (B) - MEDIUM BROOM FINISH CONCRETE, COLOR STD. GREY
- (C) - TYPE 3 - 6"X12"X6 CM PAVER, COLOR 'LIMESTONE' (ACID WASHED)

D TYPES - 12"X12" PAVER, COLOR 'LIMESTONE' (ACID WASHED)

- (D1) - TYPE 4 - 8 CM AT ALL ROADWAY PATTERNS
- (D2) - TYPE 5 - 6 CM AT ALL OTHER PATTERNS
- (E) - TYPE 6 - 4"X8"X6 CM PAVER, COLOR 'APRICOT' (QUARTEX FINISH, ACID WASHED)
- (F) - TYPE 7 - 4"X8"X6 CM PAVER, COLOR 'SAND' (QUARTEX FINISH, ACID WASHED)
- (G) - MEDIUM SANDBLAST FINISH CONC. - COLOR STD. GREY
- (H) - LIGHT BROOM FINISH CONC. - COLOR STD. GREY
- (I) - TYPE 8 - 12"X12"X6 CM PAVER, COLOR 'OBSIDIAN' (QUARTEX FINISH, ACID WASHED)
- (J) - TYPE 9 - 4"X8"X6 CM PAVER, COLOR 'LIMESTONE' (ACID WASHED)

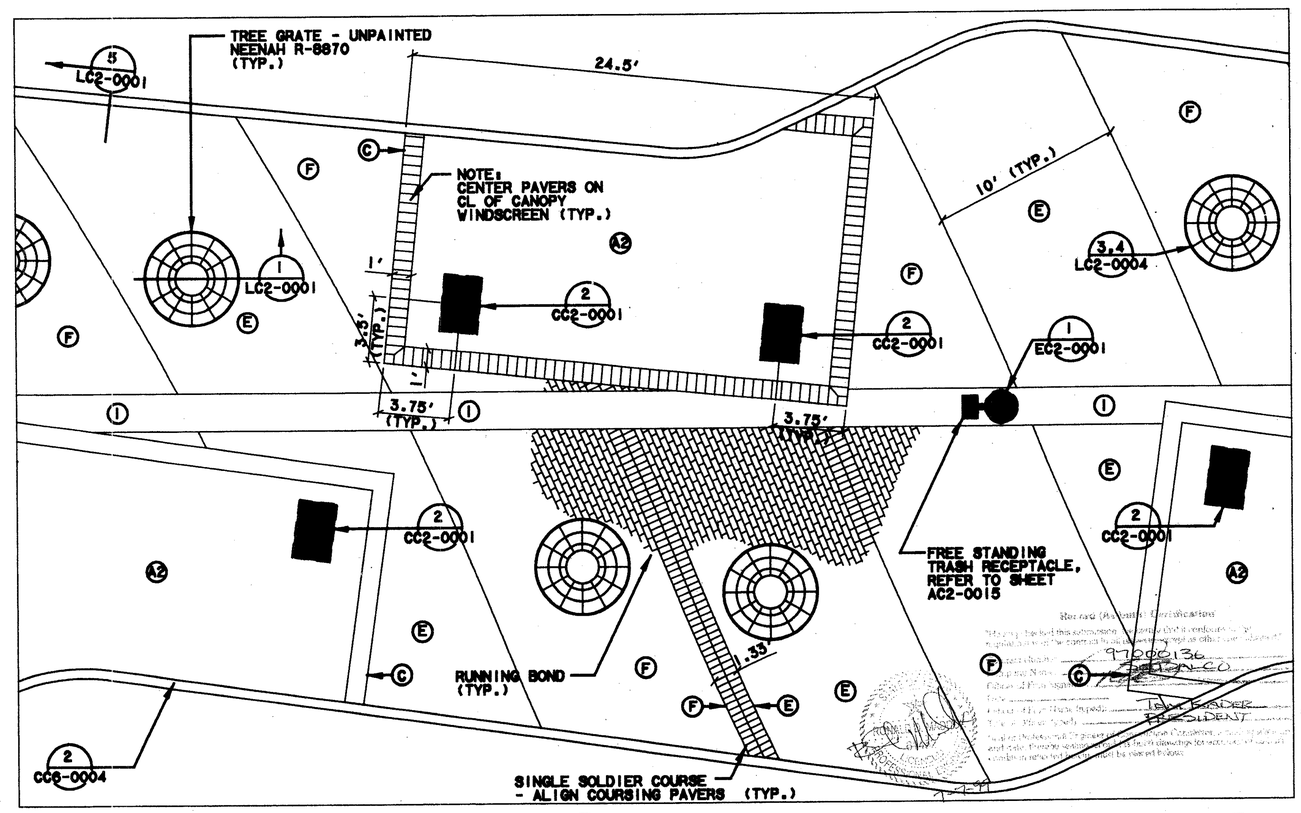

PLATFORM ENLARGEMENT PLAN A (1) CC5-0007 CC5-0008

SCALE: 1/4"=1'-0"

NOTE: TRASH RECEPTACLE TO BE LOCATED ADJACENT TO EACH PLATFORM LIGHT POLE. SPECIFIC LOCATION TO BE DETERMINED BY CONTRACTING OFFICER.

CONFORMED

CONTRACT SHEET No. 42 OF 95

REV	DATE	DESCRIPTION	BY	ENG	CHK	APP
△	8/30/99	RECORD AS BUILT SUBMITTAL		RDM		JLM

STATE OF TEXAS — CHRISTOPHER G. MILLER — REGISTERED LANDSCAPE ARCHITECT

SWA Group
2211 North Lamar, Dallas, Texas, 75202, 214-954-0016
Landscape Architecture, Site Planning, Urban Design

WLA
WENDY LOPEZ & ASSOCIATES, INC.
ENGINEERING • SURVEYING • CONSTRUCTION SERVICES
1825 MARKET CENTER BLVD - SUITE 510
DALLAS, TEXAS 75207
(214) 742-7777

DART PROJECT

SCALE	AS NOTED
DRAWN	N. AVETON
DESIGNED	C. MILLER
CHECKED	C. MILLER
IN CHARGE	V. STEVENS
DATE	14 AUGUST 97

CAES

ADDISON TRANSIT CENTER

HARDSCAPE ENLARGEMENT

CONTRACT C-97000136 | DWG No. CC5-0009 | REV 01