$$$$DGN$SPECIFICATION$$$$$$$$$$
$$$$$$SYTIME$$$$$$
$$PRF$$
$$USERNAME$$
$$PRF ROT$$
$$PEN$$
$$FILE6$$
$$FILE7$$
$$FILE8$$
$$FILE9$$
$$FILE10$$
$$FILE1$$
$$FILE2$$
$$FILE3$$
$$FILE4$$
$$FILE5$$

DWG No. LC2-0003

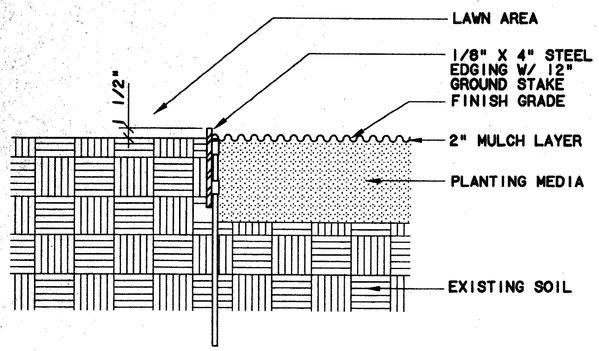

STEEL EDGING - SECTION 6
N.T.S.

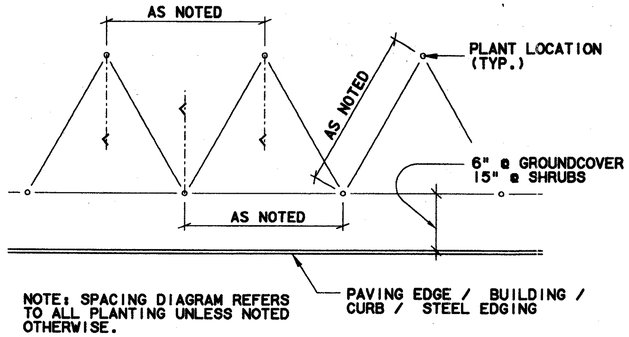

TRIANGULAR SPACING - PLAN 5
N.T.S.

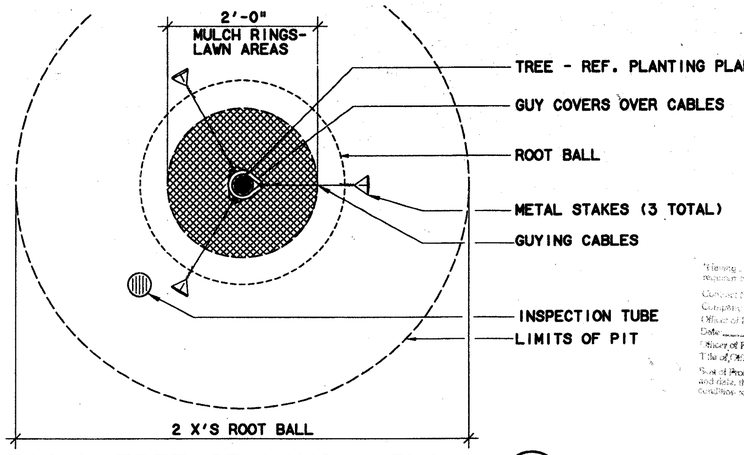

TYPICAL TREE STAKING - PLAN 3
N.T.S.

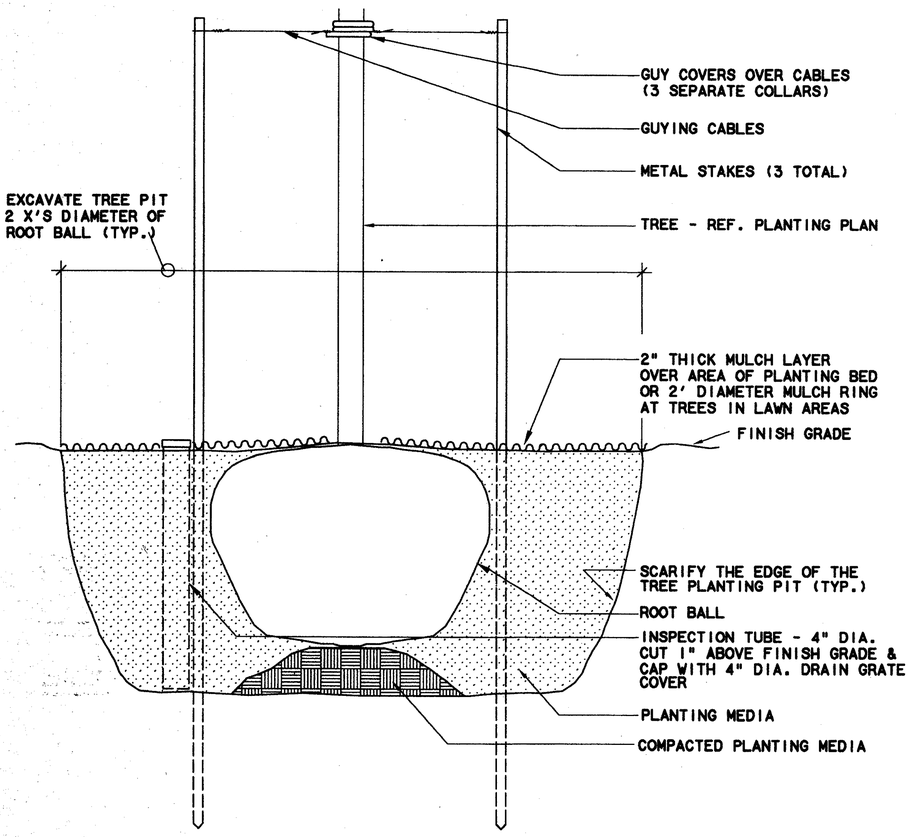

TREE STAKING @ LAWN - SECTION 7
N.T.S.

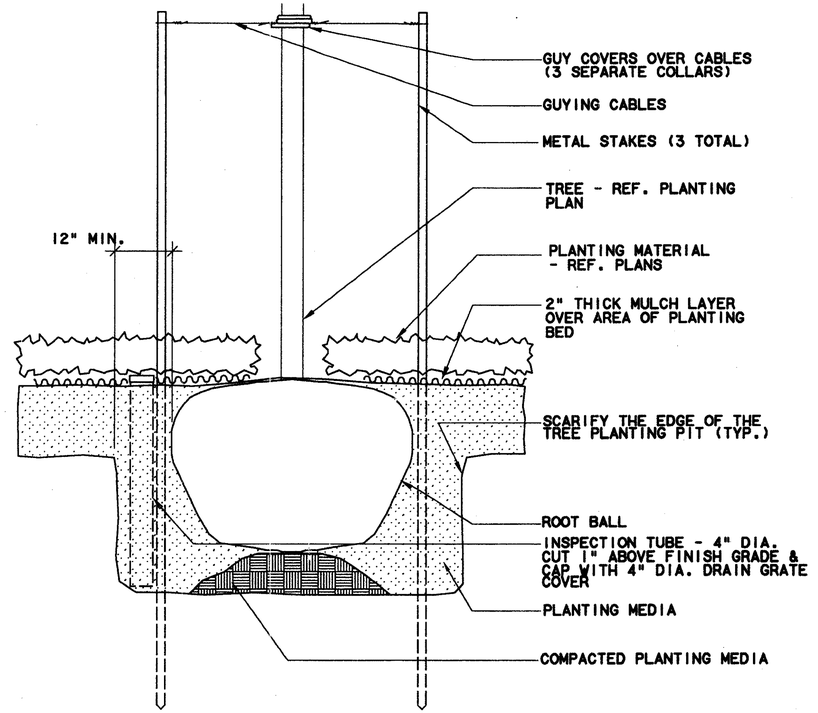

TREE STAKING @ PLANTER - SECTION 4
N.T.S.

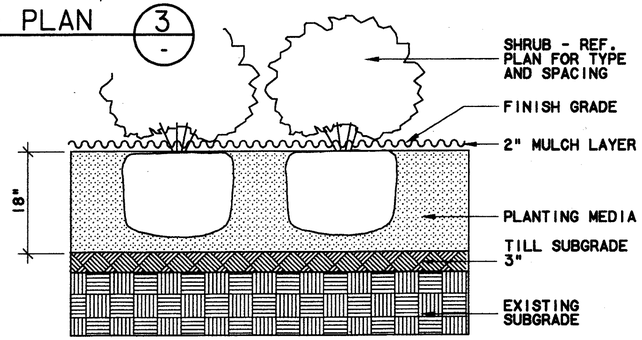

SHRUB PLANTING - SECTION 1
N.T.S.

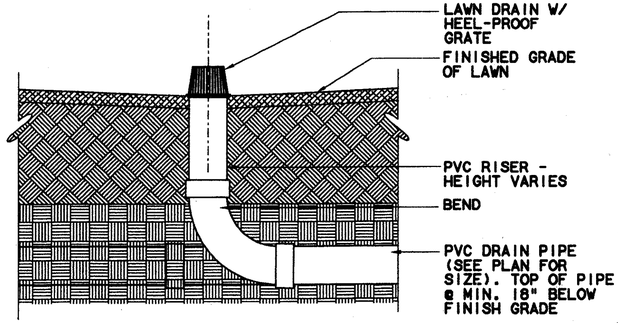

PLANTER DRAIN - SECTION 2
N.T.S.

STATE OF TEXAS RONALD D. HARRELL 61494 REGISTERED LANDSCAPE ARCHITECT 7-7-97

Record (Submittal) Certification
Contract No. C-97000136 DALCO
Date
Name of Firm/Name of Officer (printed) TOM KAPER
Title of Officer (printed) PRESIDENT
State of Professional Registration

CONFORMED

CONTRACT SHEET No. 49 OF 95

REV	DATE	DESCRIPTION	BY	ENG	CHK	APP
1						
2						
3						
4						
5						
6						

STATE OF TEXAS JAMES A. MASSEY 919 REGISTERED LANDSCAPE ARCHITECT 8/4/97

SWA Group
2221 North Lamar, Dallas, Texas 75202, 214-954-0016
Landscape Architecture, Site Planning, Urban Design

WLA
WENDY LOPEZ & ASSOCIATES, INC.
ENGINEERING • SURVEYING • CONSTRUCTION SERVICES
1825 MARKET CENTER BLVD – SUITE 510
DALLAS, TEXAS 75207
(214) 741-7777

DART PROJECT

DART

CAES

SCALE	AS NOTED
DRAWN	N. AVETON
DESIGNED	C. MILLER
CHECKED	C. MILLER
IN CHARGE	V. STEVENS
DATE	14 AUGUST 97

ADDISON TRANSIT CENTER
PLANTING DETAILS

CONTRACT C-97000136 | DWG No. LC2-0003 | REV 0