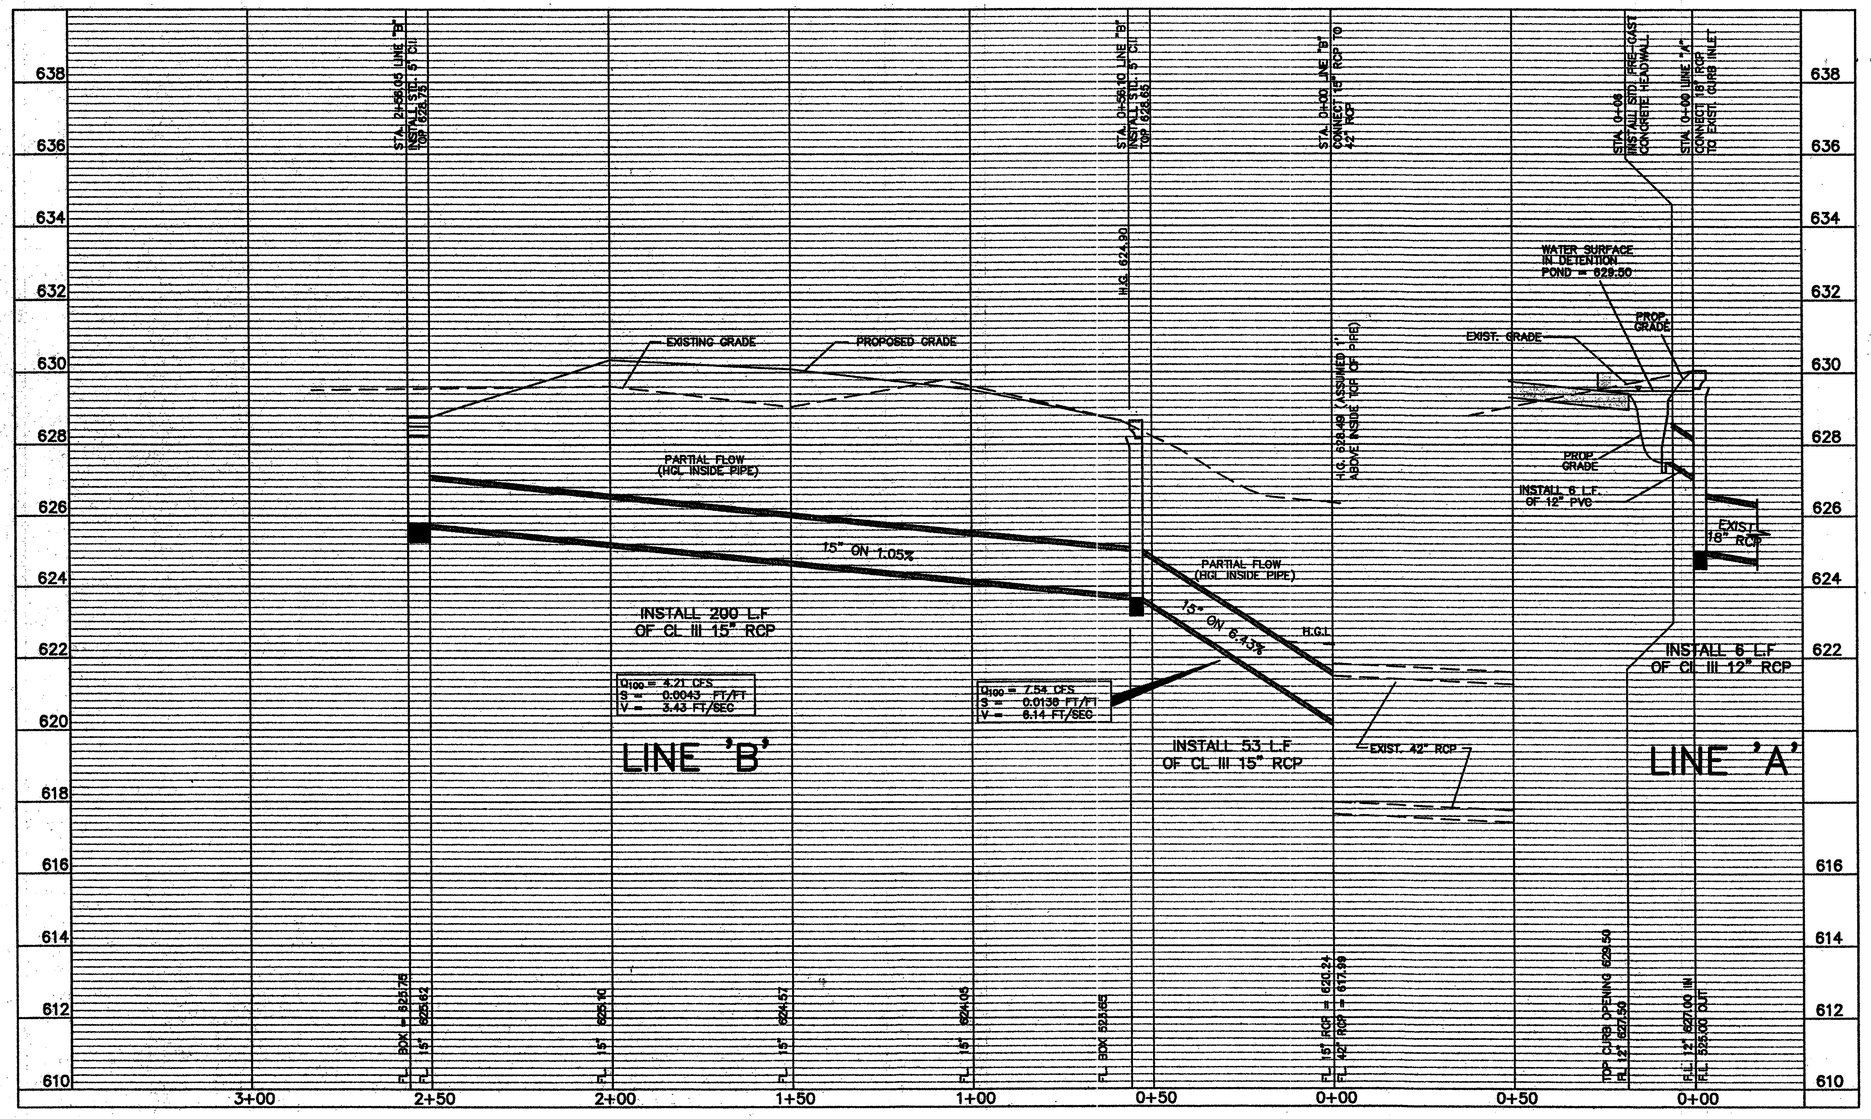

NOTES:

1. ALL CONSTRUCTION SHALL BE DONE IN STRICT CONFORMANCE TO THESE PLANS AND ALL APPLICABLE MUNICIPAL CODES AND STANDARDS.
2. SEE SHEET C2 FOR GRADING AND PAING PLAN.
3. SEE SHEET C3 FOR STORM DRAIN PLAN.
4. SEE SHEET C9 FOR ALL PAVING AND STORM DRAIN DETAILS.

BENCH MARK:

TOWN OF ADDISON BENCHMARK NO. 3
60D NAIL IN POWER POLE LOCATED AT
THE SOUTHEAST CORNER OF JULIAN STREET
AND BROADWAY STREET

ELEVATION = 632.50

JDJR ENGINEERS & CONSULTANTS, INC.
ENGINEERS • LAND PLANNERS • CAD DESIGNS
2600 Texas Drive Suite 100 Irving, Texas 75062
Tel. 972-252-JDJR (5357) Fax. 972-273-8600

STATE OF TEXAS
JAMES DEWEY, JR.
51-80
PROFESSIONAL ENGINEER

PROJECT: WINGATE INN

ARAPAHO ROAD AT QUORUM DRIVE
LOT 2 BLOCK "A"
WINGATE INN OF ADDISON ADDITION
ADDISON, TEXAS

REVISIONS:

DATE	REVISION

SHEET TITLE
STORM DRAIN PROFILES

DATE: 5-22-98
SCALE: 1" = 20'
DRAWN BY: J.N.M.
CHECKED BY: JDJR
SHEET NO.
C4 OF 9
JDJR FILE NO. 98-022