

ARAPAHO ROAD  
STREETSCAPE  
CITY-OF-ADDISON, TEXAS

Revisions

No.	Date	Item
△	03/10/98	CITY REVISIONS AS LISTED IN ADDENDUM NO. 5
—	05/18/98	ADDITION OF TREE DRAINS

Registration

STATE OF TEXAS  
WILLIAM T. ARTERBURN  
868  
REGISTERED LANDSCAPE ARCHITECT

KDH/RFM  
Drawn

Checked  
97018 12/12/97  
Project No. Date


Sheet Title

TREEWELL  
DRAINS/  
PLANTING  
PLAN

Sheet No.

PL-4

All median and parkway planting areas shall have 6 inches of topsoil placed prior to planting. The topsoil shall be tilled into the soil below a minimum of 4 inches deep. Backfill in the medians under the proposed topsoil shall consist of friable native material free of rocks and debris. The cost of topsoil and median backfill shall be subsidiary to the contract.

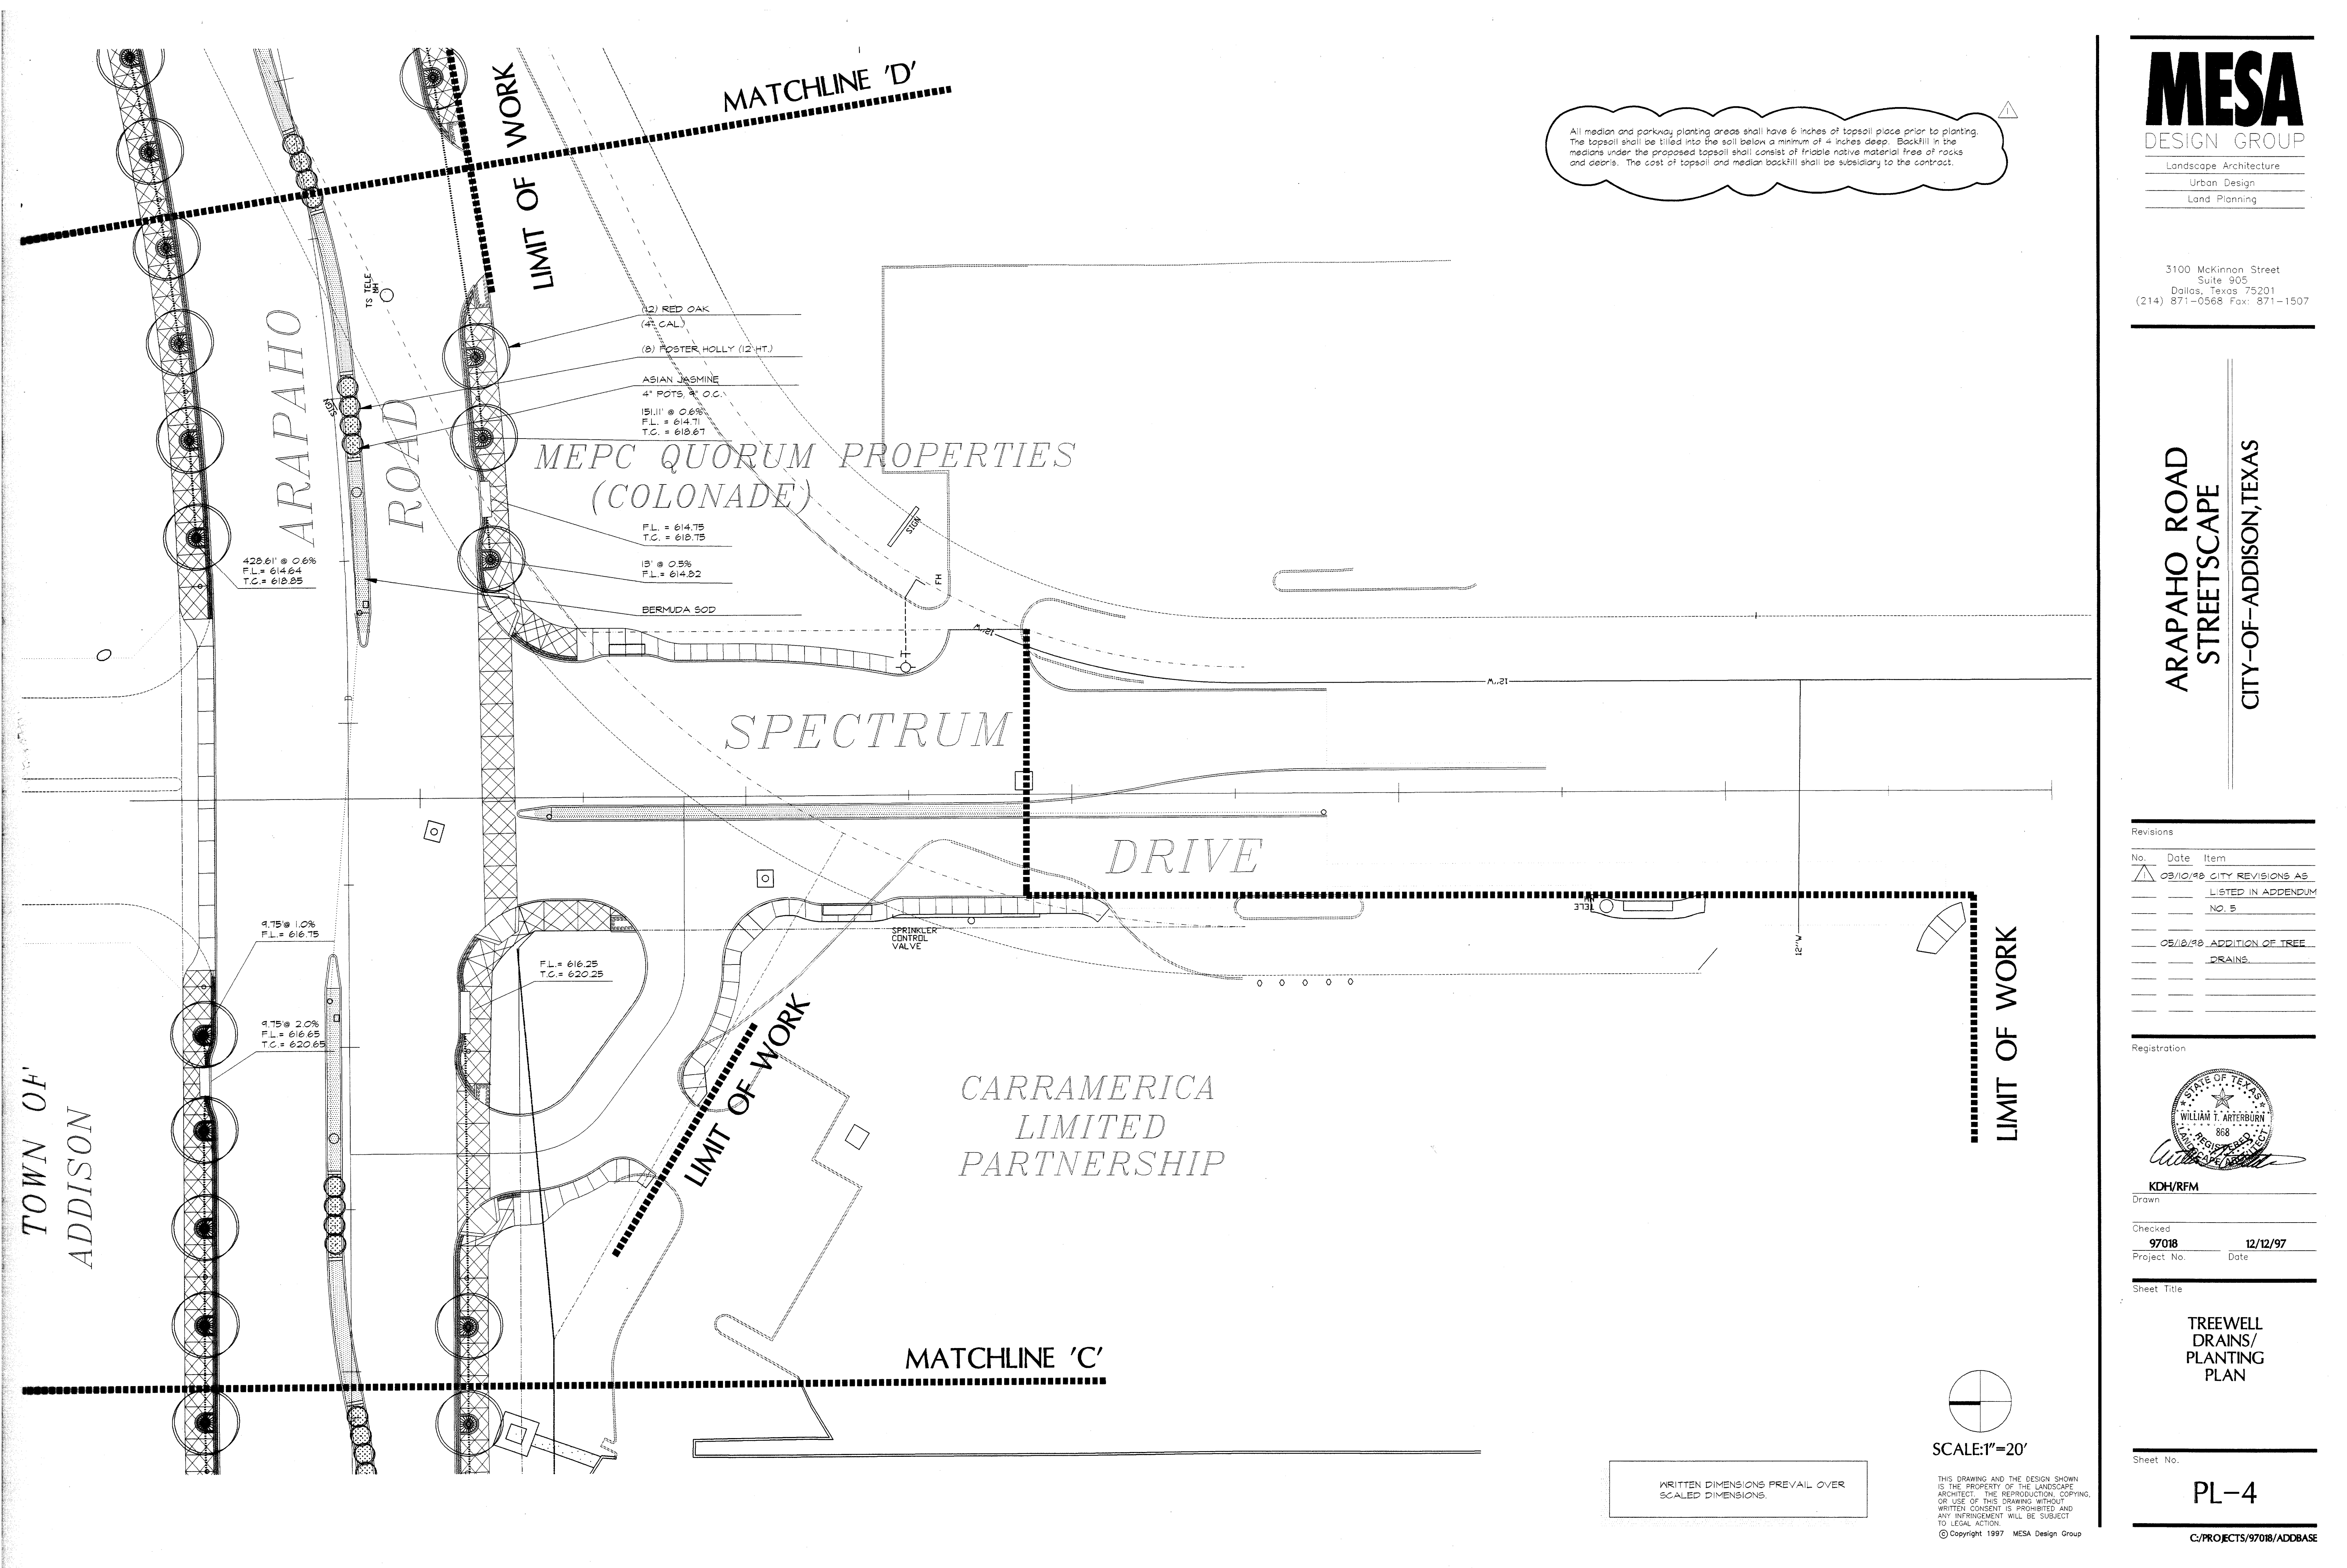

TOWN OF  
ADDISON

ARAPAHO  
ROAD

MEPC QUORUM PROPERTIES  
(COLONADE)

SPECTRUM  
DRIVE

CARRAMERICA  
LIMITED  
PARTNERSHIP

MATCHLINE 'C'

MATCHLINE 'D'

LIMIT OF WORK

LIMIT OF WORK

LIMIT OF WORK

428.61' @ 0.6%  
F.L. = 614.64  
T.C. = 618.85

4.75' @ 1.0%  
F.L. = 616.75

4.75' @ 2.0%  
F.L. = 616.65  
T.C. = 620.65

(2) RED OAK  
(4" CAL.)  
(8) FOSTER HOLLY (12' HT.)  
ASIAN JASMINE  
4" POTS @ O.C.  
15' @ 0.6%  
F.L. = 614.71  
T.C. = 618.67

F.L. = 614.75  
T.C. = 618.75


13' @ 0.5%  
F.L. = 614.52

BERMUDA SOD

F.L. = 616.25  
T.C. = 620.25

SPRINKLER  
CONTROL  
VALVE

WRITTEN DIMENSIONS PREVAIL OVER  
SCALED DIMENSIONS.

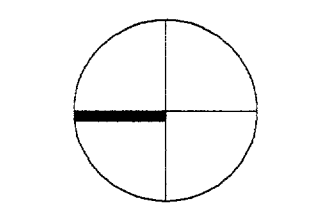

SCALE: 1"=20'

THIS DRAWING AND THE DESIGN SHOWN IS THE PROPERTY OF THE LANDSCAPE ARCHITECT. THE REPRODUCTION, COPYING, OR USE OF THIS DRAWING WITHOUT WRITTEN CONSENT IS PROHIBITED AND ANY INFRINGEMENT WILL BE SUBJECT TO LEGAL ACTION.  
© Copyright 1997 MESA Design Group