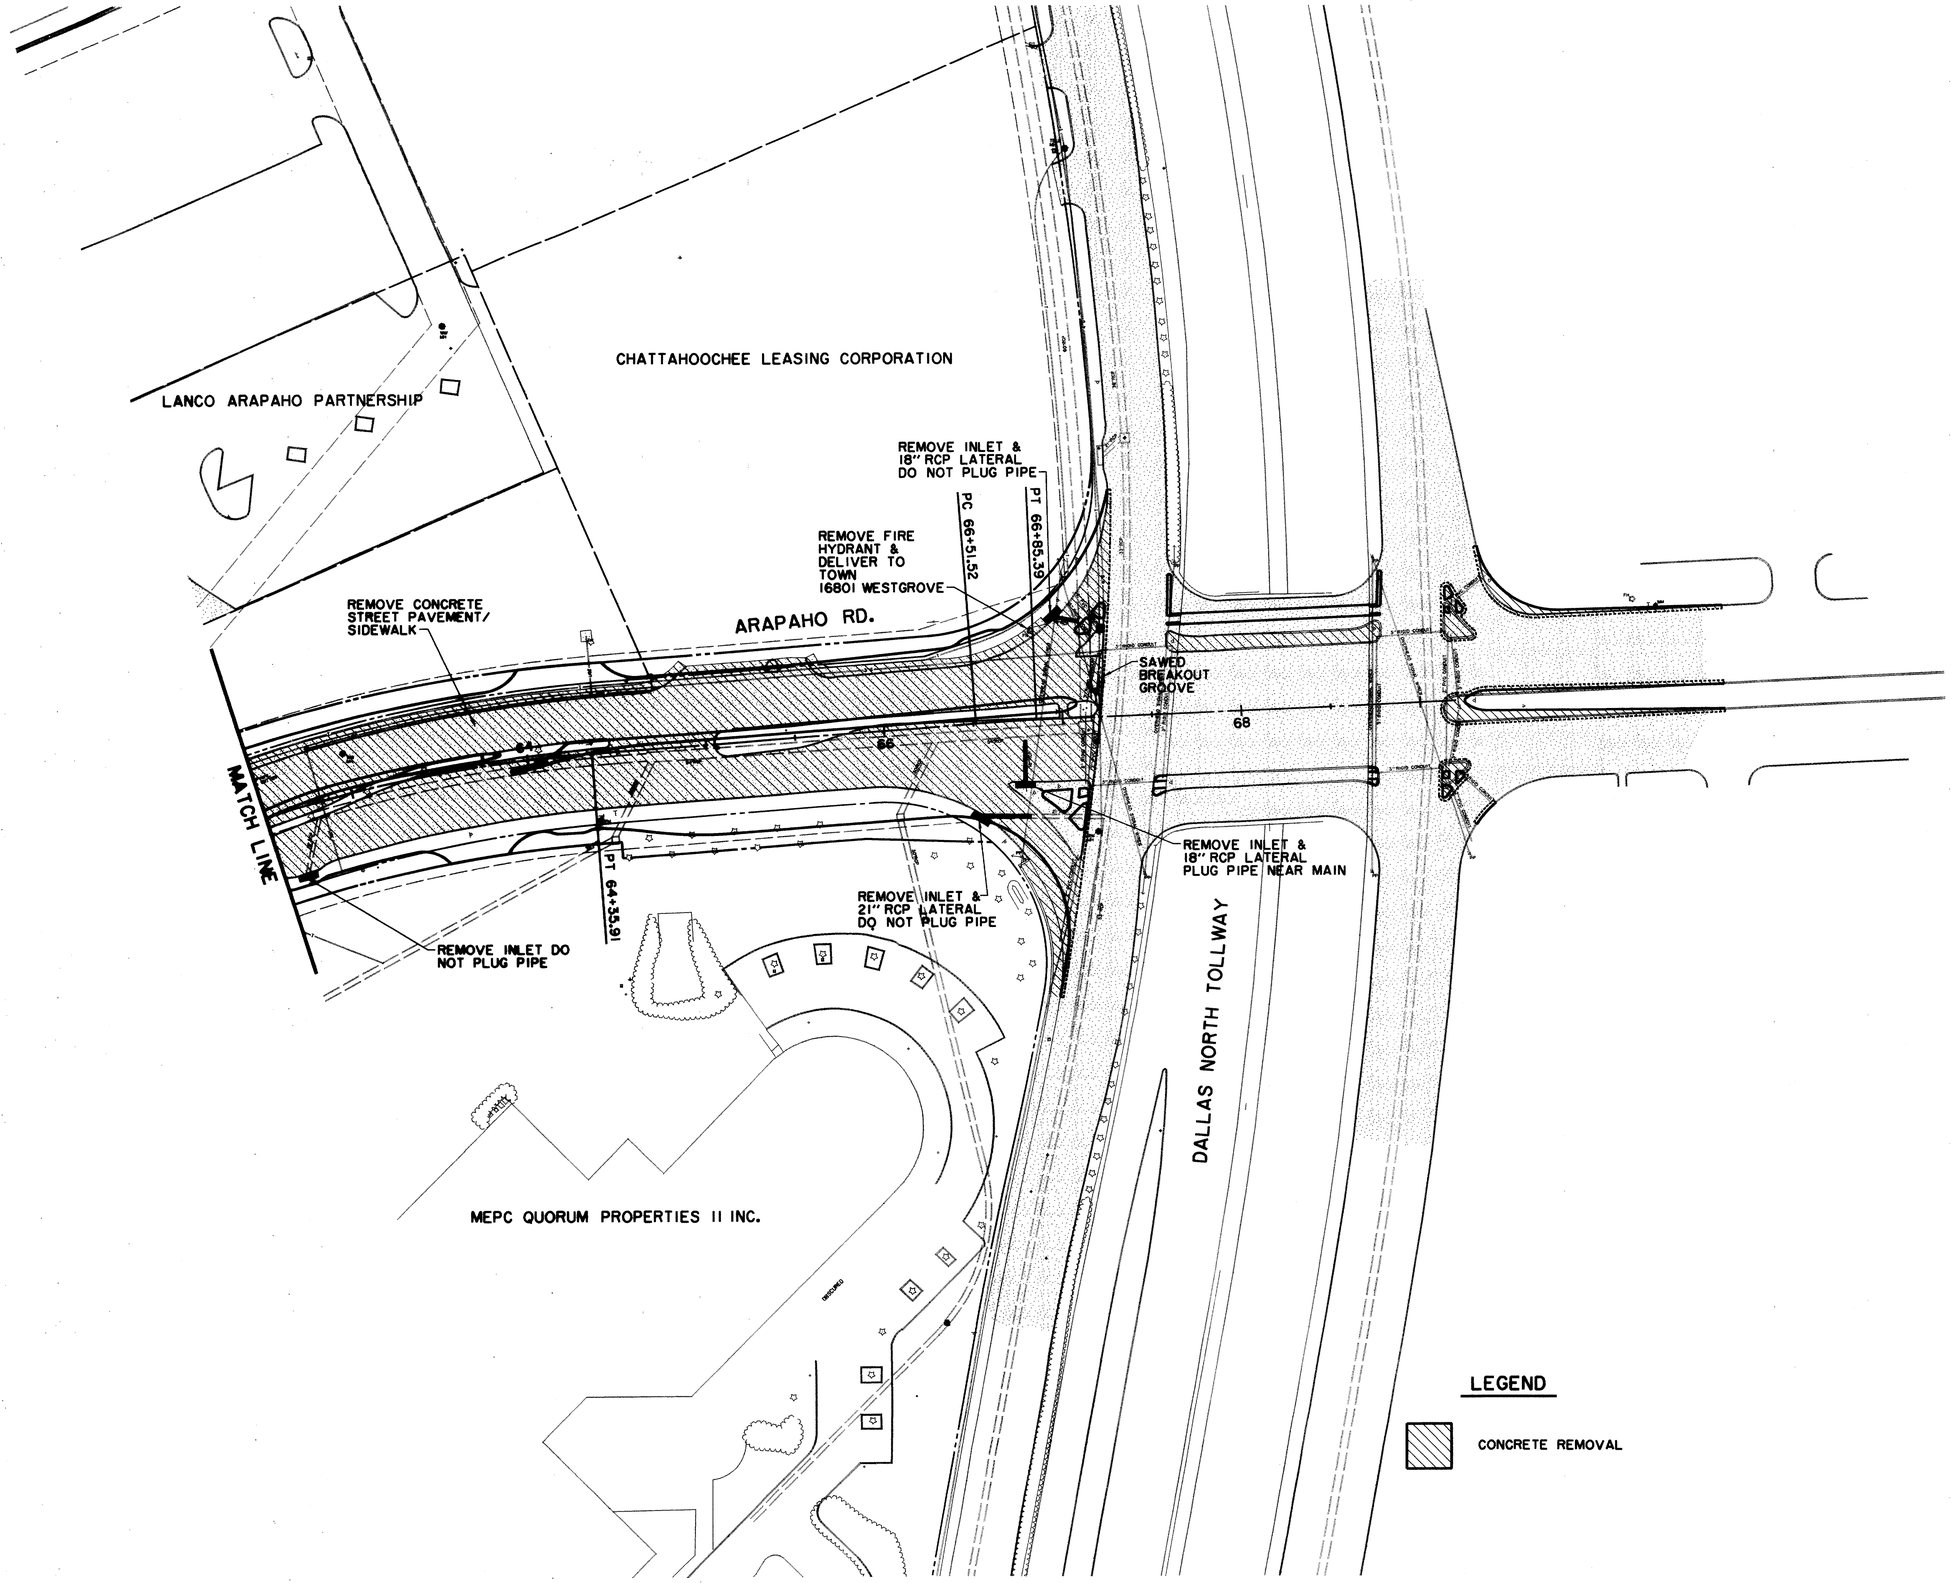

RECORD DOCUMENTS 6/9/2000

THESE RECORD DOCUMENTS HAVE BEEN PREPARED BASED ON INFORMATION PROVIDED BY OTHERS. THE CONSULTANT HAS NOT VERIFIED THE ACCURACY AND/ OR COMPLETENESS OF THIS INFORMATION AND SHALL NOT BE RESPONSIBLE FOR ANY ERRORS OR OMISSIONS THAT MAY BE INCORPORATED AS A RESULT OF ERRONEOUS INFORMATION PROVIDED BY OTHERS.

THE SEAL APPEARING ON THIS DOCUMENT WAS AUTHORIZED BY KENNETH A ROBERTS, P.E. 55446 ON OCTOBER 24, 1997

STATE OF TEXAS
KENNETH A. ROBERTS
55446
REGISTERED
PROFESSIONAL ENGINEER

10-24-97

LEGEND

CONCRETE REMOVAL

DEMOLITION PLAN
STA. 62+50 TO DALLAS NORTH TOLLWAY
ARAPAHO ROAD
ADDISON ROAD TO DALLAS NORTH TOLLWAY

TOWN OF ADDISON, TEXAS

Huitt-Zollars, Inc./Consulting Engineers
Dallas, Fort Worth, Houston, Phoenix, Tustin

DESIGN	DRAWN	APPR.	SCALE	DATE	PROJECT NO.	NO.
HZI	HZI	KAR	1"=40'	OCT 97	1772-01	D-3

N:\PROJ\177201\DGN\1772DM03.DGN