


- LEGEND**
- EXISTING CURB
 - PROPOSED CURB
 - TP=XXX.XX TOP OF PAVEMENT ELEVATION
 - TC=XXX.XX TOP OF CURB ELEVATION
 - CR CURB RETURN
 - CP XXX CONTROL POINT
 - X FENCE
 - FIRE HYDRANT
 - ☼ LIGHT POLE
 - POWER POLE
 - MH SAN. SEWER MANHOLE
 - ⊥ SIGN
 - ☼ TL TRAFFIC SIGNAL
 - ☼ VEGETATION
 - TREE
 - W WATER LINE
 - - - PROPOSED ROW
 - - - EXISTING ROW
 - - - PROPOSED ROW
 - - - TEMPORARY CONSTRUCTION EASEMENT
 - ▨ PROPOSED PAVING
 - ▨ PROPOSED GRAVEL

NOTE:

- SEE SHEET WL-3 AND WL-4 FOR RETAINING WALL DETAILS
- RETAINING WALL DIMENSIONS TO BACK OF RETAINING WALL.

- LEGEND - PROFILE**
- ▨ FOOTING

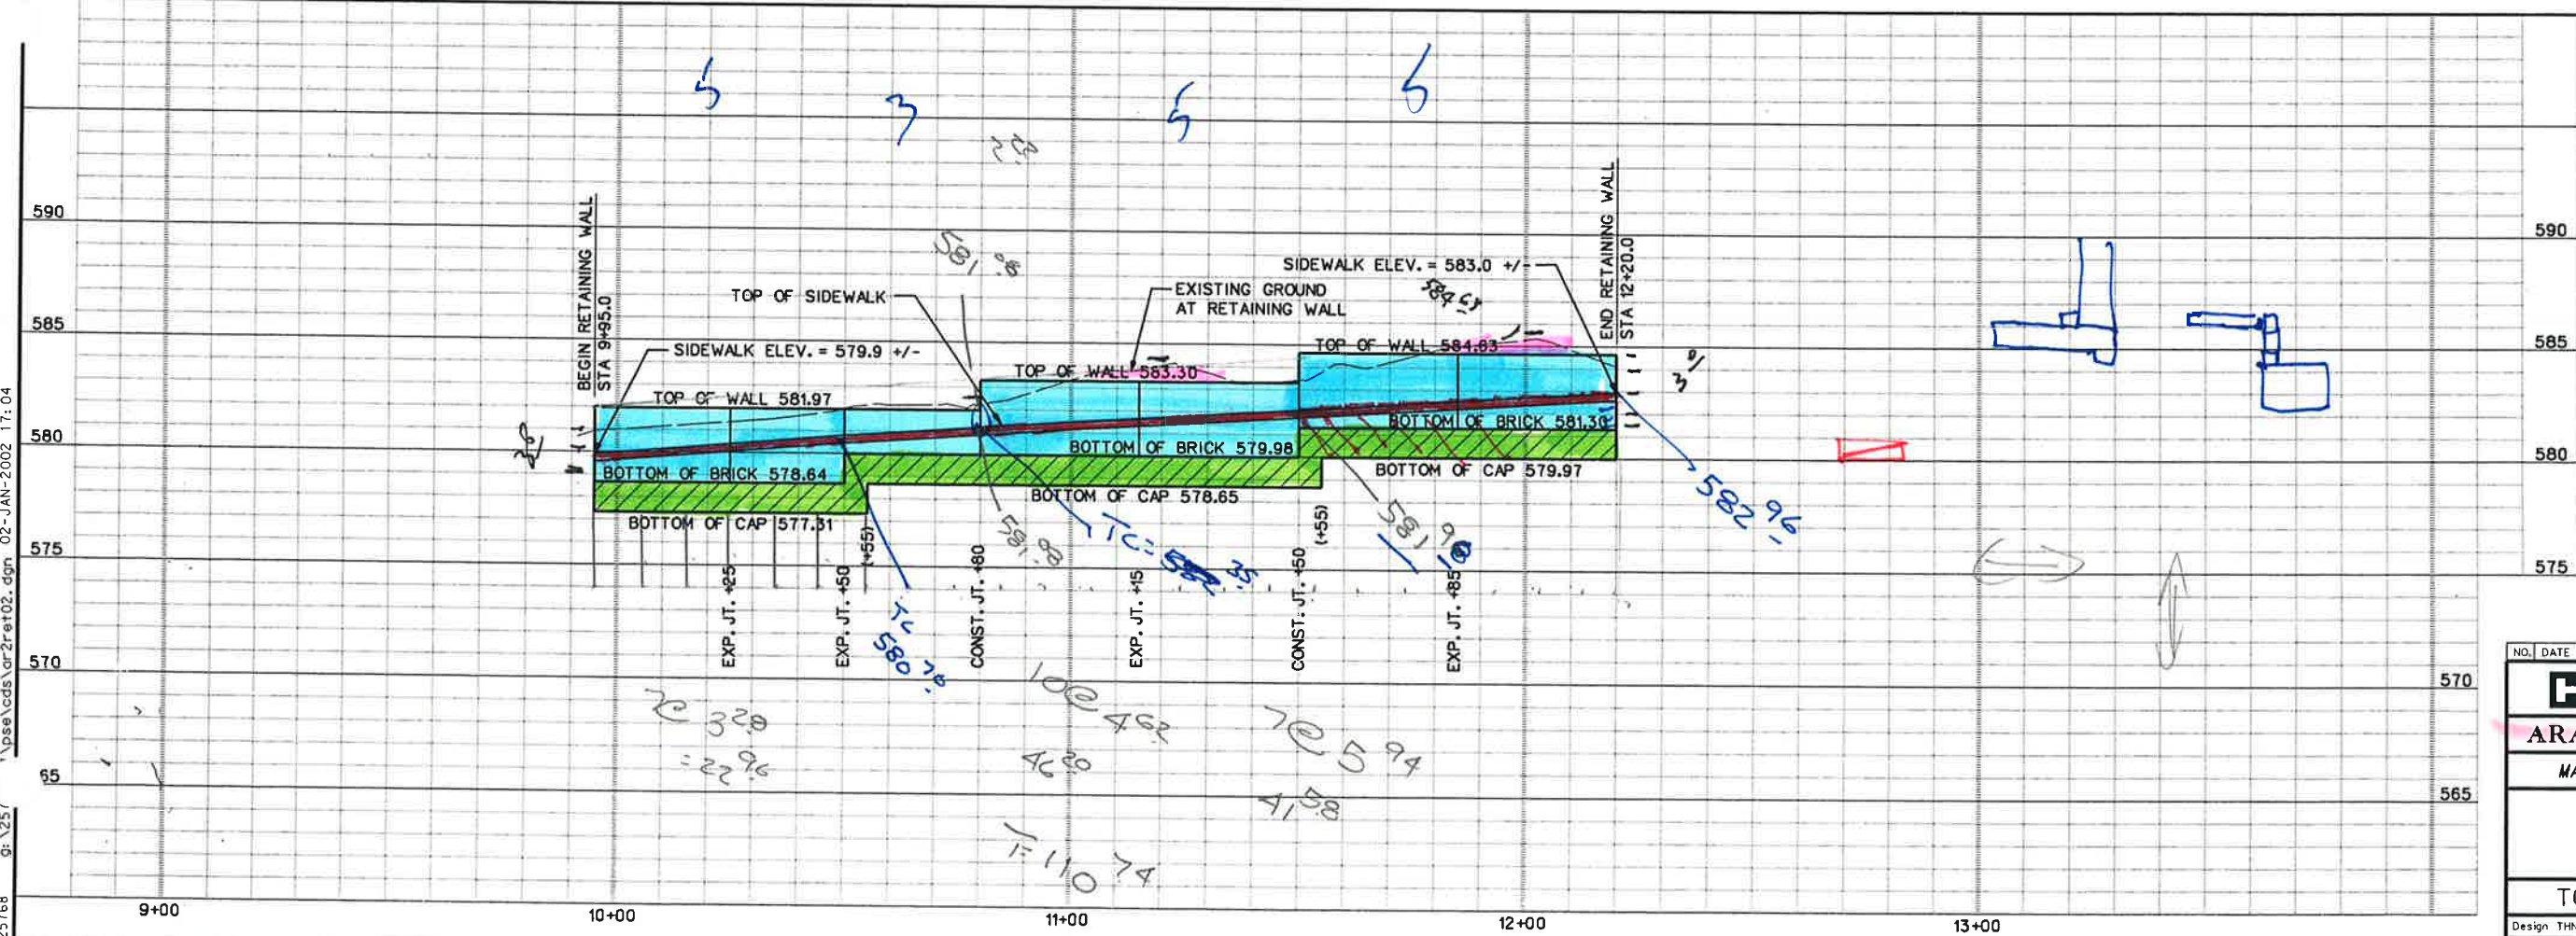

NO.	DATE	REVISION	APPROV.
HNTB ARCHITECTS ENGINEERS PLANNERS The HNTB Companies			
ARAPAHO ROAD - PHASE II			
MARSH LANE TO SURVEYOR BOULEVARD			
MARSH RETAINING WALL PLAN AND PROFILE			
TOWN OF ADDISON, TEXAS			
Design THN	Drawn THN	DATE	SCALE
Check AMS	Check AMS	DEC 01	H: 1" = 20' V: 1" = 4'
			PROJECT NO. 25768
			SHEET ID WL-1

25768 g:\25768\pse\cds\ar2\ret02.dgn 02-JAN-2002 17:04