


NOTE:
 1. SEE SHEET SR-1 FOR STRUCTURAL DETAILS FOR RETAINING WALL 1.
 2. SQUARE FEET SURFACE AREA OF RETAINING WALL IS MEASURED BETWEEN TOP OF WALL/COPING AND TOP OF STRUCTURAL RETAINING WALL.



PROFILE LEGEND

STRUCTURAL RETAINING WALL

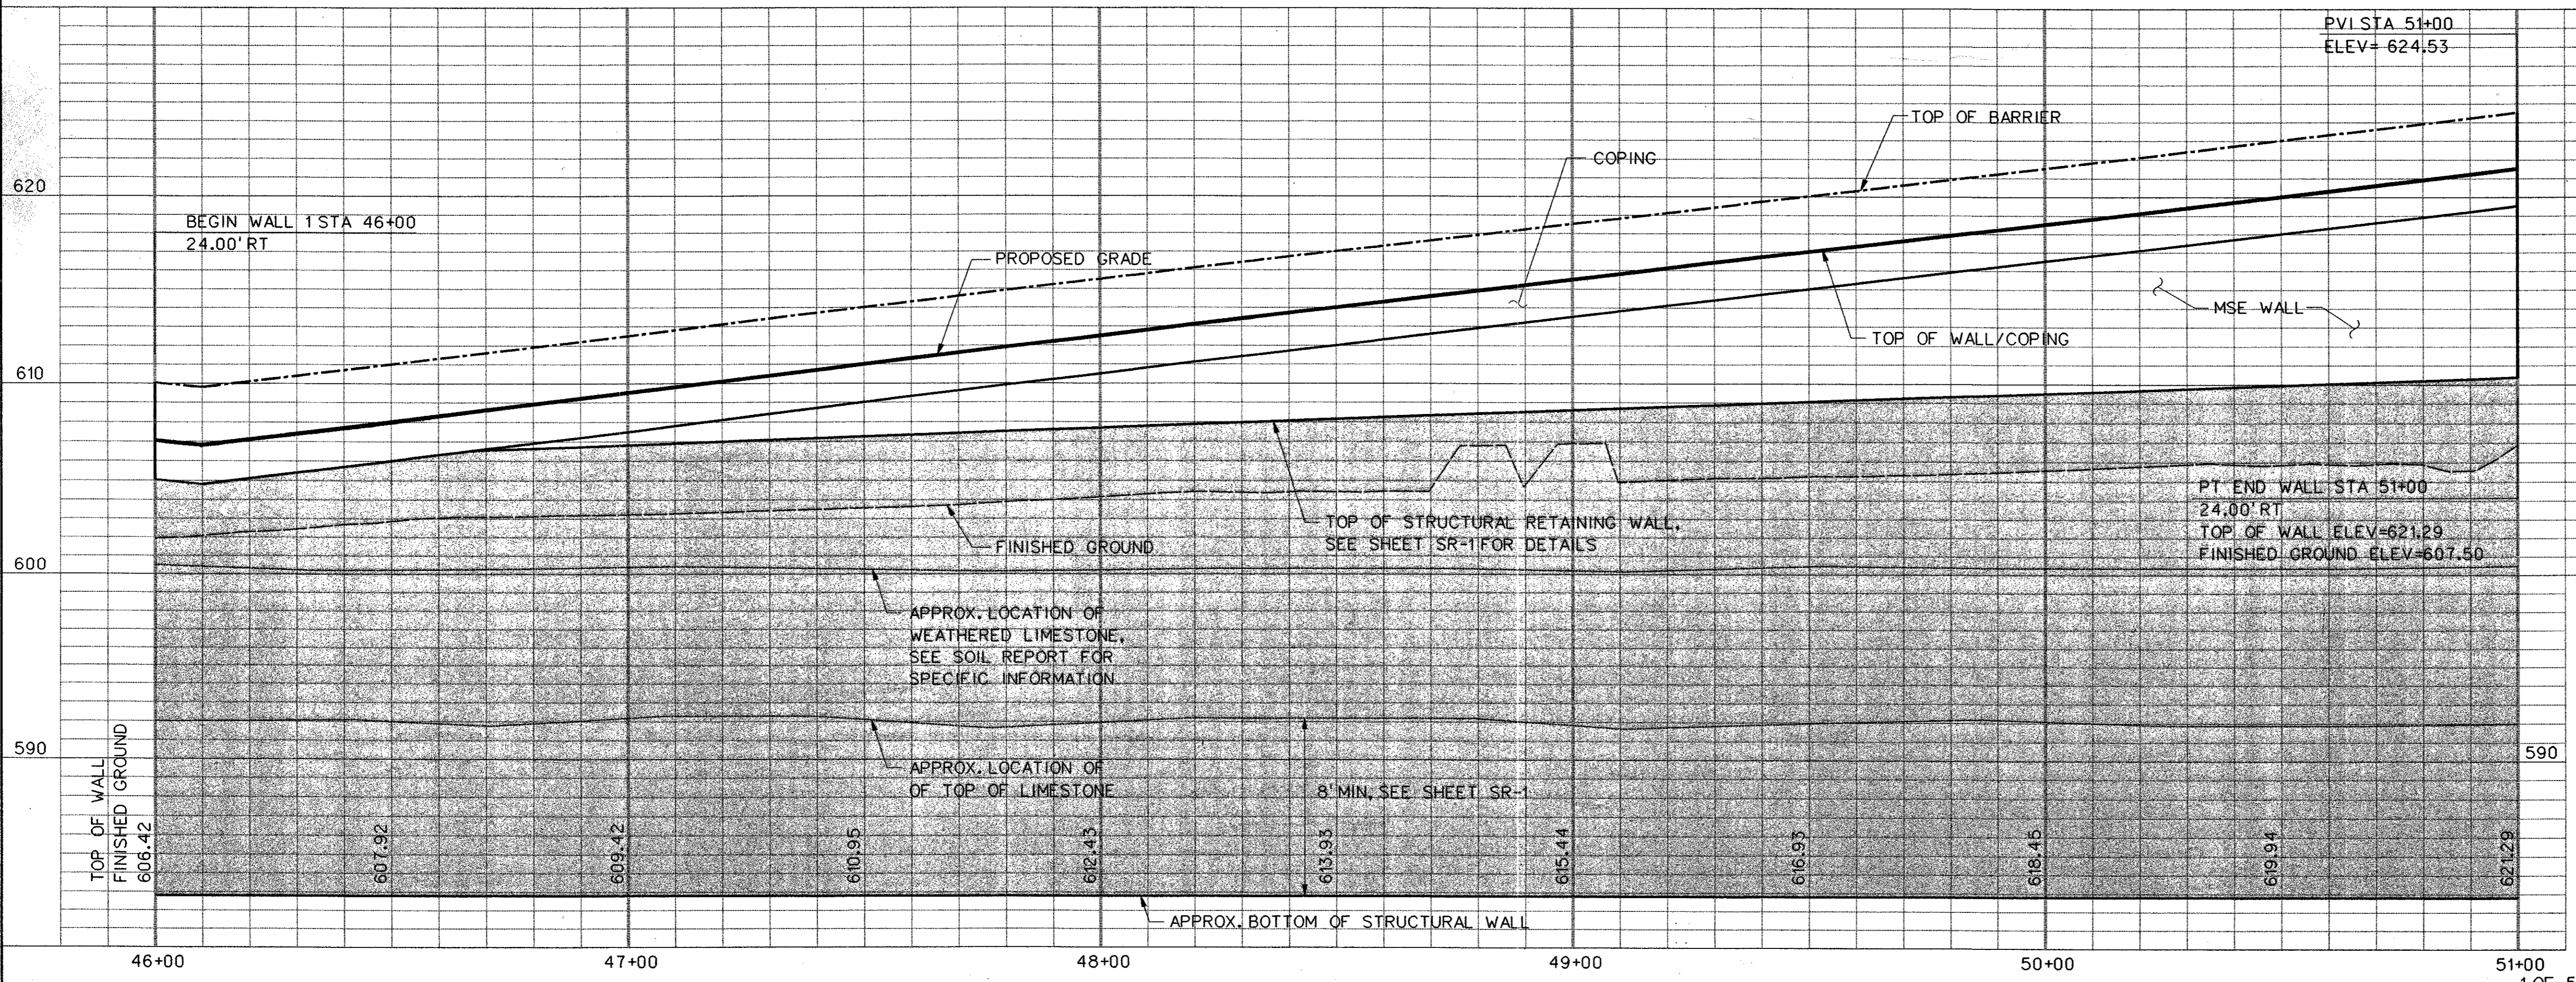

NO.	DATE	REVISION	APPROV.
5	6/3/04	REISSUE SHEET	JSN
HNTB ARCHITECTS ENGINEERS PLANNERS <small>The HNTB Companies</small>			119
ARAPAHO ROAD - PHASE III SURVEYOR BOULEVARD TO ADDISON ROAD RETAINING WALL PLAN AND PROFILE RETAINING WALL 1 STA 46+00 TO STA 51+00 TOWN OF ADDISON, TEXAS			
Design	JSN	Drawn	GFS
Check	JDH	Check	JSN
DATE	APRIL 04	SCALE	H:V = 20' V:1"=5'
PROJECT NO.	25768	SHEET NO.	RT-1

29-JUN-2004 12:38
 G:\25768-Ph3\N1\CDs\ar3ret01.dgn