
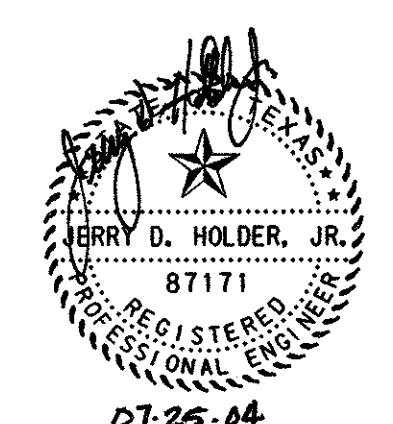


NOTE:
1. SQUARE FEET SURFACE AREA OF
RETAINING WALL IS MEASURED
BETWEEN TOP OF WALL/COPING
AND 1' BELOW FINISHED GROUND.

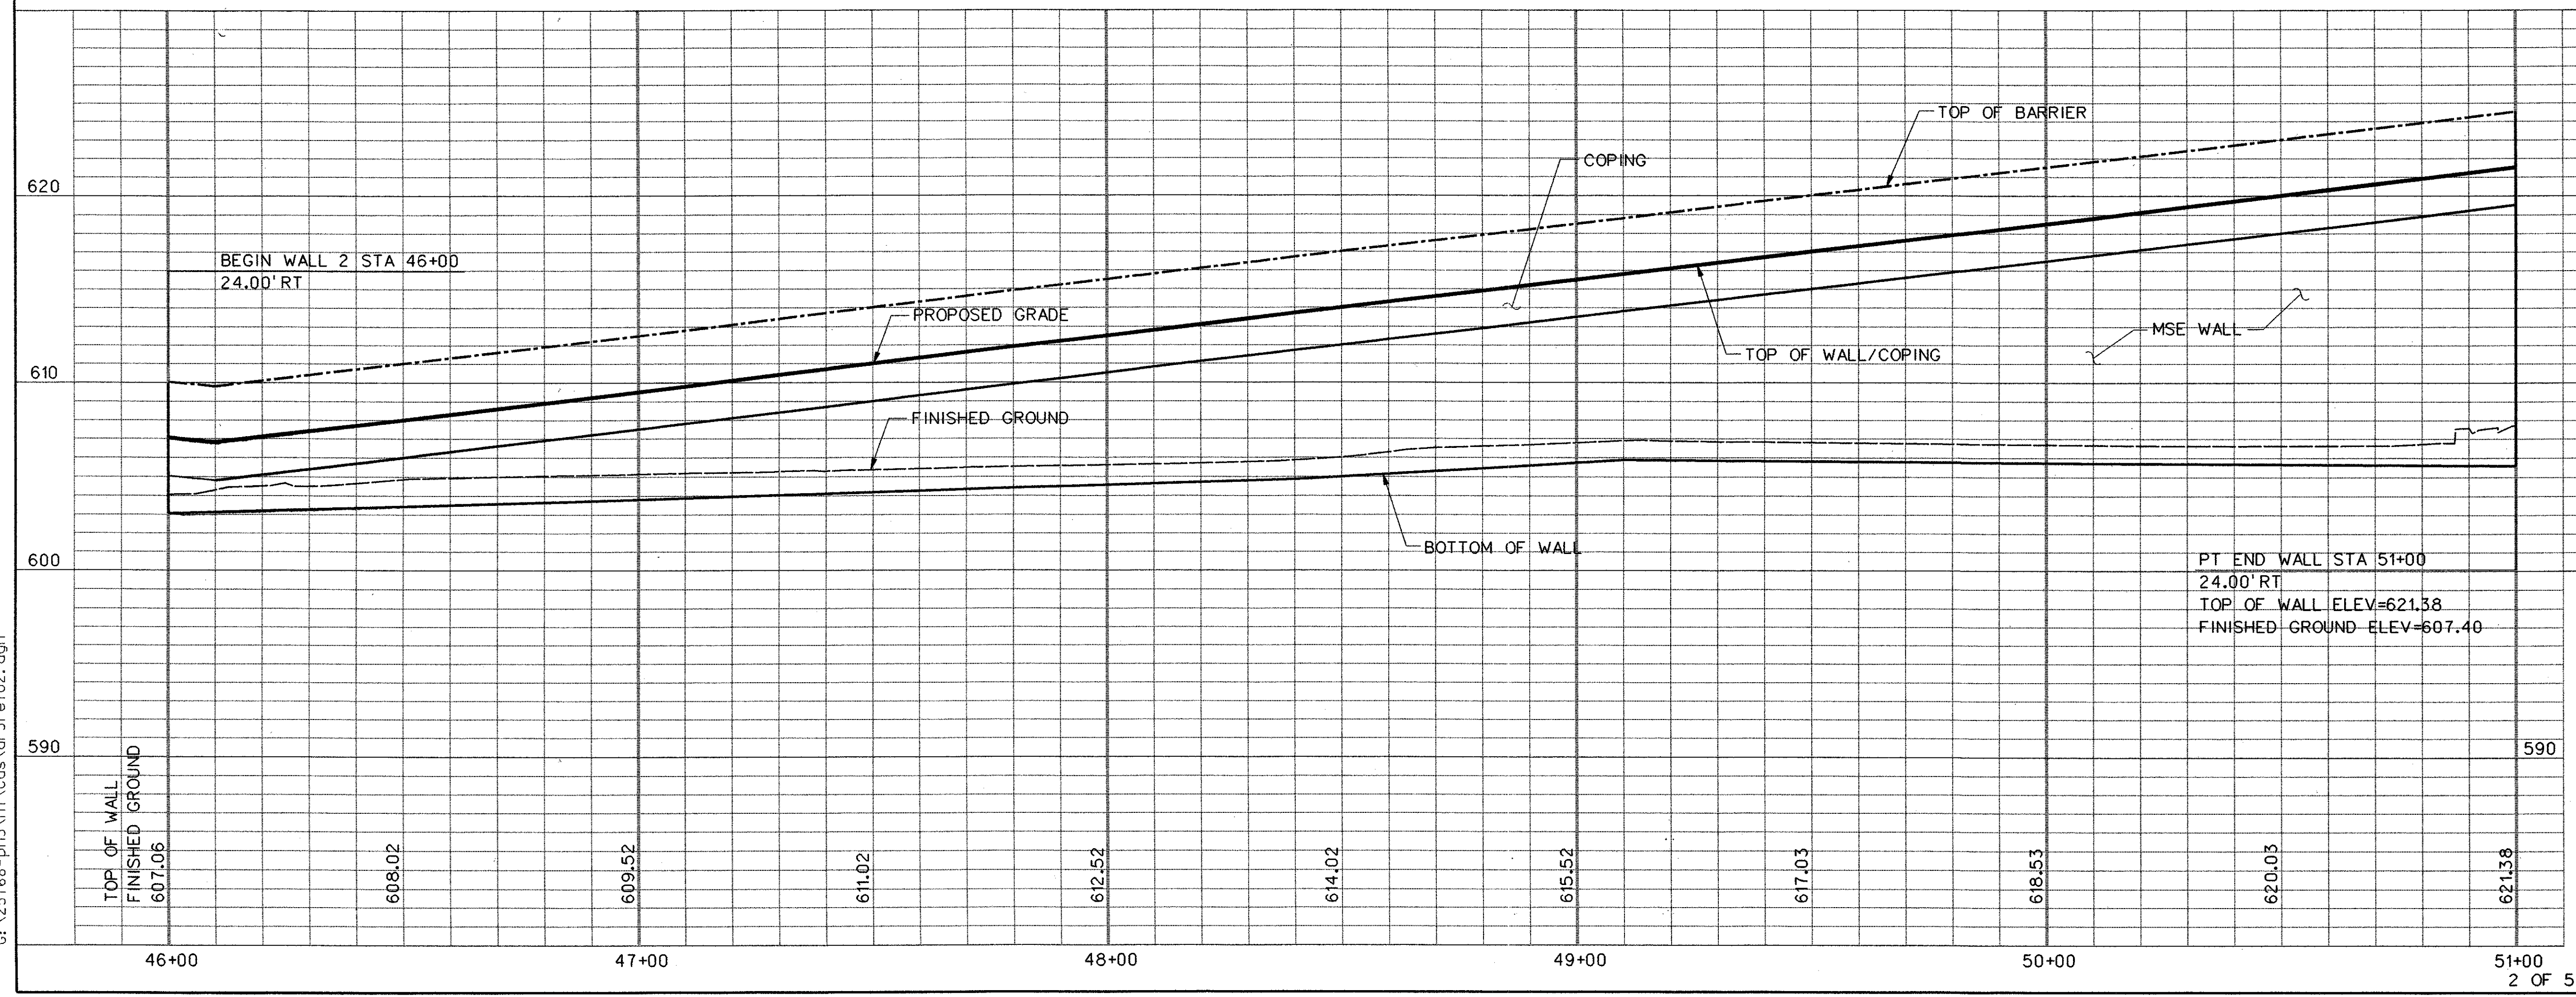

5	6/3/04	REISSUE SHEET	120
NO.	DATE	REVISION	APPROV.
HNTB ARCHITECTS ENGINEERS PLANNERS The HNTB Companies			
ARAPAHO ROAD - PHASE III			
SURVEYOR BOULEVARD TO ADDISON ROAD			
RETAINING WALL PLAN AND PROFILE			
RETAINING WALL 2			
STA 46+00 TO STA 51+00			
TOWN OF ADDISON, TEXAS			
Design JSN	Drawn GFS	DATE	SCALE
Check JDH	Check JSN	APRIL 04	H: 1"=20' V: 1"=5'
PROJECT NO. 25768		SHEET NO. RT-2	

29-JUN-2004 12:38
G:\25768-ph3\h1\Cds\or3r\ret02.dgn