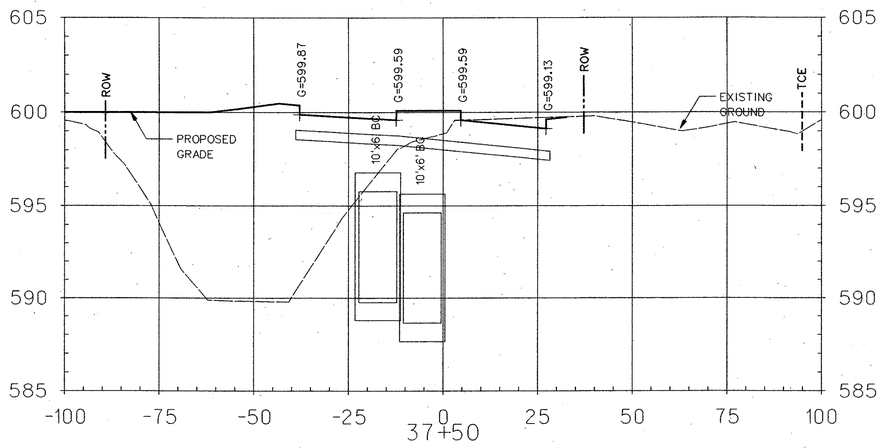

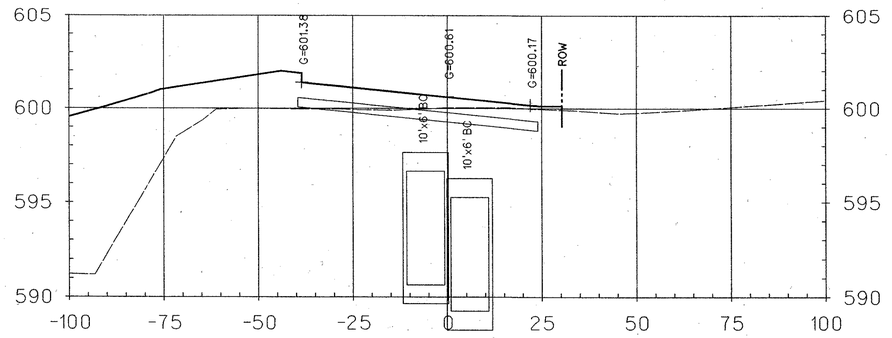

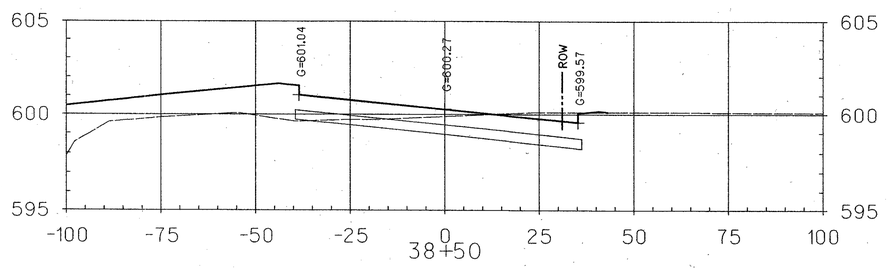

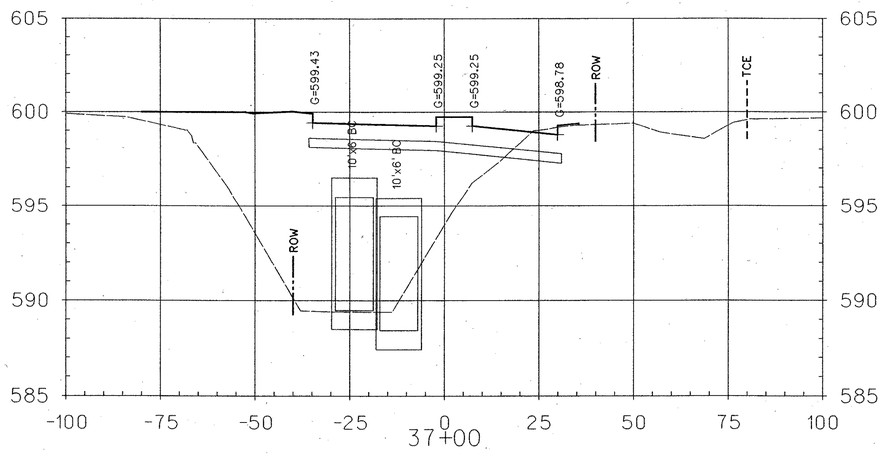

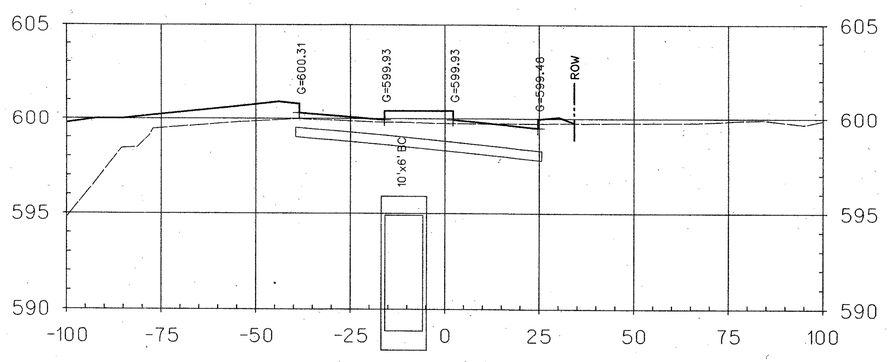

LEGEND

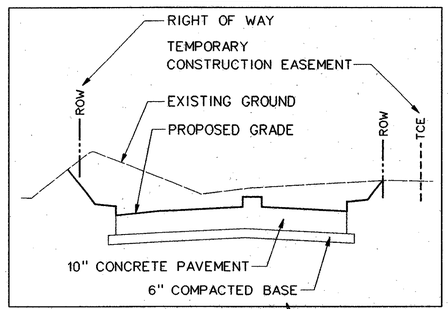

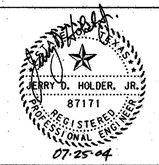

125

NO.	DATE	REVISION	APPROV.

HNTB ARCHITECTS ENGINEERS PLANNERS
The HNTB Companies

ARAPAHO ROAD - PHASE III

SURVEYOR BOULEVARD TO ADDISON ROAD

CROSS SECTIONS

SHEET 2 OF 29

TOWN OF ADDISON, TEXAS

Design JSN	Drawn GFS	DATE	SCALE	PROJECT NO.	SHEET NO.
Check JDH	Check JSN	APRIL 04	1"= 20'H 1"= 4'V	25768	XS-2

26-JUL-2004 16:05
G:\25768-ph3\h1\Cds\ar3xs02.dgn