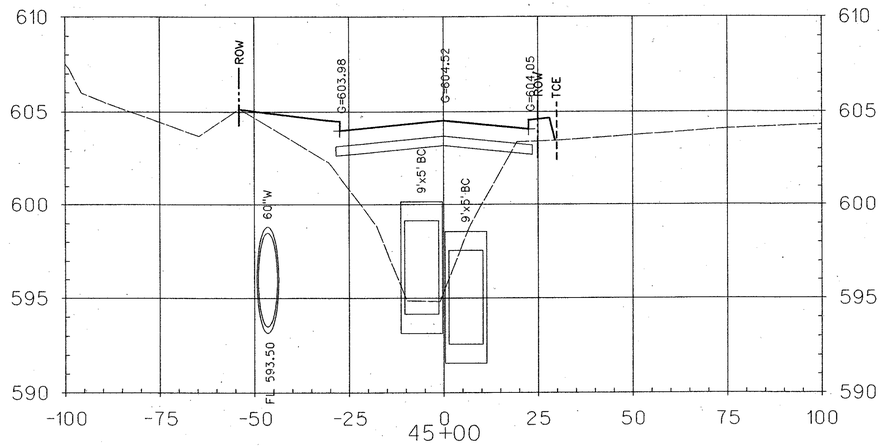

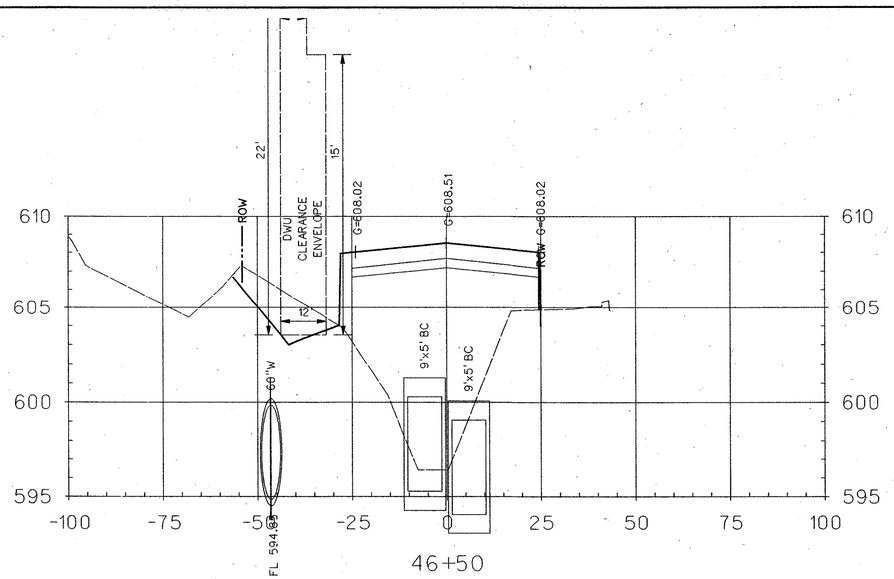

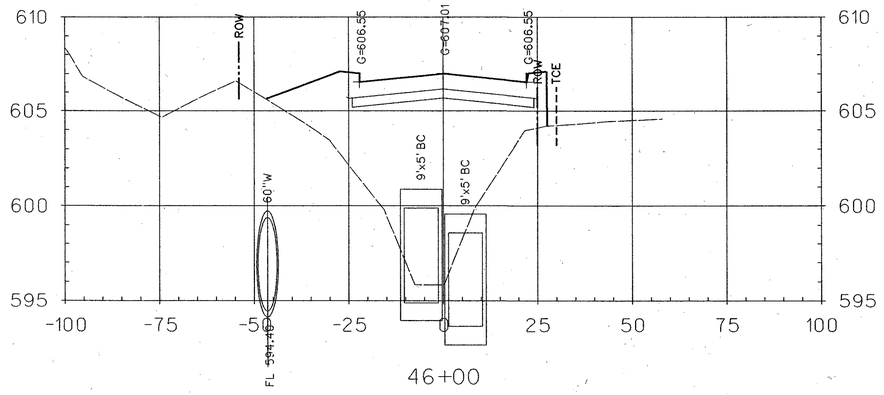

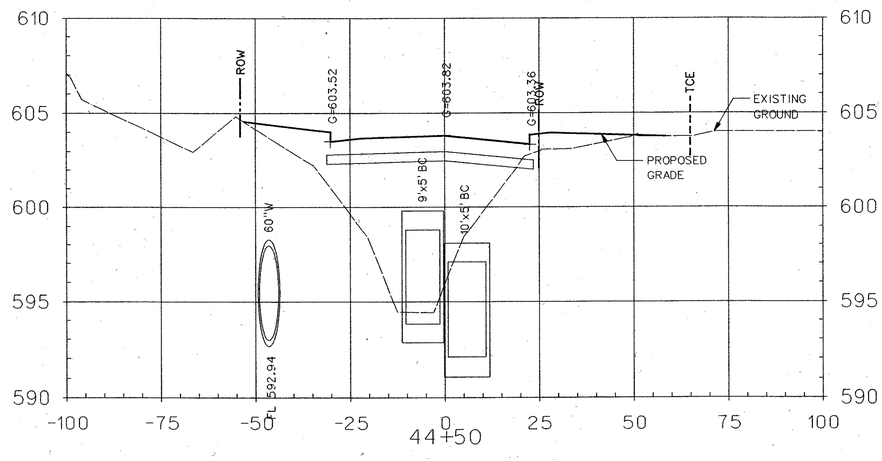

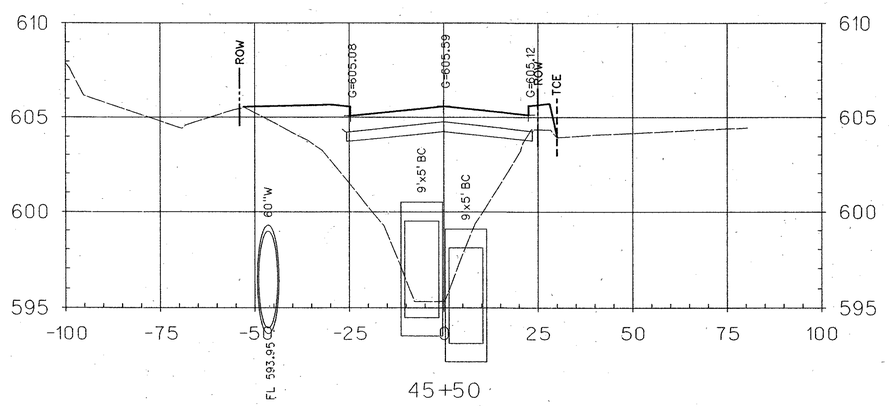

LEGEND

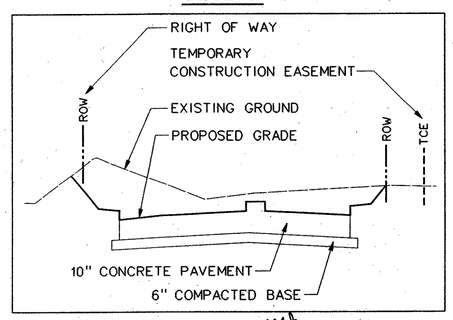

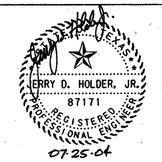

128

NO.	DATE	REVISION	APPROV.

HNTB ARCHITECTS ENGINEERS PLANNERS The HNTB Companies

ARAPAHO ROAD - PHASE III

SURVEYOR BOULEVARD TO ADDISON ROAD

CROSS SECTIONS

SHEET 5 OF 29

TOWN OF ADDISON, TEXAS

Design JSN	Drawn GFS	DATE	SCALE	PROJECT NO.	SHEET NO.
Check JDH	Check JSN	APRIL 04	1"= 20' H 1"= 4' V	25768	XS-5

26-JUL-2004 16:06
G:\25768\ph3\h1\cds\ar3xs05.dgn