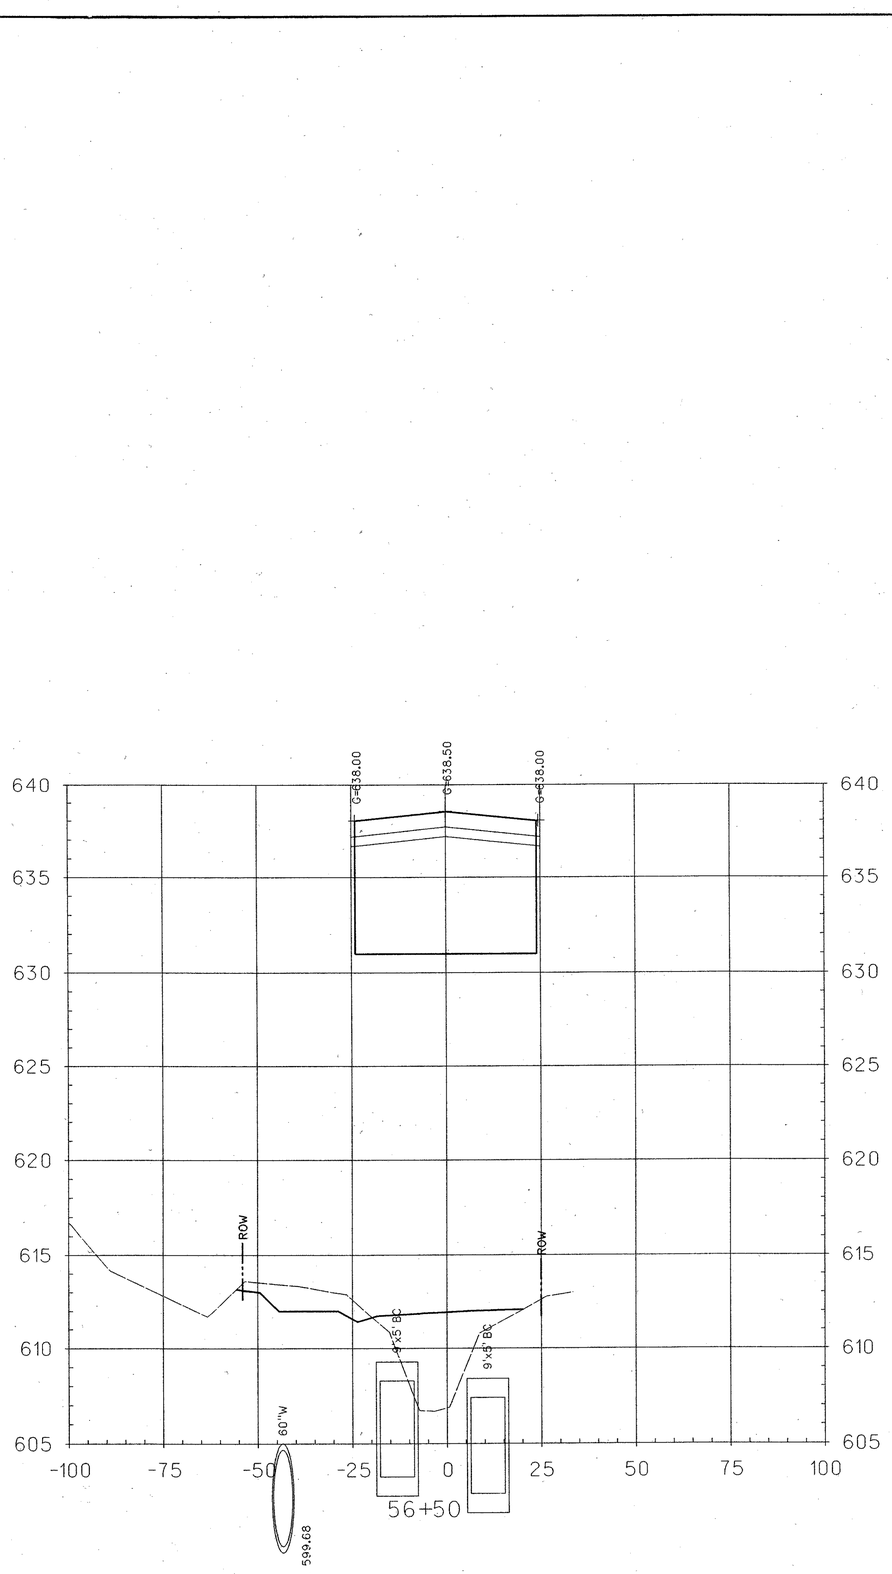

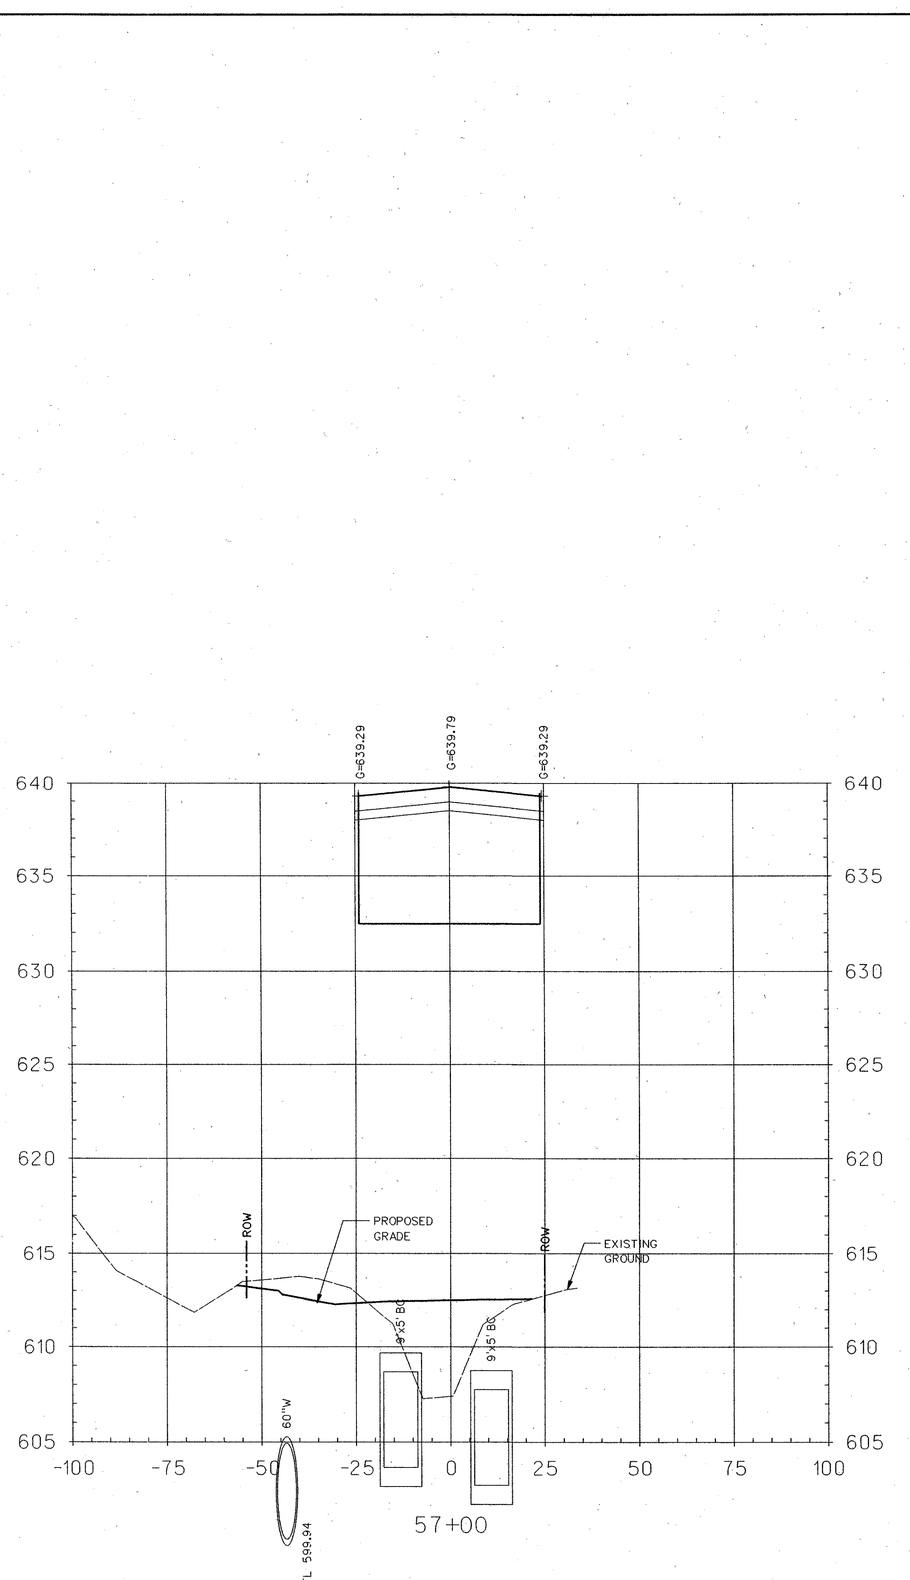

LEGEND

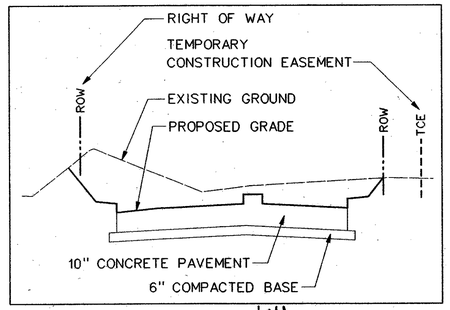

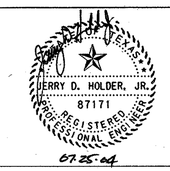

136

NO.	DATE	REVISION	APPROV.

HNTB ARCHITECTS ENGINEERS PLANNERS
The HNTB Companies

ARAPAHO ROAD - PHASE III

SURVEYOR BOULEVARD TO ADDISON ROAD

CROSS SECTIONS

SHEET 13 OF 29

TOWN OF ADDISON, TEXAS

Design JSN	Drawn GFS	DATE	SCALE	PROJECT NO.	SHEET NO.
Check JDH	Check JSN	APRIL 04	1"= 20'H 1"= 4'V	25768	XS-13

26-JUL-2004 16:07
G:\25768_ph3\civil\Cads\ar3xs13.dgn