



DALLAS AREA RAPID TRANSIT
PROPERTY ACQUISITION CORPORATION

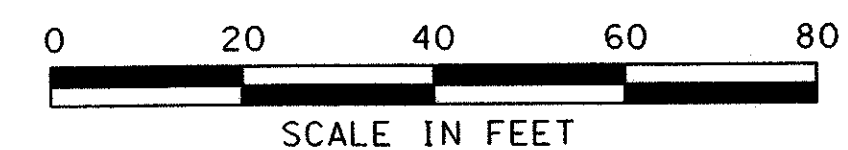


LEGEND

- ARAPAHO ROW
- TEMPORARY CONSTRUCTION EASEMENT
- PROPOSED
- EXISTING ROW
- PROPOSED ROW
- TEMPORARY CONSTRUCTION EASEMENT
- EXISTING EASEMENT
- PROPOSED RETAINING WALL

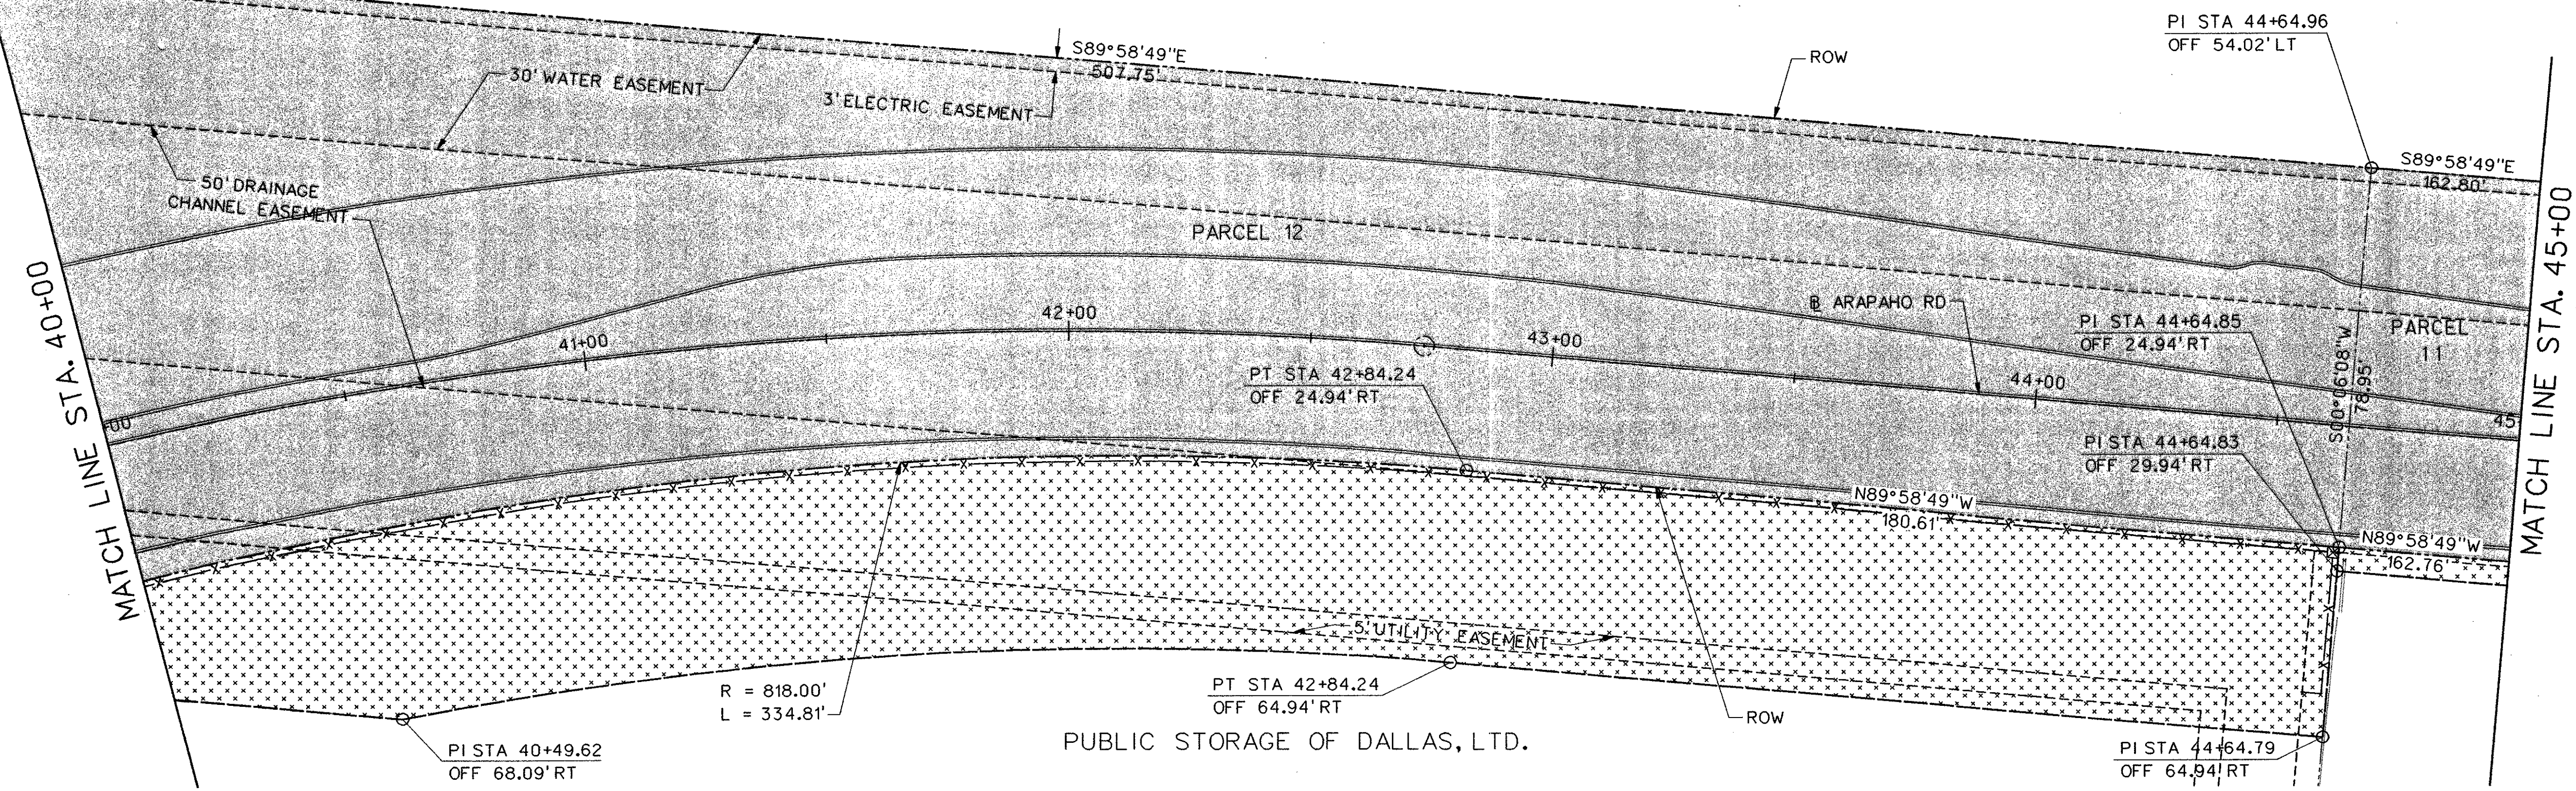

DALLAS AREA RAPID TRANSIT
PROPERTY ACQUISITION CORPORATION

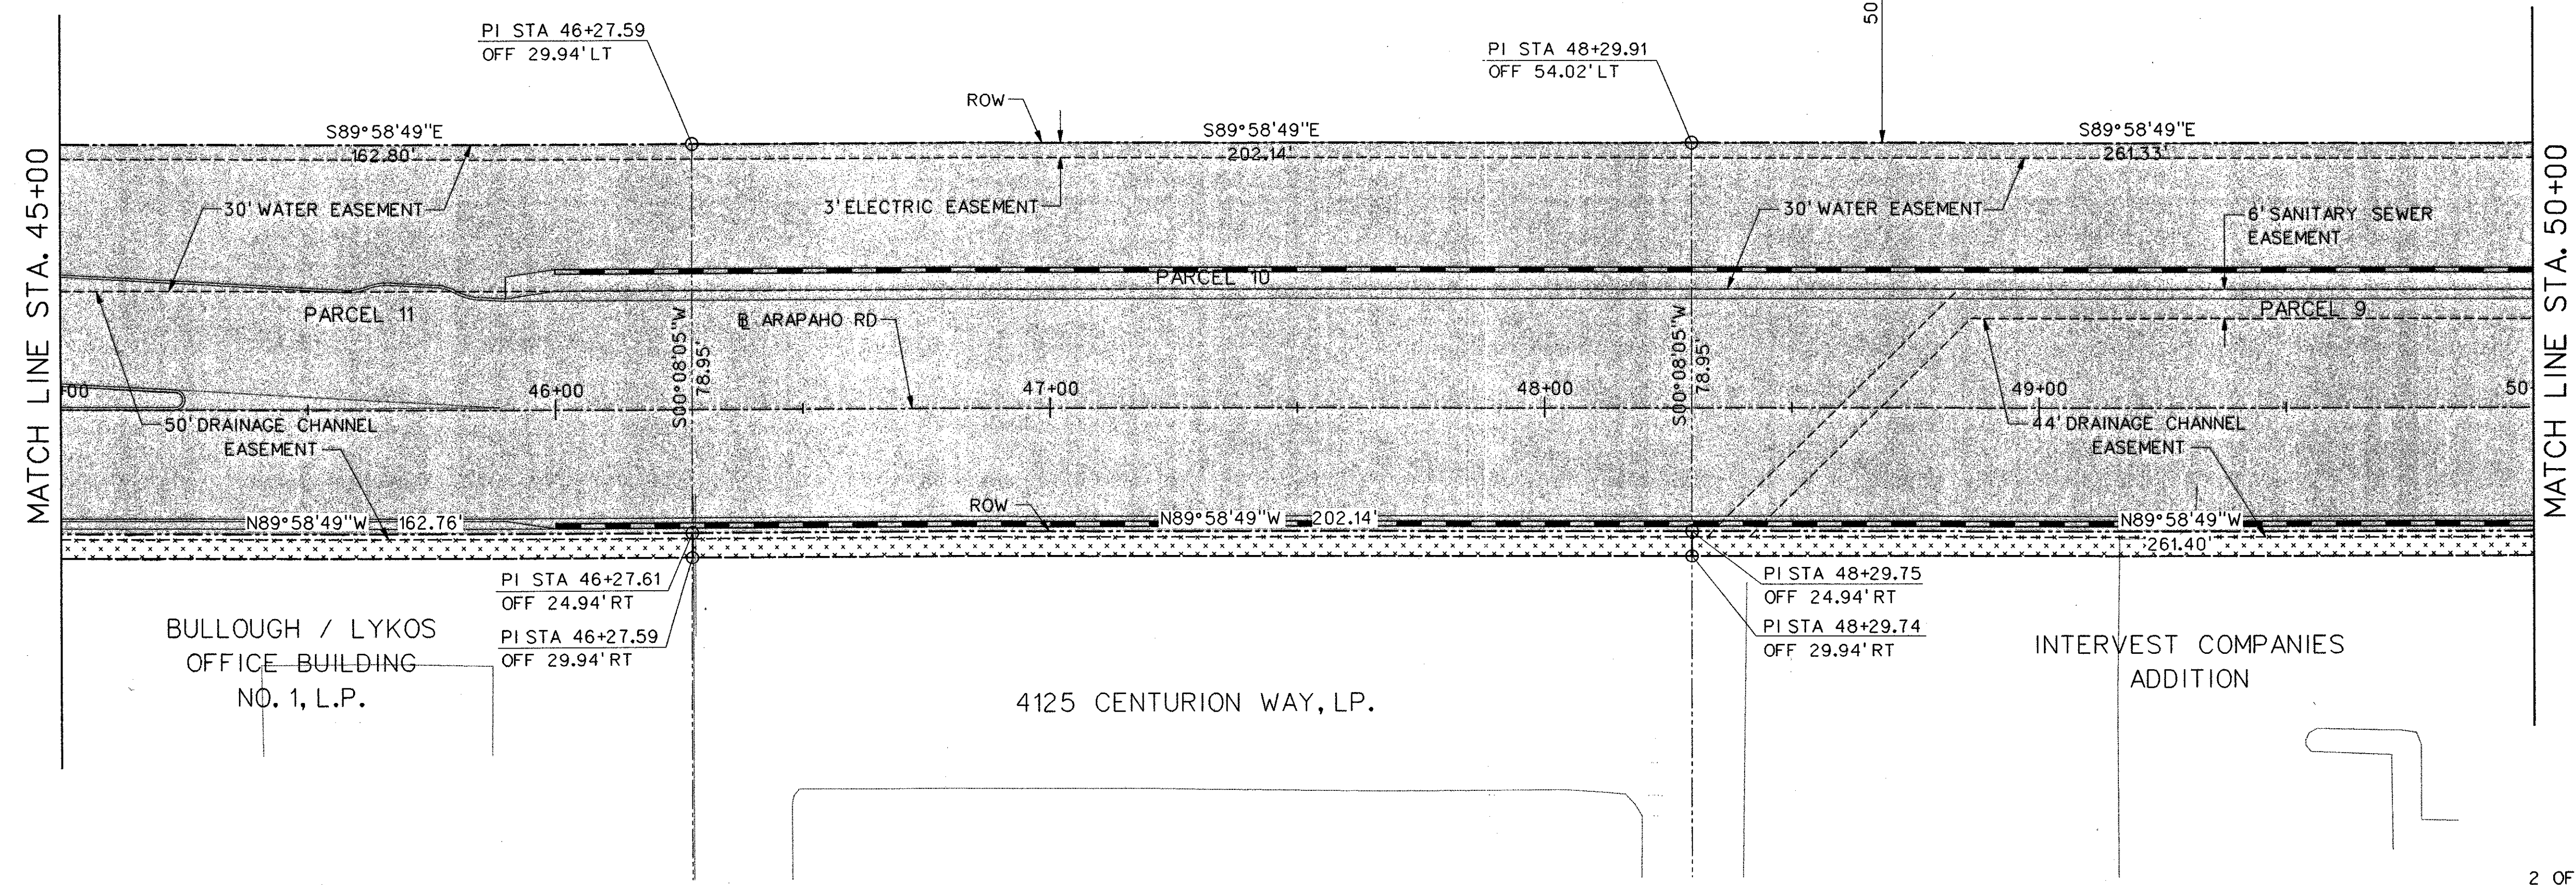

NO.	DATE	REVISION	APPROV.
ARCHITECTS ENGINEERS PLANNERS The HNTB Companies			14
ARAPAHO ROAD - PHASE III SURVEYOR BOULEVARD TO ADDISON ROAD RIGHT-OF-WAY MAP STA 40+00 TO STA 50+00 TOWN OF ADDISON, TEXAS			
Design JSN	Drawn GFS	DATE	SCALE
Check JDH	Check JSN	APRIL 04	1" = 20'
PROJECT NO.		SHEET NO.	
25768		RW-2	

29-JUN-2004 12:13 G:\25768-PH3\11\CasVar3row02.dgn