
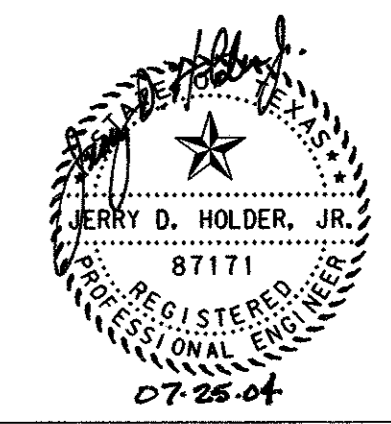
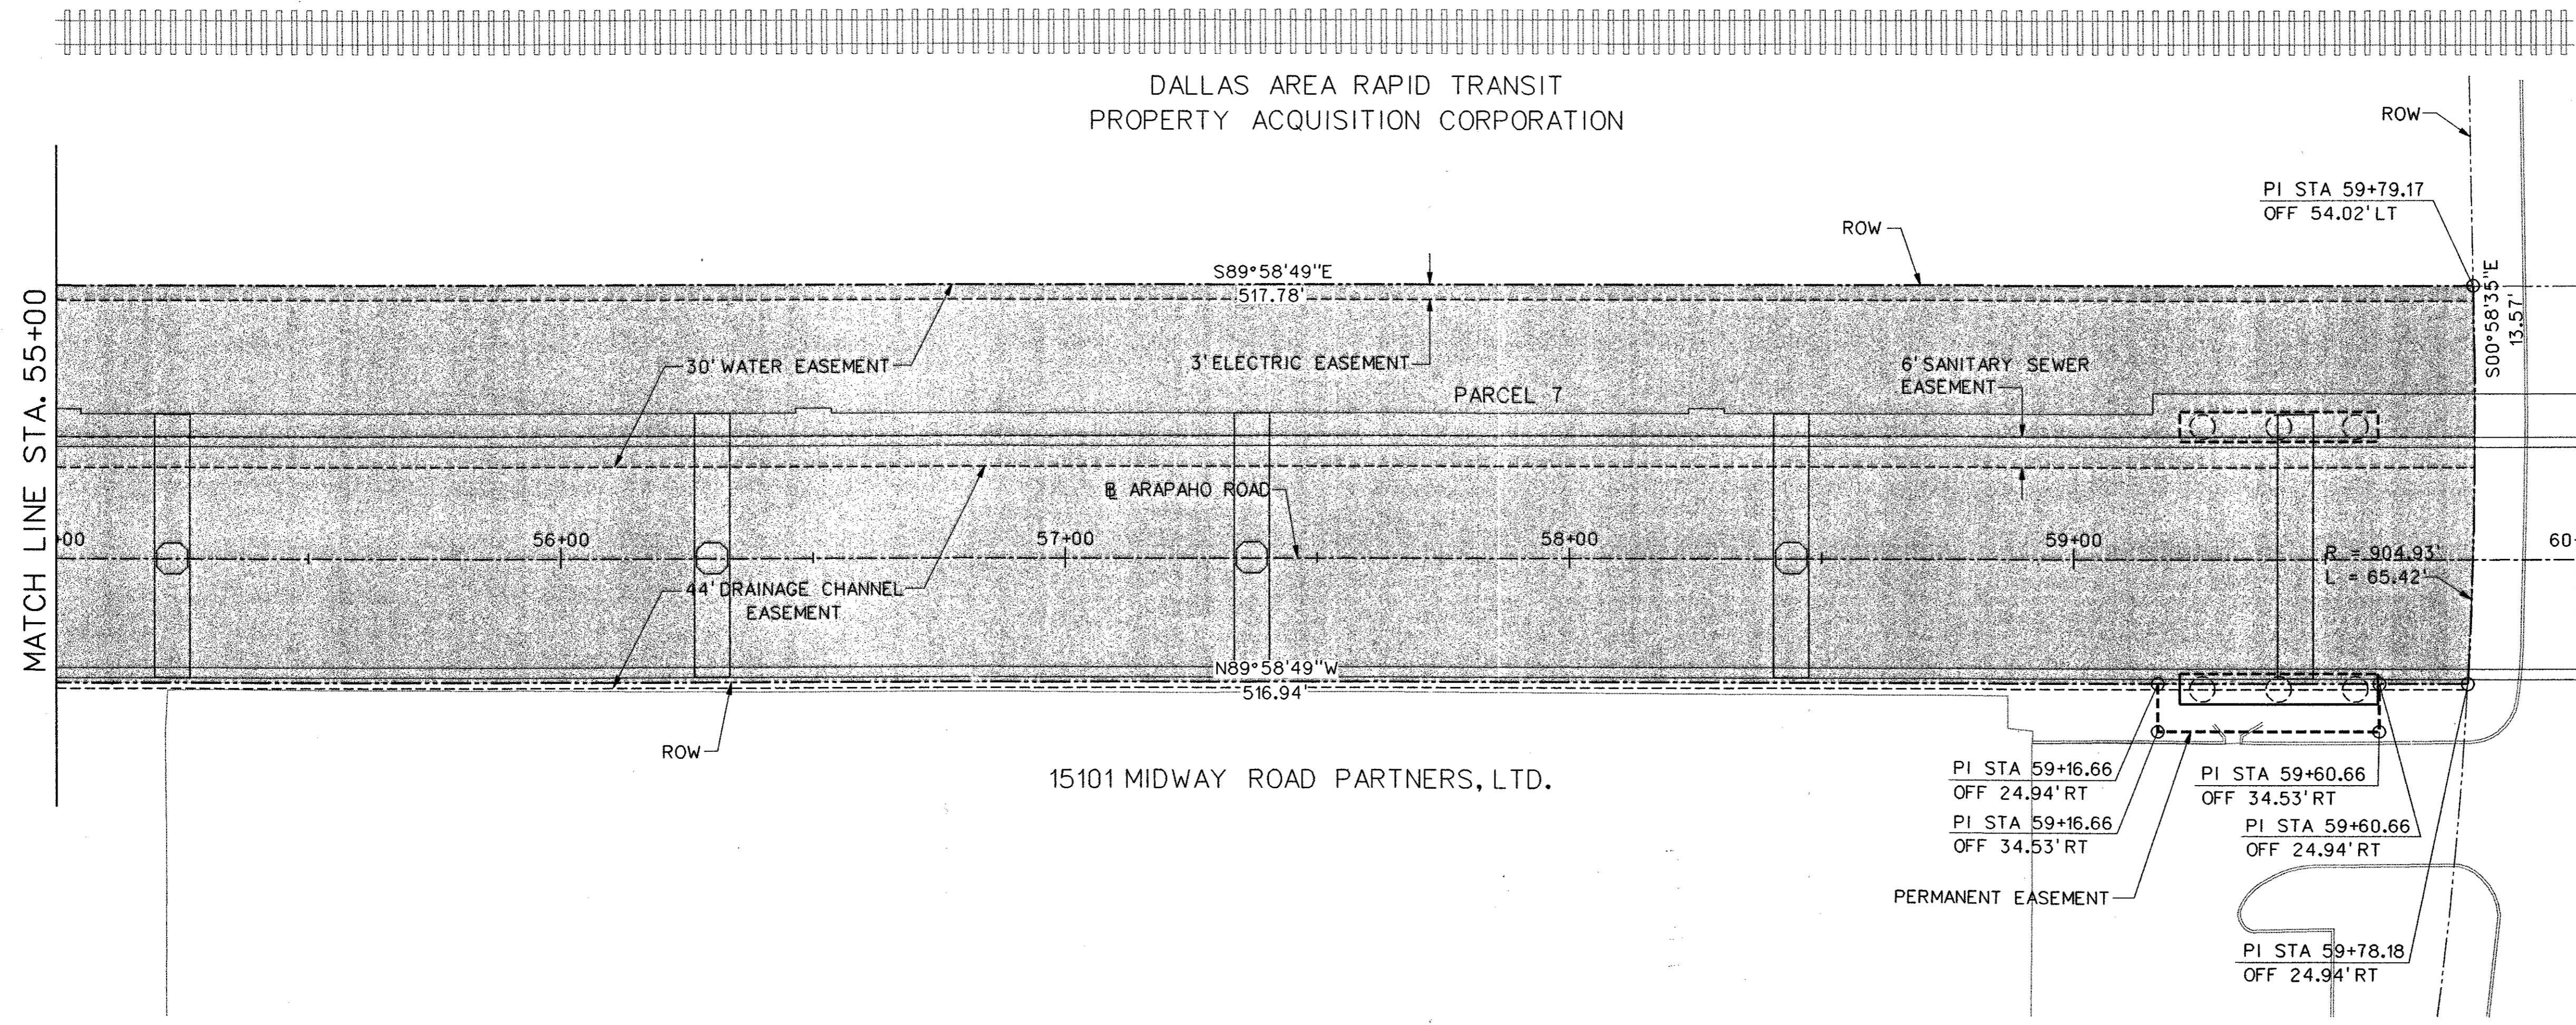


LEGEND

- ARAPAHO ROW
- TEMPORARY CONSTRUCTION EASEMENT
- PROPOSED R
- EXISTING ROW
- PROPOSED ROW
- TEMPORARY CONSTRUCTION EASEMENT
- EXISTING EASEMENT
- PROPOSED RETAINING WALL

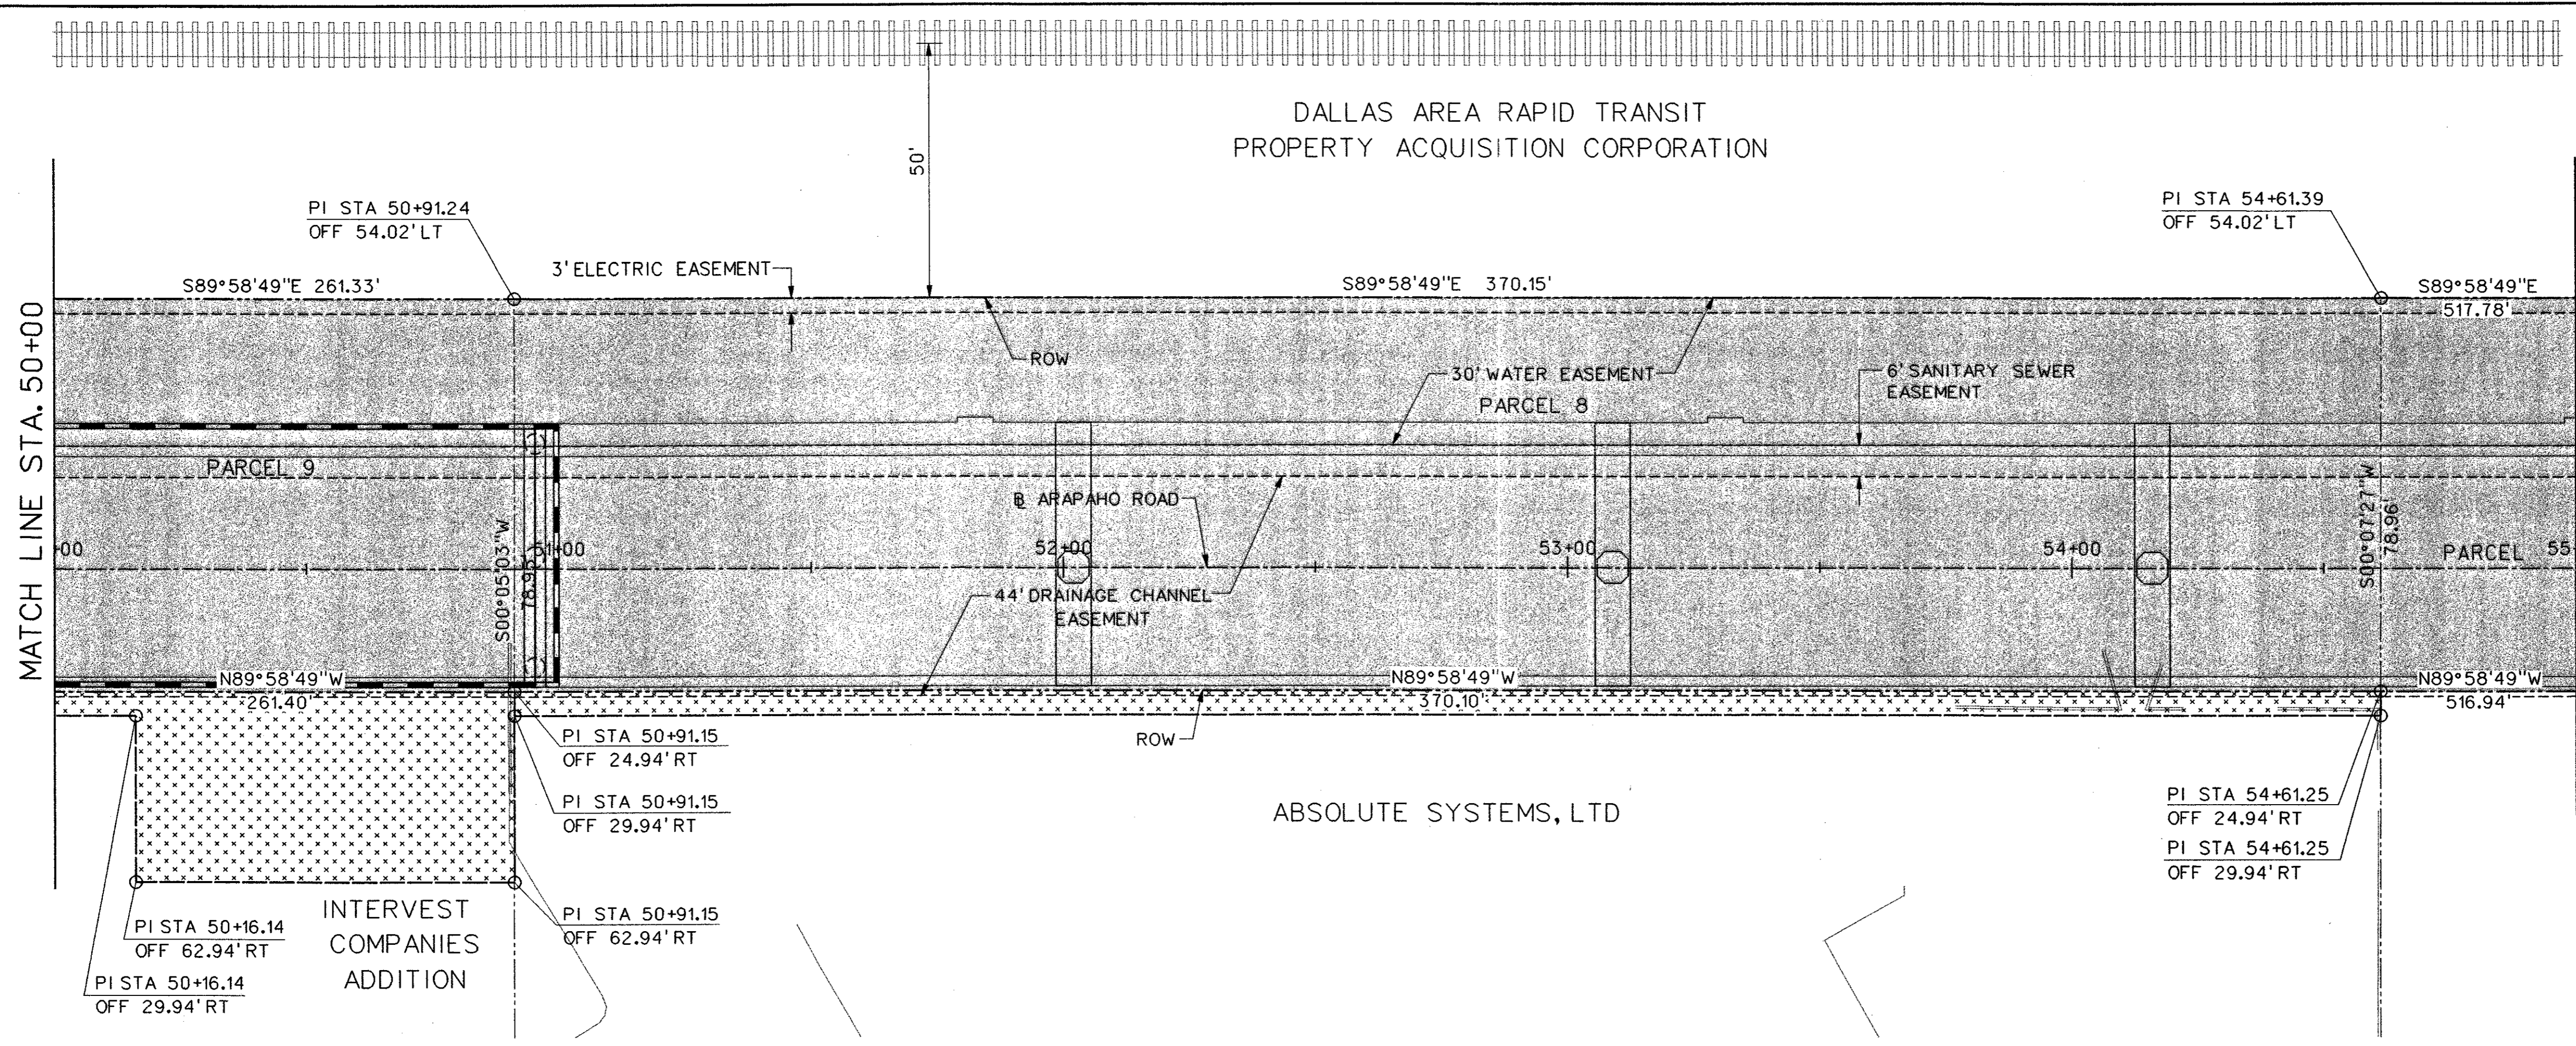

NO.		DATE	REVISION	APPROV.
HNTB ARCHITECTS ENGINEERS PLANNERS <i>The HNTB Companies</i>				
ARAPAHO ROAD - PHASE III				
SURVEYOR BOULEVARD TO ADDISON ROAD				
RIGHT-OF-WAY MAP				
STA 50+00 TO STA 60+00				
TOWN OF ADDISON, TEXAS				
Design	JSN	Drawn	GFS	DATE
Check	JDH	Check	JSN	APRIL 04
SCALE	1" = 20'	PROJECT NO.	25768	SHEET NO.
				RW-3

29-JUN-2004 12:13 G:\25768-ph3\m\cds\ar3-row03.dgn