


**LEGEND:**

- STREET LIGHTING STANDARD, SEE NOTE 1
- PEDESTRIAN LIGHTING STANDARD
- COMBINATION STREET LIGHT STANDARD AND PEDESTRIAN LUMINAIRE
- CONDUIT, 2" SCH 40 PVC W/2#6, 1#6 GND (ROADWAY CIRCUIT)
- CONDUIT, 2" SCH 40 PVC W/2#6, 1#6 GND (PEDESTRIAN CIRCUIT)
- GROUND MOUNTED PULLBOX, TYPE A

**NOTES:**

1. CONTRACTOR TO INSTALL POLE FOUNDATIONS, CONDUIT, CIRCUIT CONDUCTORS AND STREET LIGHTING STANDARDS.
2. CONTRACTOR SHALL BORE AND TRENCH CONDUIT UNDER EXISTING PAVEMENT AND CONNECT TO EXISTING PULLBOX.
3. SEE SPECIFICATIONS FOR TOWN OF ADDISON LIGHTING DETAILS.
4. CABLE TO PROVIDE POWER TO PEDESTAL VOICE COMMUNICATION UNIT SHALL SHARE PEDESTRIAN LIGHT POLE CONDUIT TO POWER SOURCE AT STA 44+39. CONTRACTOR SHALL PROVIDE CABLE SIZE THAT IS ADEQUATE FOR LENGTH OF RUN. CABLE SHALL BE SUBSIDIARY TO ITEM PEDESTAL VOICE COMMUNICATION UNIT.

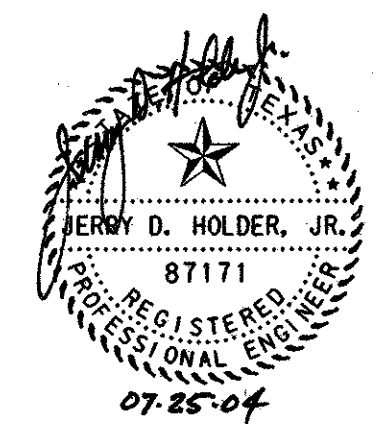

				154
NO.	DATE	REVISION	APPROV.	
<b>HNTB</b> ARCHITECTS ENGINEERS PLANNERS <i>The HNTB Companies</i>				
<b>ARAPAHO ROAD - PHASE III</b>				
SURVEYOR BOULEVARD TO ADDISON ROAD				
ILLUMINATION PLAN				
STA 37+00 TO STA 40+00				
TOWN OF ADDISON, TEXAS				
Design JSN	Drawn GFS	DATE	SCALE	PROJECT NO. SHEET NO.
Check JDH	Check JSN	APRIL 04	1" = 20'	25768 1L-2

29-JUN-2004 13:01  
G:\25768-ph3\h1\Cds\ur31102.dgn