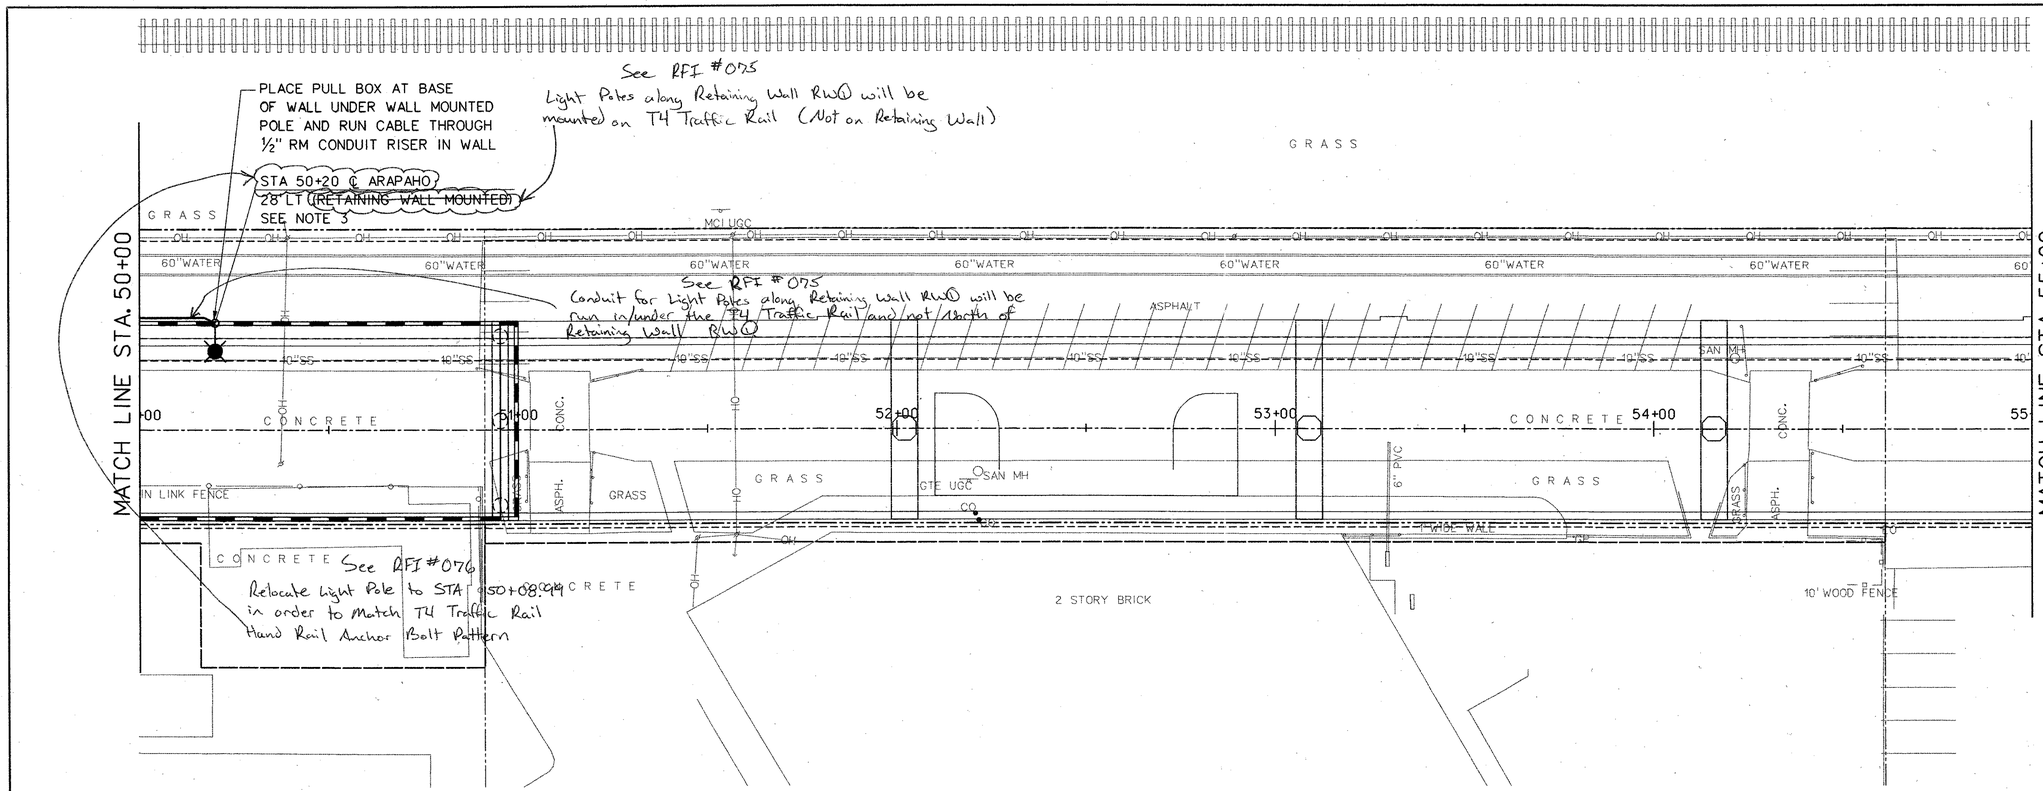

0 20 40 60 80
SCALE IN FEET

N

LEGEND:

- STREET LIGHTING STANDARD, SEE NOTE 1
- PEDESTRIAN LIGHTING STANDARD
- CONDUIT, 2" SCH 40 PVC W/2#6, 1#6 GND (ROADWAY CIRCUIT)
- GROUND MOUNTED PULLBOX, TYPE A

NOTES:

1. CONTRACTOR TO INSTALL POLE FOUNDATIONS, CONDUIT, CIRCUIT CONDUCTORS AND STREET LIGHTING STANDARDS.
2. SEE SPECIFICATIONS FOR TOWN OF ADDISON LIGHTING DETAILS.
3. SEE SHEET BR-68, LIGHT POLE ANCHORAGE DETAILS, FOR MOUNTING DETAIL.

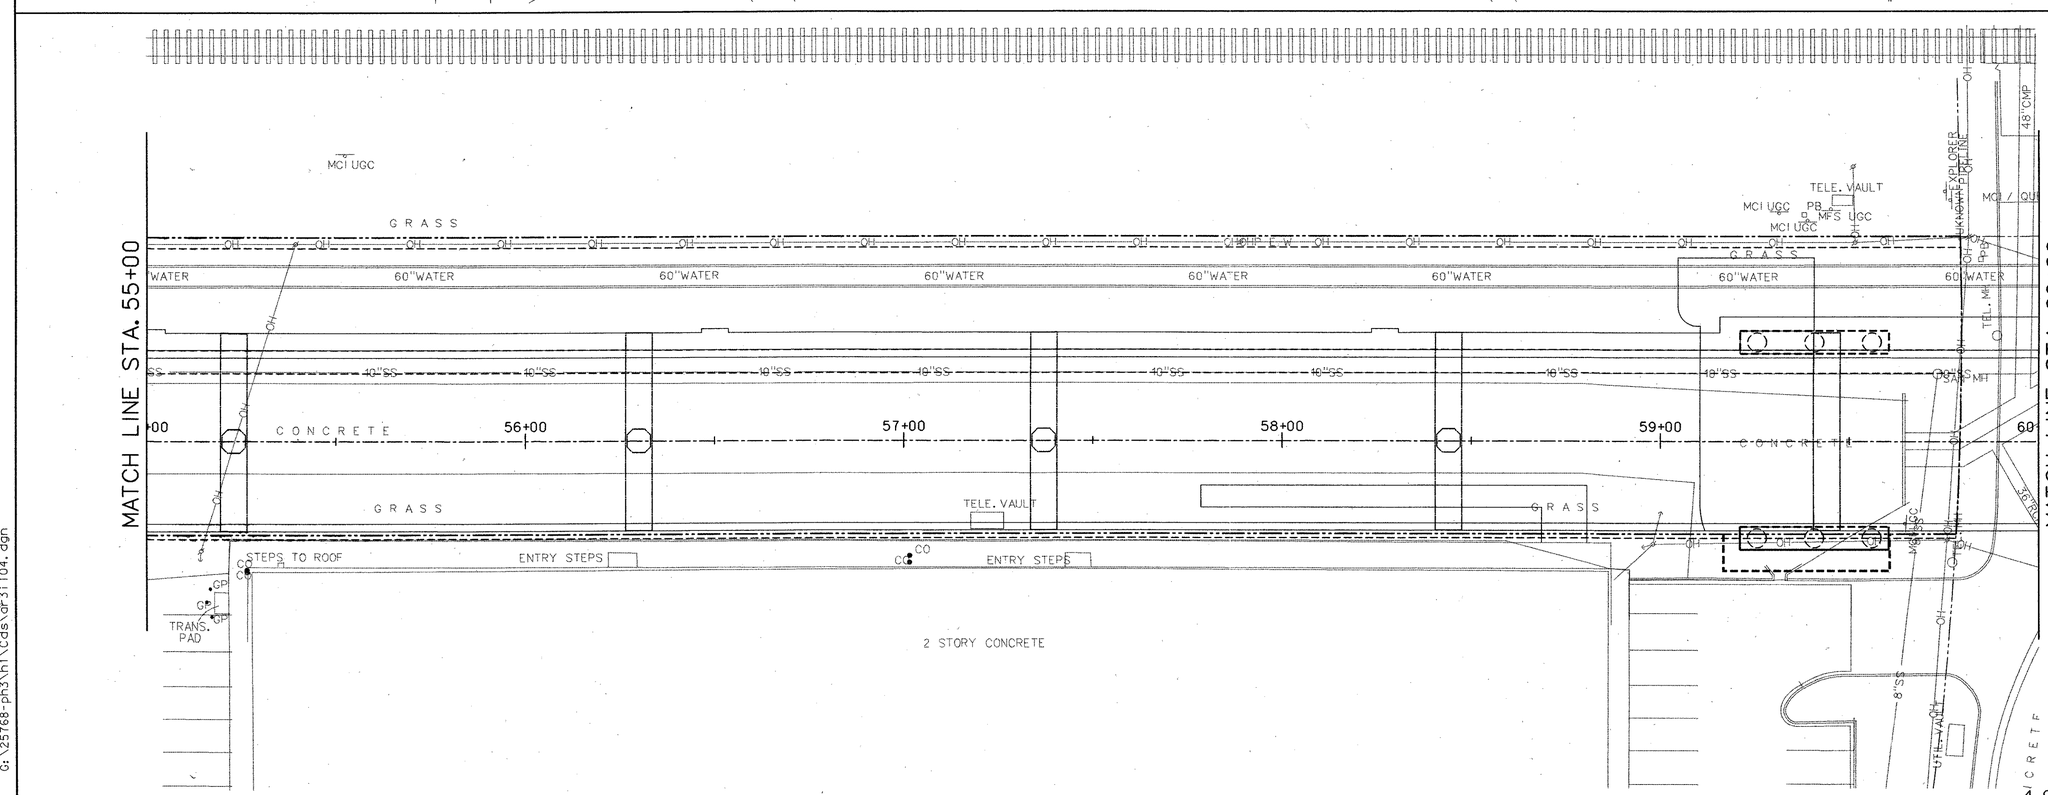

N

JERRY D. HOLDER, JR. 87171 REGISTERED PROFESSIONAL ENGINEER
07-25-04

156

NO.	DATE	REVISION	APPROV.

HNTB ARCHITECTS ENGINEERS PLANNERS The HNTB Companies

ARAPAHO ROAD - PHASE III

SURVEYOR BOULEVARD TO ADDISON ROAD

ILLUMINATION PLAN

STA 50+00 TO STA 60+00

TOWN OF ADDISON, TEXAS

Design JSN	Drawn GFS	DATE	SCALE	PROJECT NO.	SHEET NO.
Check JDH	Check JSN	APRIL 04	1"= 20'	25768	IL-4

29-JUN-2004 13:01
G:\25768-ph3\hi\Cds\dr3ii04.dgn