

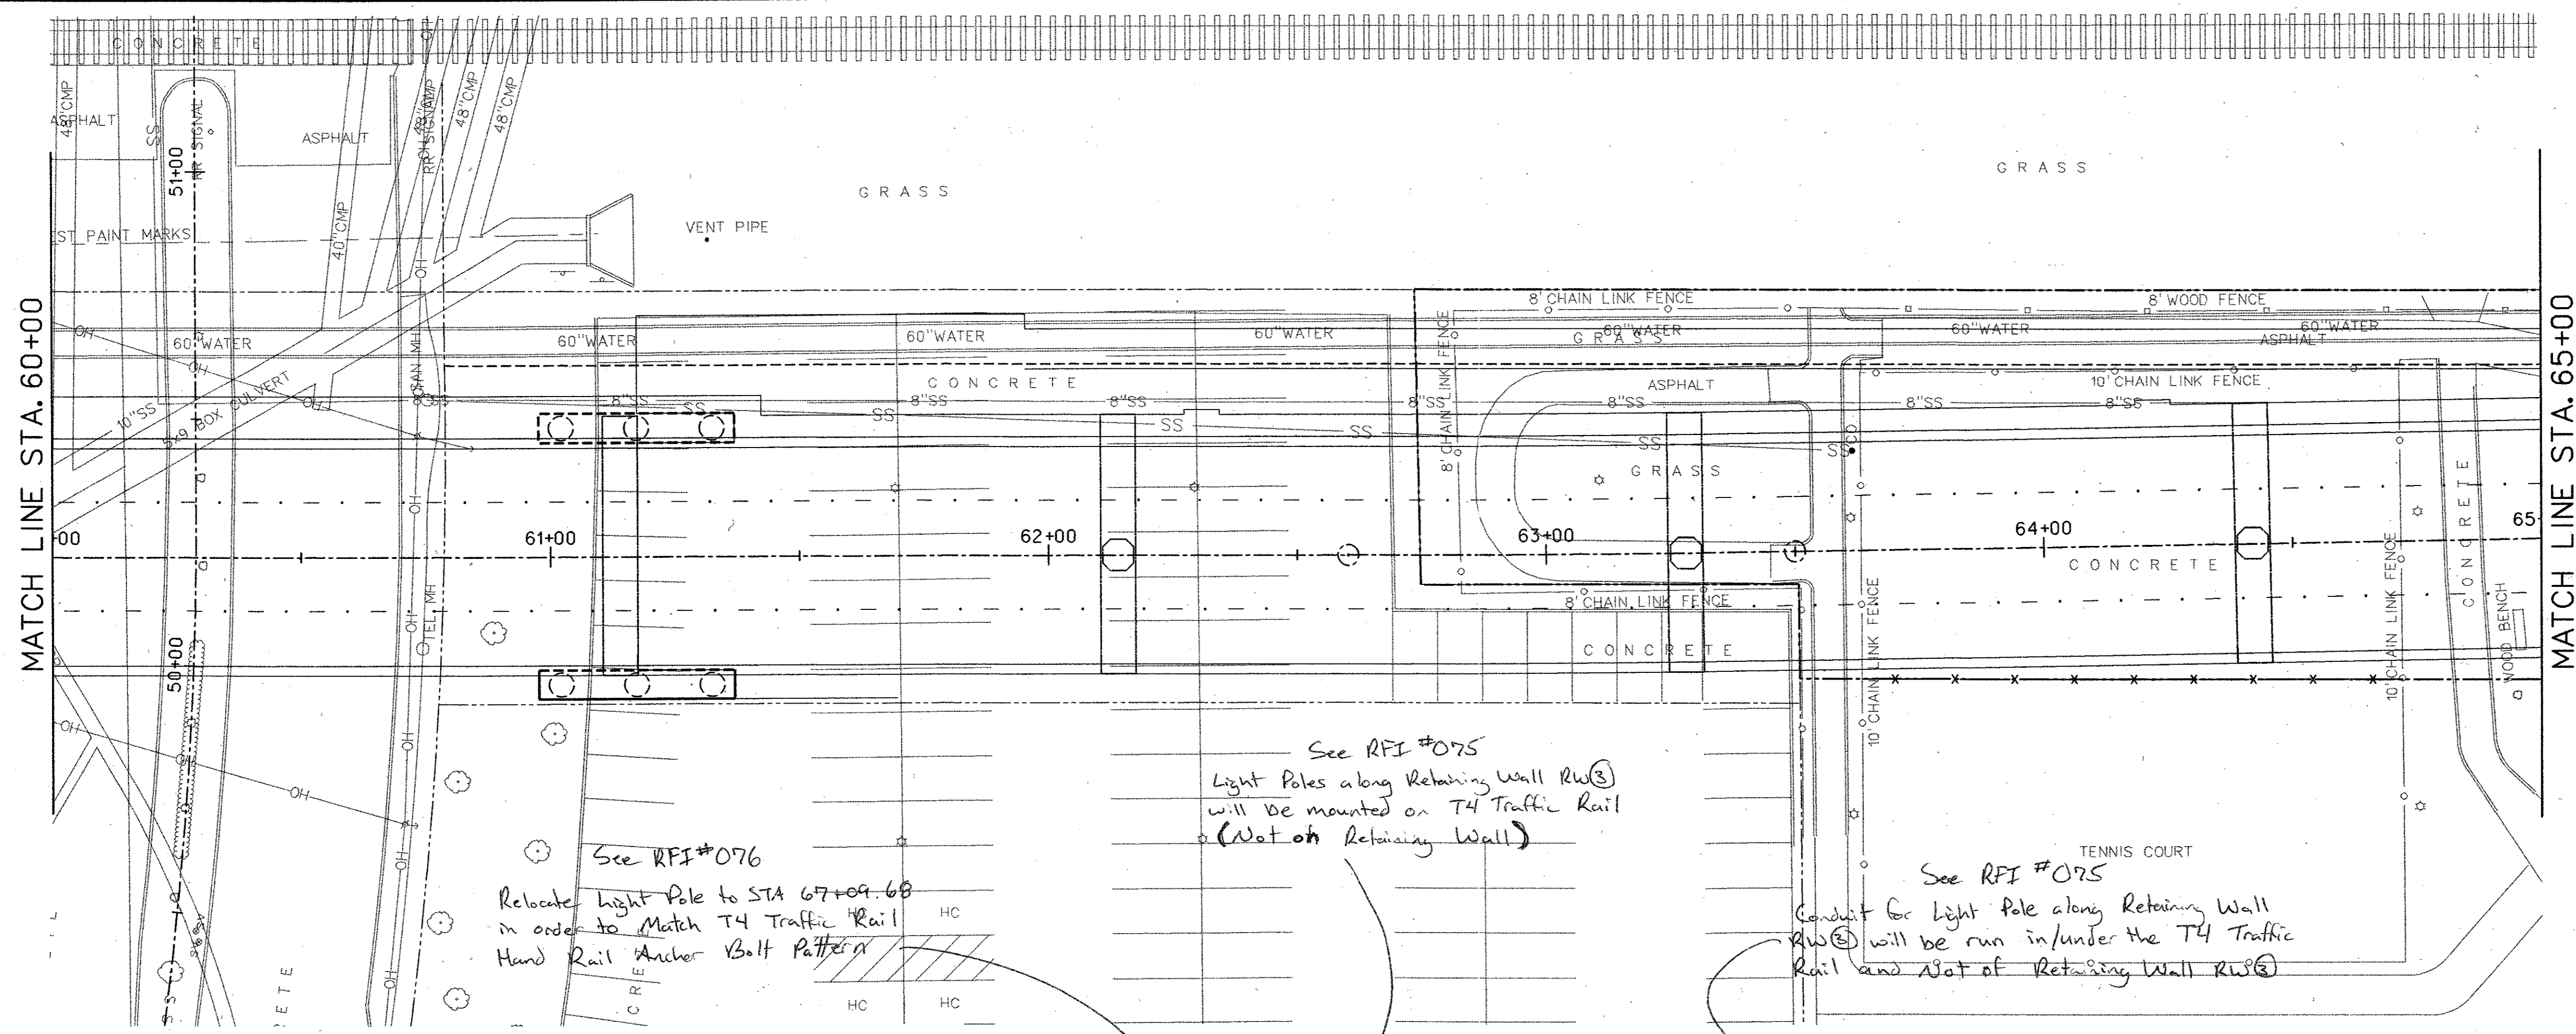


- LEGEND:**
- STREET LIGHTING STANDARD, SEE NOTE 1
  - PEDESTRIAN LIGHTING STANDARD
  - COMBINATION STREET LIGHT STANDARD AND PEDESTRIAN LUMINAIRE
  - CONDUIT, 2" SCH 40 PVC W/2#6, 1#6 GND (ROADWAY CIRCUIT)
  - CONDUIT, 2" SCH 40 PVC W/2#6, 1#6 GND (PEDESTRIAN CIRCUIT)
  - GROUND MOUNTED PULLBOX, TYPE A
  - 70W WALL MOUNTED LUMINAIRE

- NOTES:**
1. CONTRACTOR TO INSTALL POLE FOUNDATIONS, CONDUIT, CIRCUIT CONDUCTORS AND STREET LIGHTING STANDARDS.
  2. SEE SPECIFICATIONS FOR TOWN OF ADDISON LIGHTING DETAILS.

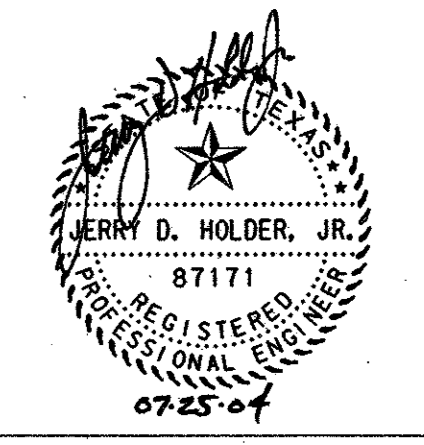

3. CABLE TO PROVIDE POWER TO PEDESTAL VOICE COMMUNICATION UNIT SHALL SHARE PEDESTRIAN LIGHT POLE CONDUIT TO POWER SOURCE AT STA 85+70±. CONTRACTOR SHALL PROVIDE CABLE SIZE THAT IS ADEQUATE FOR LENGTH OF RUN. CABLE SHALL BE SUBSIDIARY TO ITEM PEDESTAL VOICE COMMUNICATION UNIT.
4. SEE SHEET BR-68, LIGHT POLE ANCHORAGE DETAILS, FOR MOUNTING DETAIL.

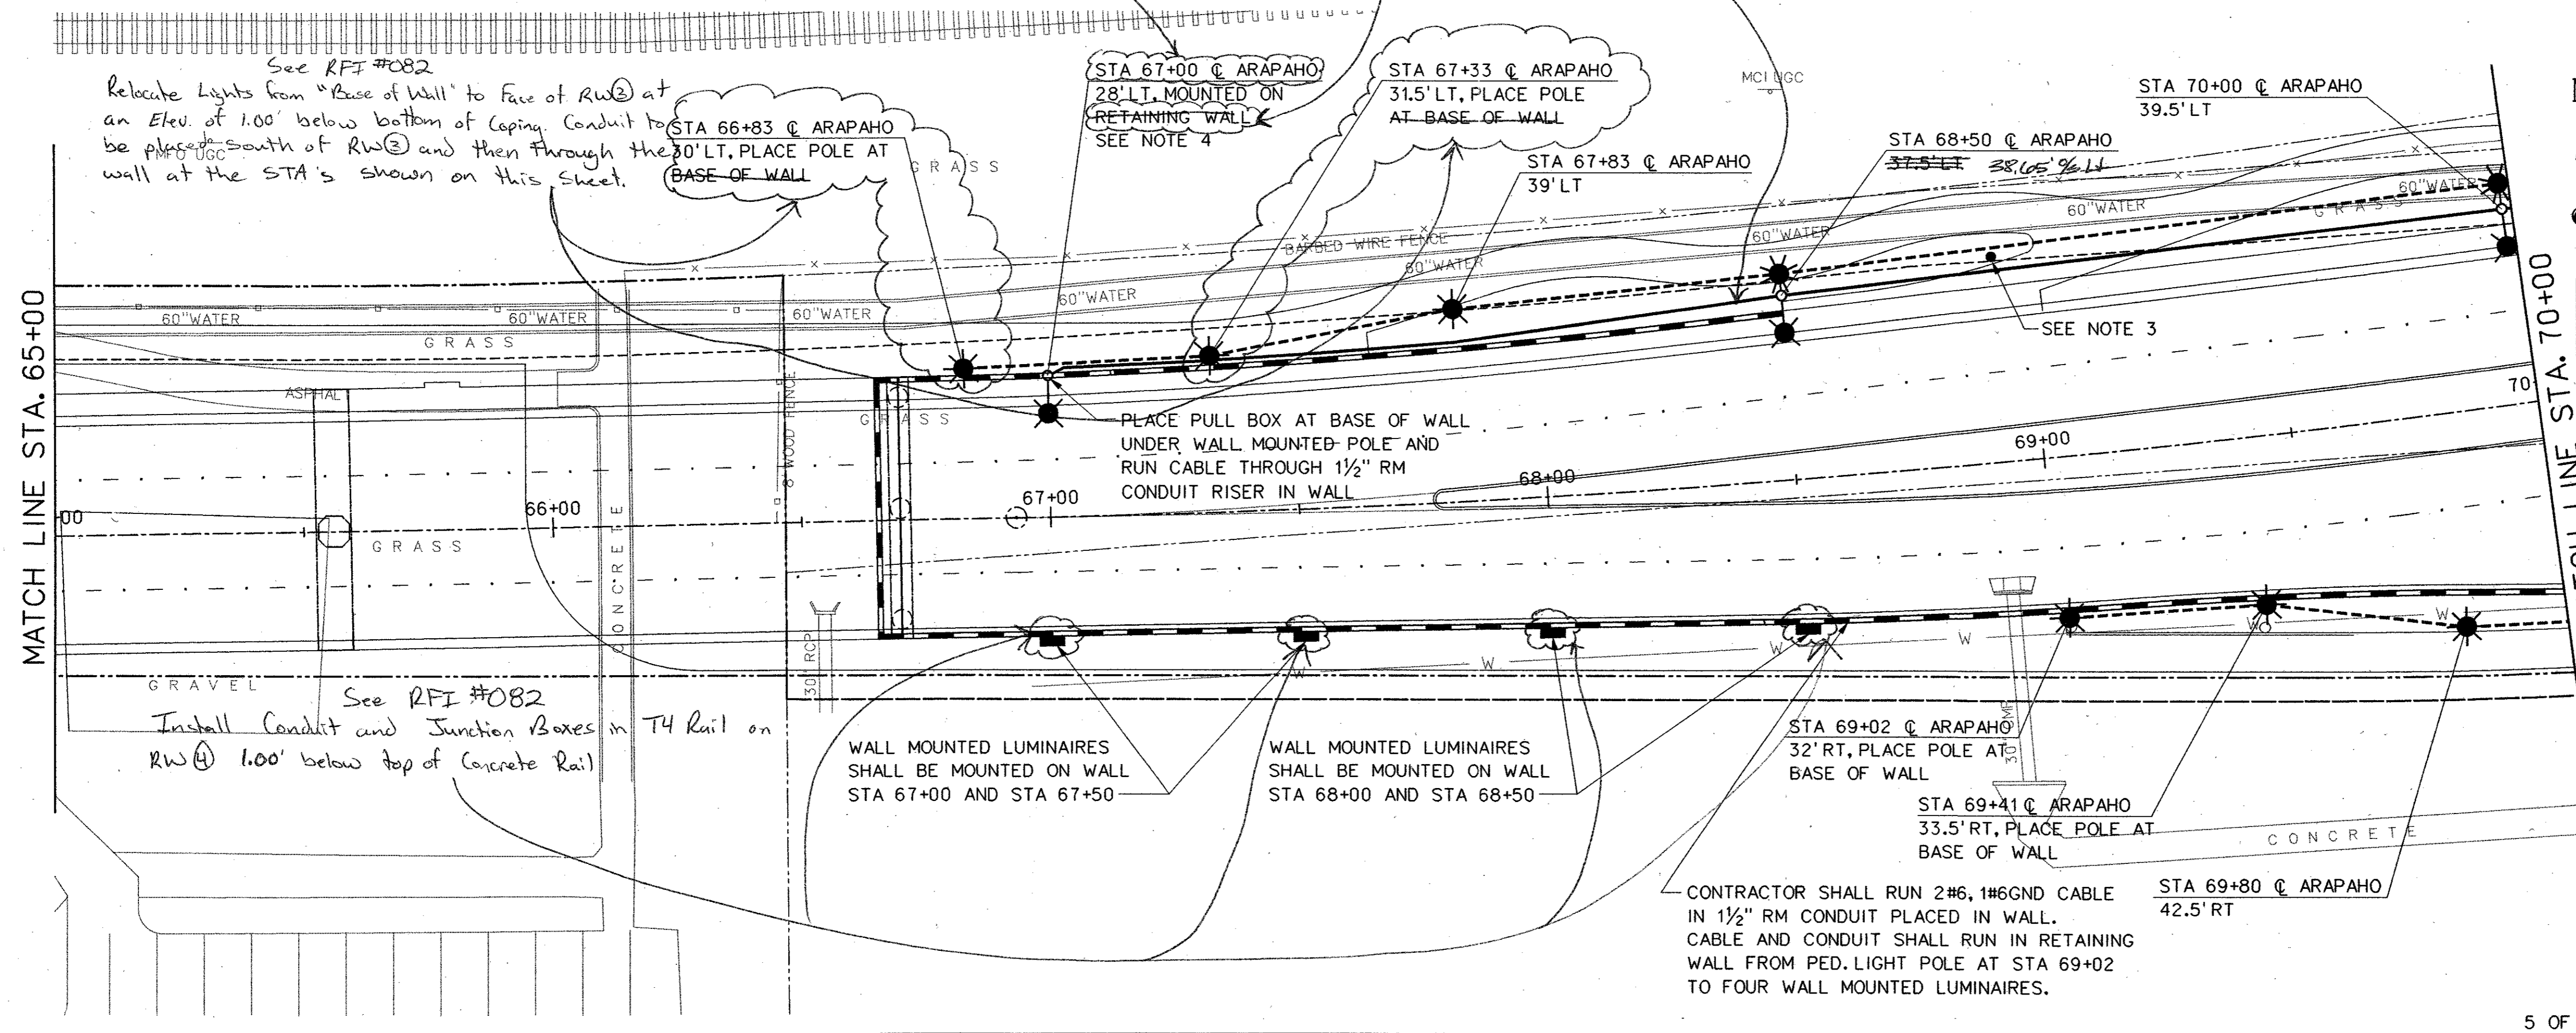

NO.		DATE	REVISION	APPROV.
<b>HNTB</b> ARCHITECTS ENGINEERS PLANNERS The HNTB Companies				
<b>ARAPAHO ROAD - PHASE III</b>				
SURVEYOR BOULEVARD TO ADDISON ROAD				
ILLUMINATION PLAN				
STA 60+00 TO STA 70+00				
TOWN OF ADDISON, TEXAS				
Design	JSN	Drawn	GFS	DATE
Check	JDH	Check	JSN	APRIL 04
SCALE	1" = 20'	PROJECT NO.	25768	SHEET NO.
				IL-5

29-JUN-2004 13:02  
G:\25768-PR3\N1\VC.dwg ar3:1.05.dgn