
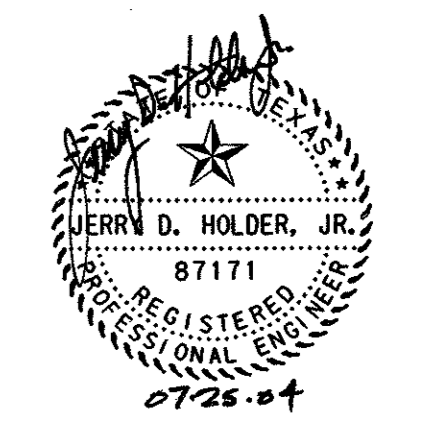
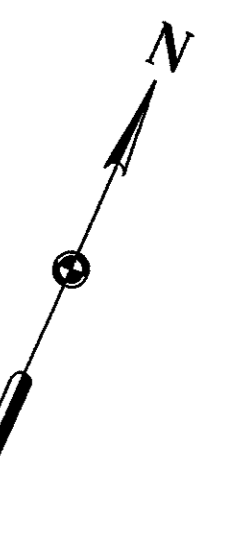
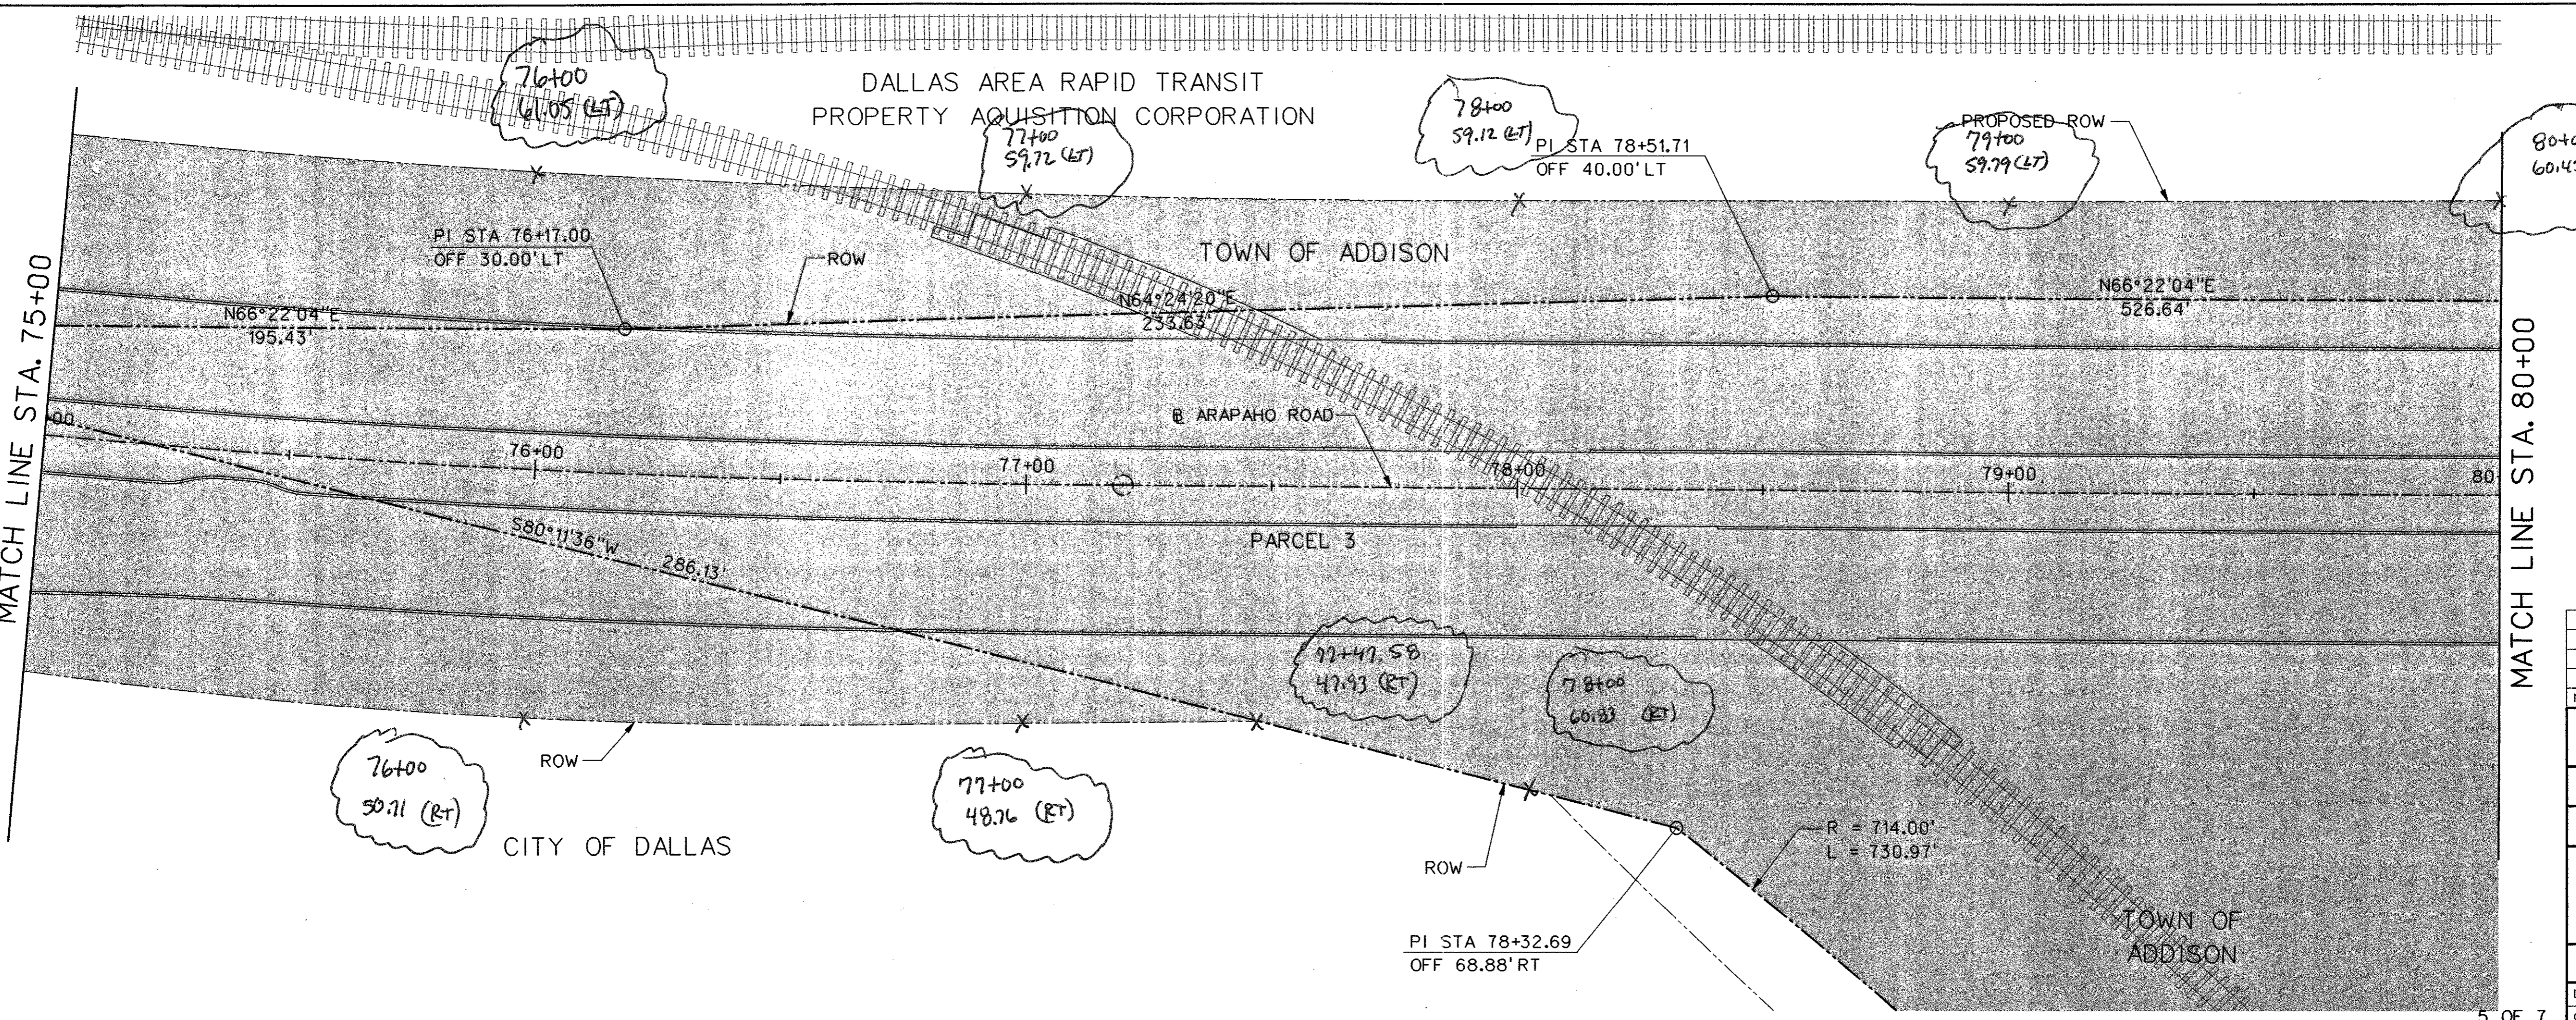


LEGEND

- ARAPAHO ROW
- TEMPORARY CONSTRUCTION EASEMENT
- PROPOSED R
- EXISTING ROW
- PROPOSED ROW
- TEMPORARY CONSTRUCTION EASEMENT
- EXISTING EASEMENT
- PROPOSED RETAINING WALL

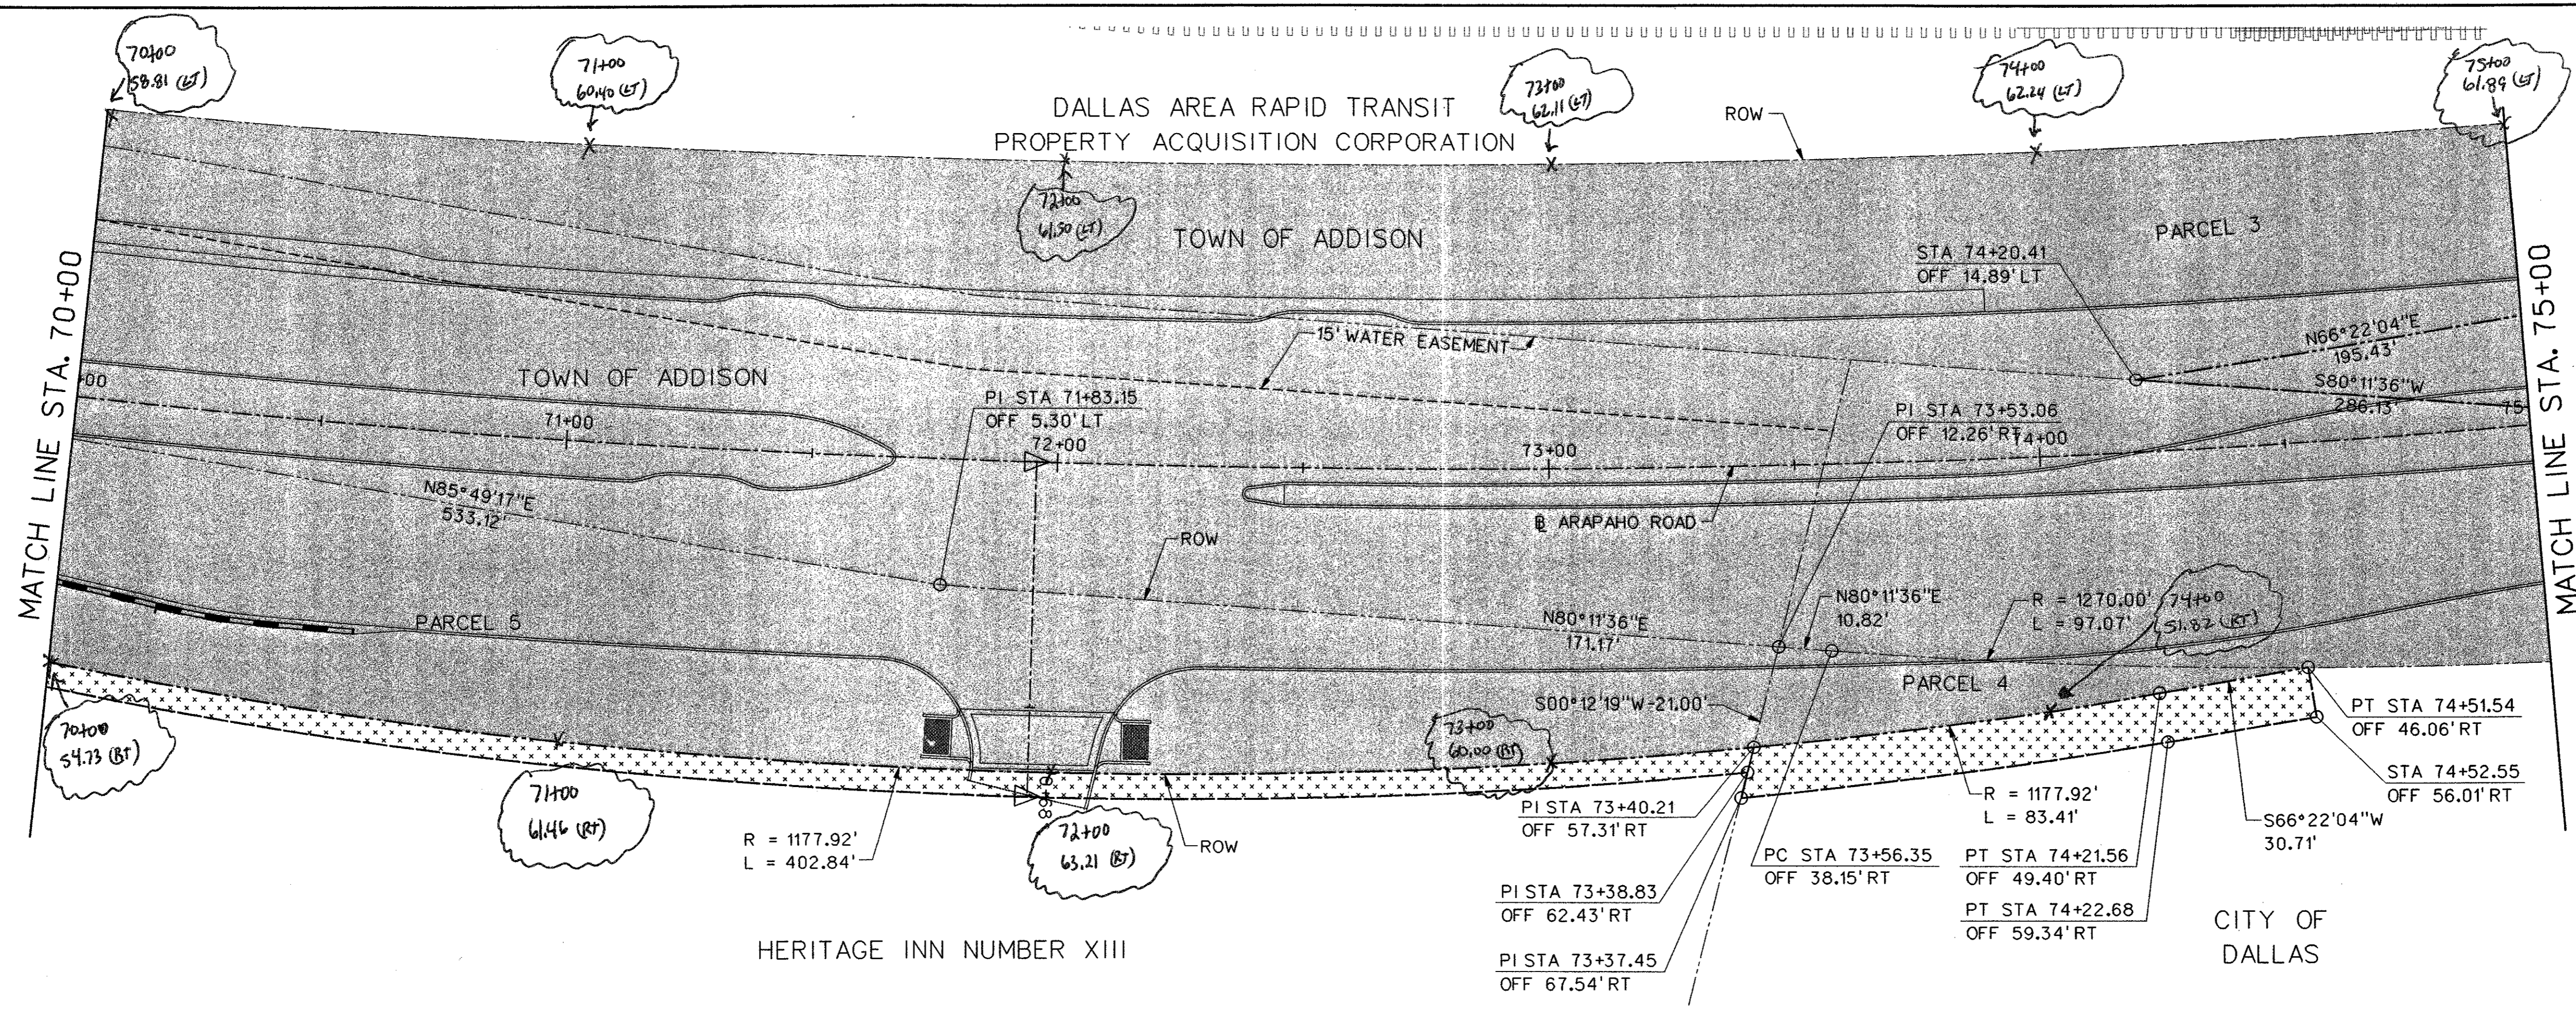

NO.	DATE	REVISION	APPROV.
HNTB ARCHITECTS ENGINEERS PLANNERS The HNTB Companies			
ARAPAHO ROAD - PHASE III			
SURVEYOR BOULEVARD TO ADDISON ROAD			
RIGHT-OF-WAY MAP			
STA 70+00 TO STA 80+00			
TOWN OF ADDISON, TEXAS			
Design JSN	Drawn GFS	DATE	SCALE
Check JDH	Check JSN	APRIL 04	1" = 20'
PROJECT NO.	25768	SHEET NO.	17
			RW-5

29-JUN-2004 12:13 G:\25768-Ph3\T\N\cde\ar3row05.dgn