
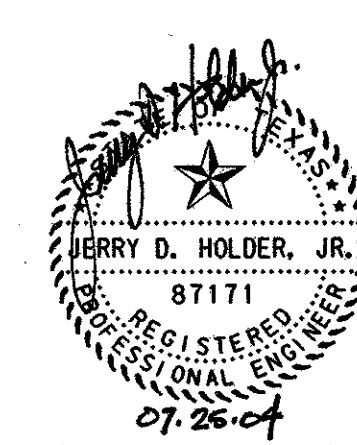


**LEGEND**

- ARAPAHO ROW
- TEMPORARY CONSTRUCTION EASEMENT
- PROPOSED  $\mathcal{R}$
- EXISTING ROW
- PROPOSED ROW
- TEMPORARY CONSTRUCTION EASEMENT
- EXISTING EASEMENT

See RFE # 003 / # 001  
ROW Control Information

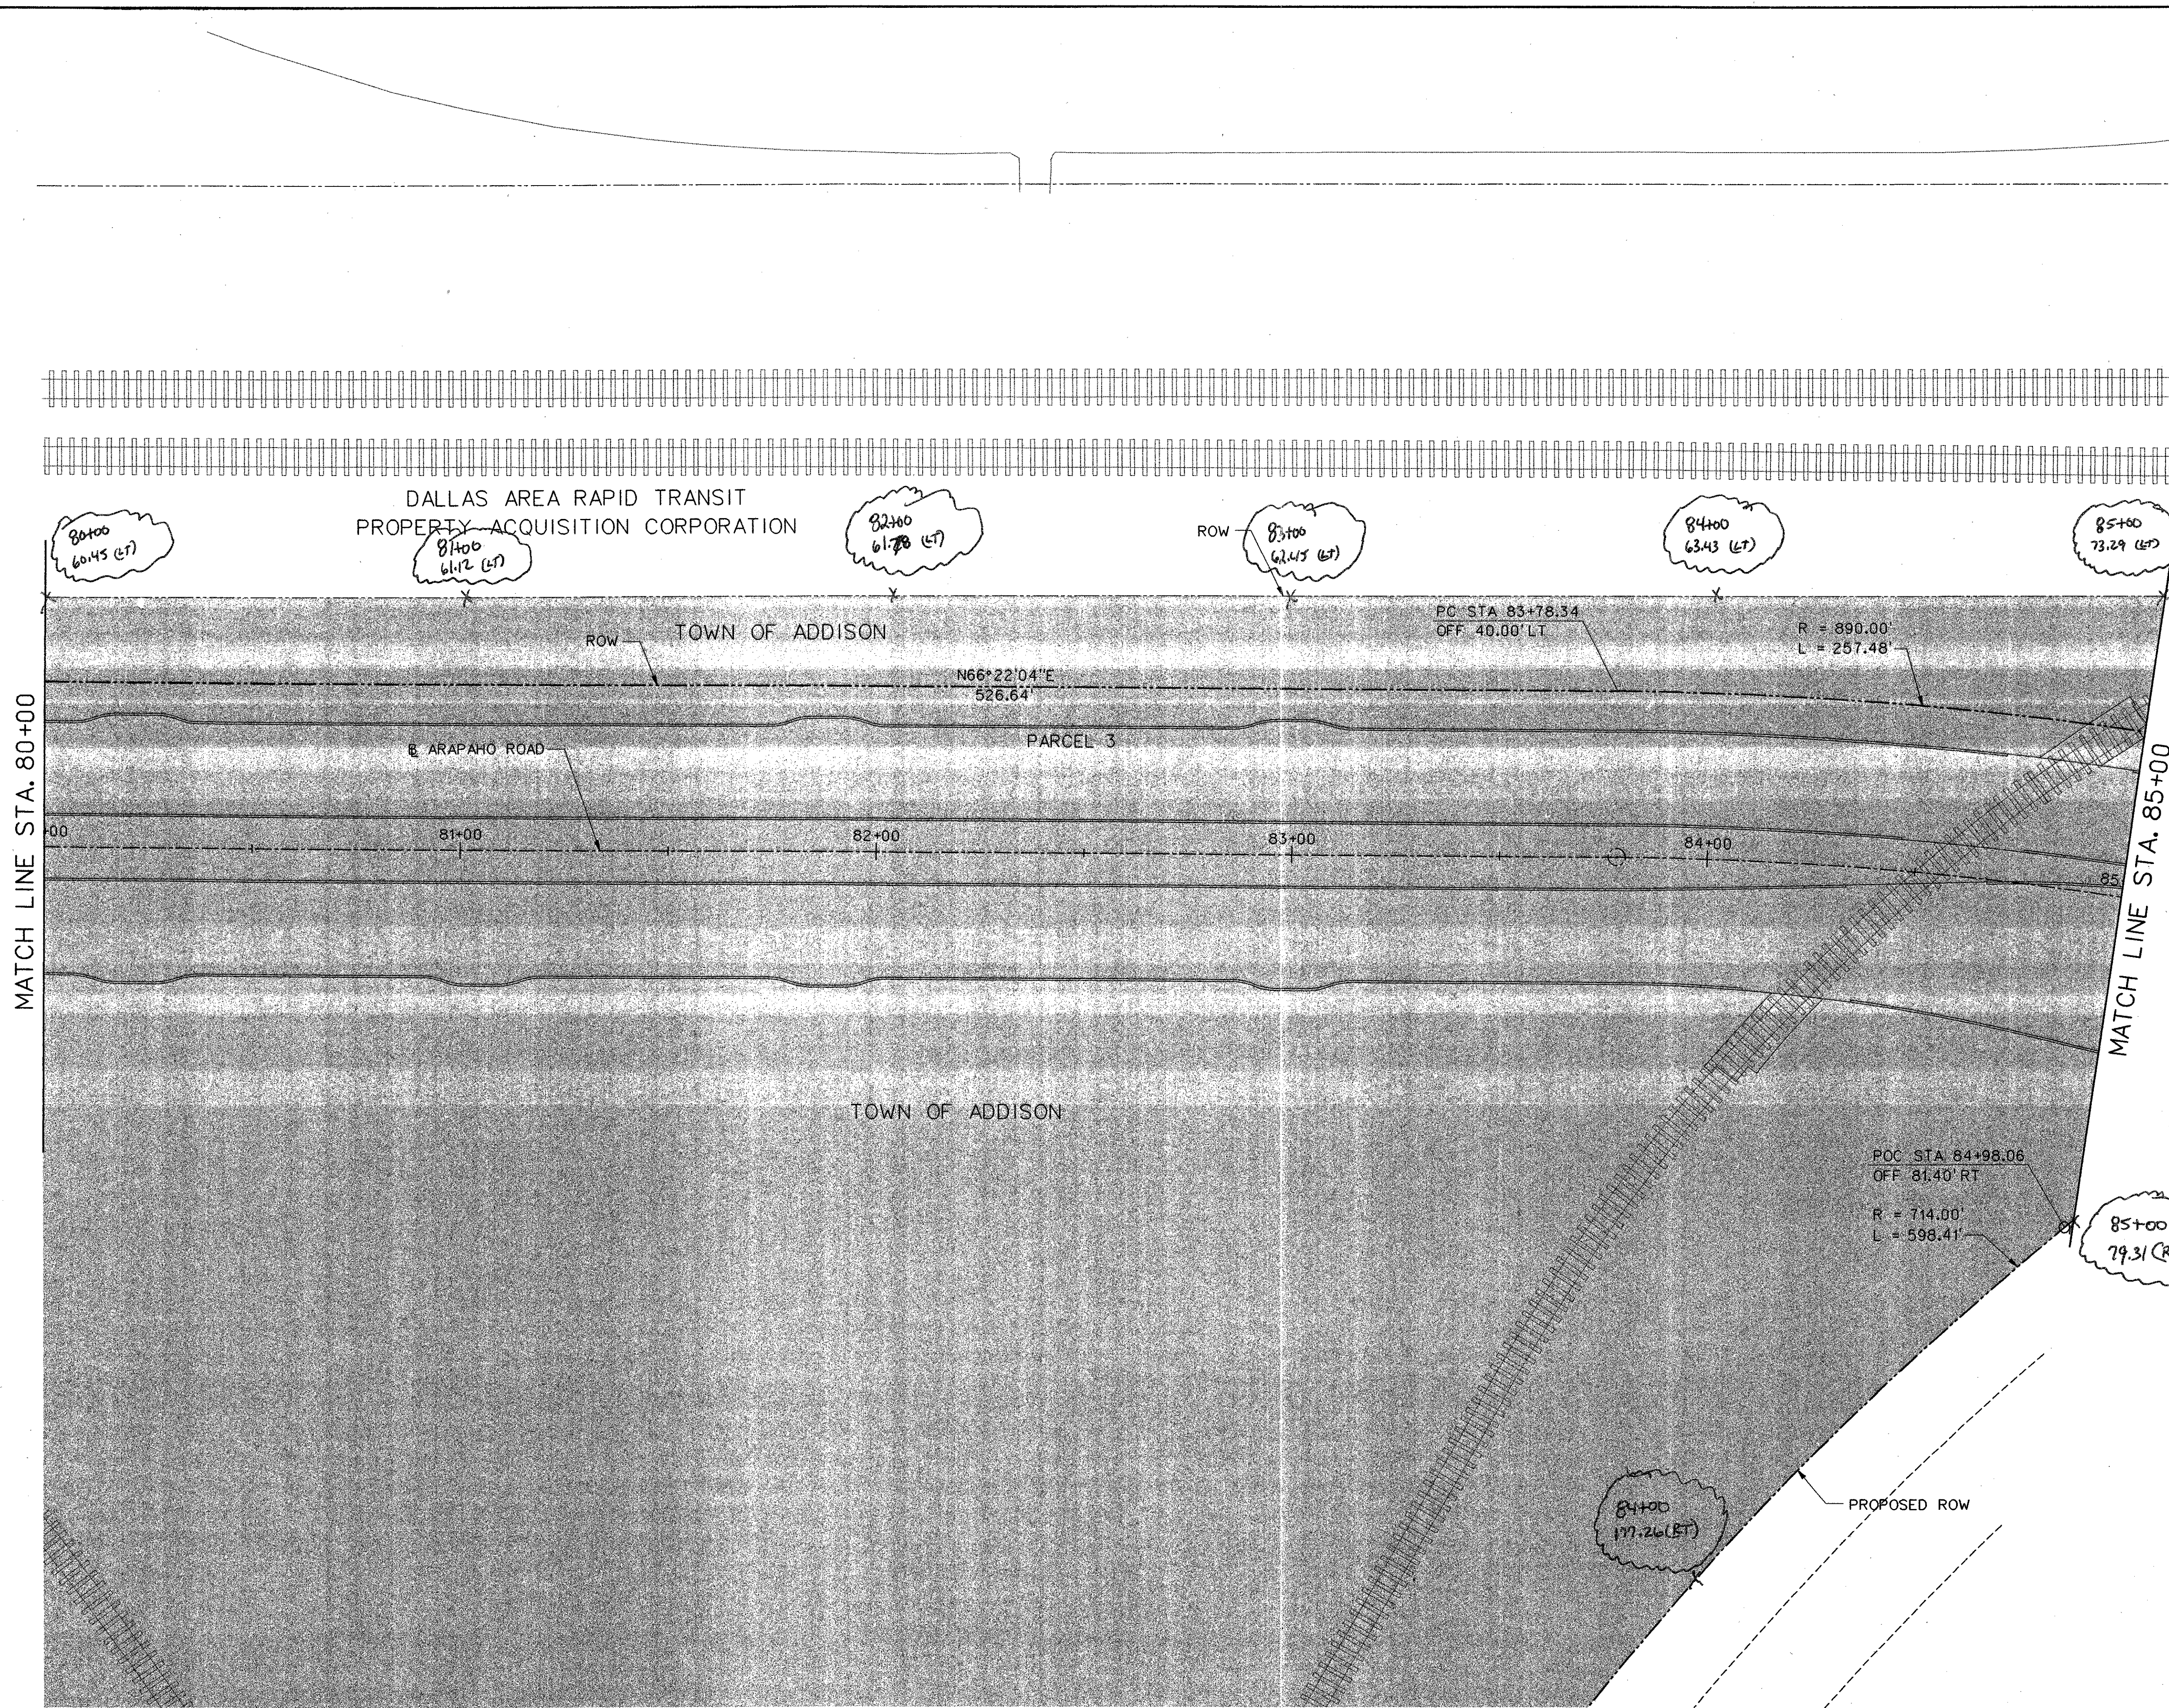

NO.		DATE	REVISION	APPROV.
<b>HNTB</b> ARCHITECTS ENGINEERS PLANNERS The HNTB Companies				
<b>ARAPAHO ROAD - PHASE III</b>				
SURVEYOR BOULEVARD TO ADDISON ROAD				
RIGHT-OF-WAY MAP				
STA 80+00 TO STA 85+00				
TOWN OF ADDISON, TEXAS				
Design	JSN	Drawn	GFS	DATE
Check	JDH	Check	JSN	APRIL 04
SCALE	PROJECT NO.	SHEET NO.		
1" = 20'	25768	RW-6		