

BAR TABLE	
BARS	SIZE
C	#5
B5	#5
D	#5
R1	#5
R2	#4
T	#4
U1	#5
U2	#5
Z	#4

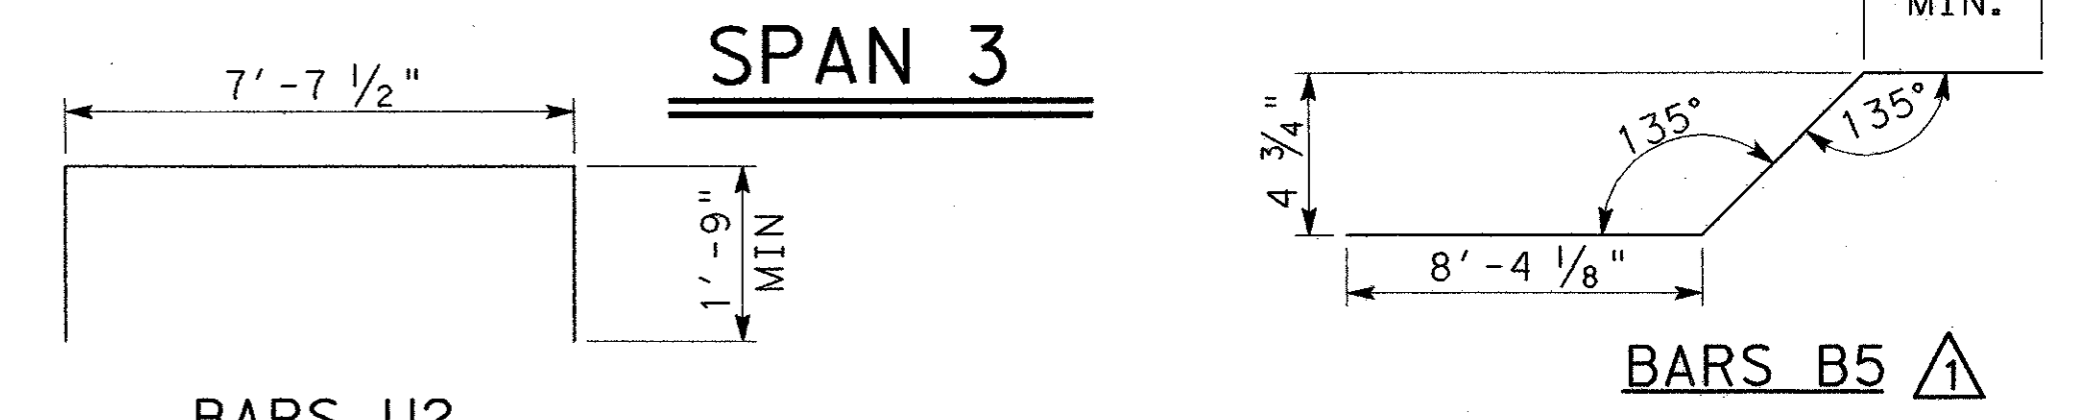
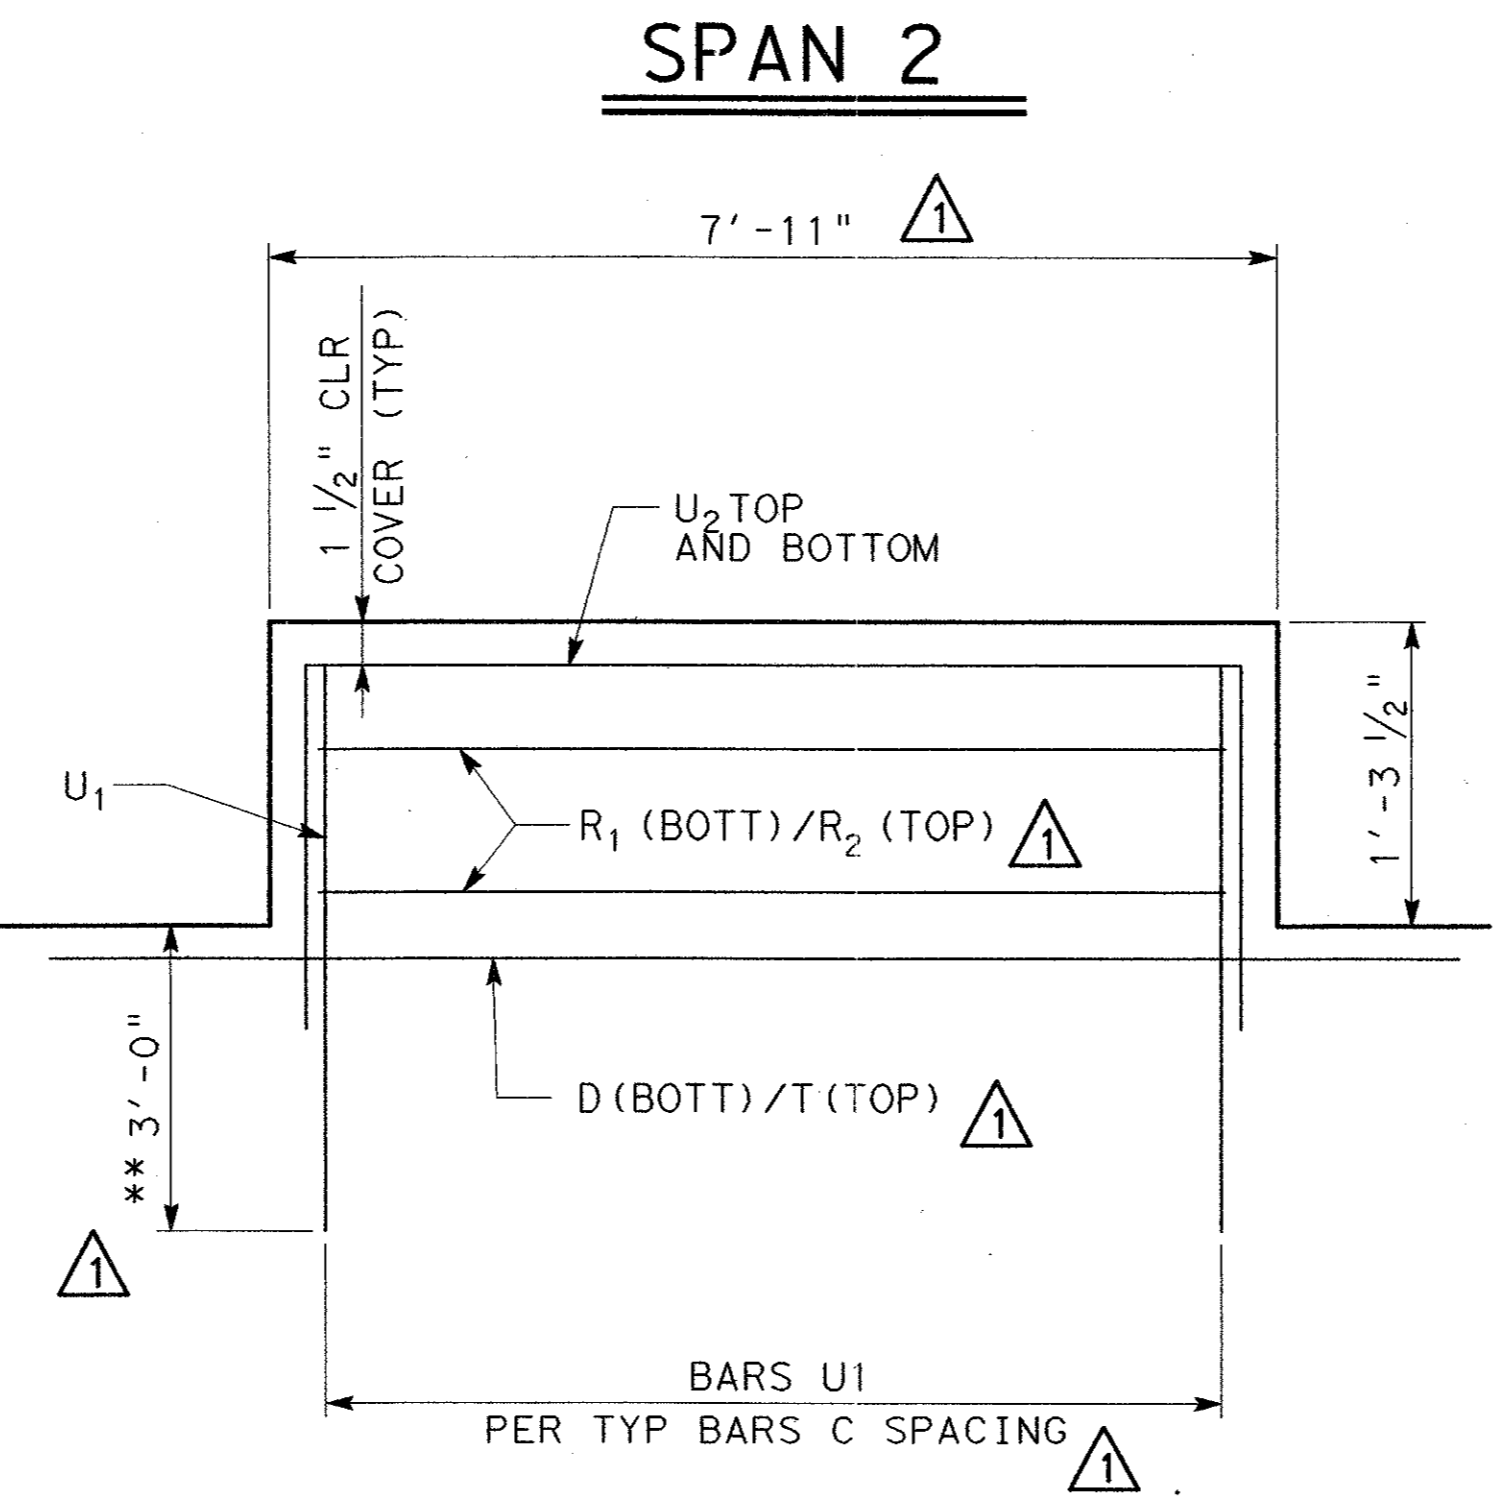
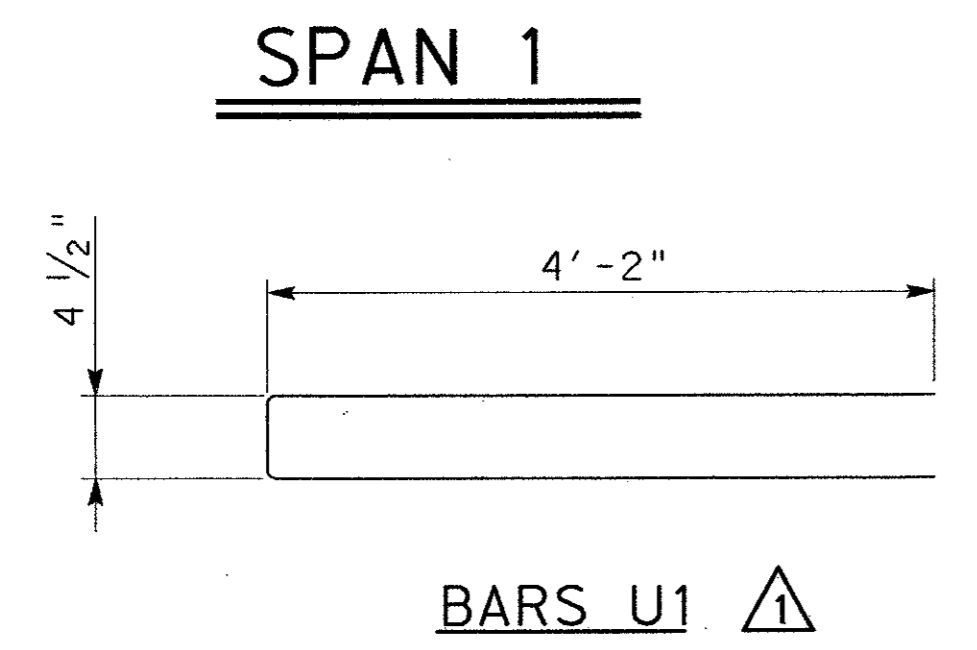


TABLE OF ESTIMATED QUANTITIES				
SPAN NO.	REINF CONC SLAB SF	① PRESTRESSED CONC BEAMS TYPE U54		② TOTAL REINF STEEL LB
		LF	* CY	
1	5,628	419.02	139.0	36,582
2	5,618	411.85	138.7	36,517
3	5,628	411.85	139.0	36,582
TOTAL	16,874	1,242.72	416.7	109,681

- ① BEAM LENGTHS SHOWN ARE BOTTOM BEAM FLANGE LENGTHS WITH ADJUSTMENTS MADE FOR BEAM SLOPE.
 - ② REINFORCING STEEL WEIGHT IS CALCULATED USING AN APPROXIMATE FACTOR OF 6.5 LBS/SF.
- * FOR CONTRACTORS INFO ONLY

** MIN. EMBEDMENT INTO DECK SLAB

DETAIL A

GENERAL NOTES:

1. DESIGNED IN ACCORDANCE WITH "STANDARD SPECIFICATIONS FOR HIGHWAY BRIDGES", 16TH EDITION 1996, WITH INTERIM SPECIFICATIONS.
2. REFER TO UBA, UBB, UBNS STANDARD FOR BEAM AND BEARING PAD DETAILS.
3. REFER TO UBMS STANDARD FOR THICKENED SLAB END DETAILS AND QUANTITY ADJUSTMENTS, AND FOR CONTROL JOINT AND DRIP BEAD DETAILS.
4. REFER TO UBMST STANDARD FOR SLAB DETAILS AT INVERTED TEE BENTS.
5. REFER TO PCP-C OR PMDF-C STANDARDS FOR DETAILS AND QUANTITY ADJUSTMENTS IF EITHER OF THESE OPTIONS ARE USED.
6. REFER TO SEJ-A (MOD) STANDARD SHEET FOR DETAILS TO BE PLACED WITH DECK.
7. CLASS "S" CONCRETE STRENGTH $f'_c=4000$ psi.
8. ALL REINFORCING STEEL SHALL BE GRADE 60.
9. SEE SLAB DETAILS SHEET 1 OF 4 FOR SECTION A-A & SHEET 4 OF 4 FOR SECTION E-E.
10. SEE T4(S) MOD SHEET FOR ADDITIONAL REINFORCEMENT.



1	05/24/04	ADDENDUM CHANGES	CRH
		REVISION	APPROV.

URS GREYSTONE CENTRE
5010 LBJ FREEWAY, SUITE 1500
DALLAS, TX 75254

ARAPAHO ROAD - PHASE III
SURVEYOR BOULEVARD TO ADDISON ROAD

SLAB PLAN
UNIT I

TOWN OF ADDISON, TEXAS

Design	Drawn	DATE	SCALE	PROJECT NO.	SHEET NO.
Check	Check	05-07-04		25768	BR-47