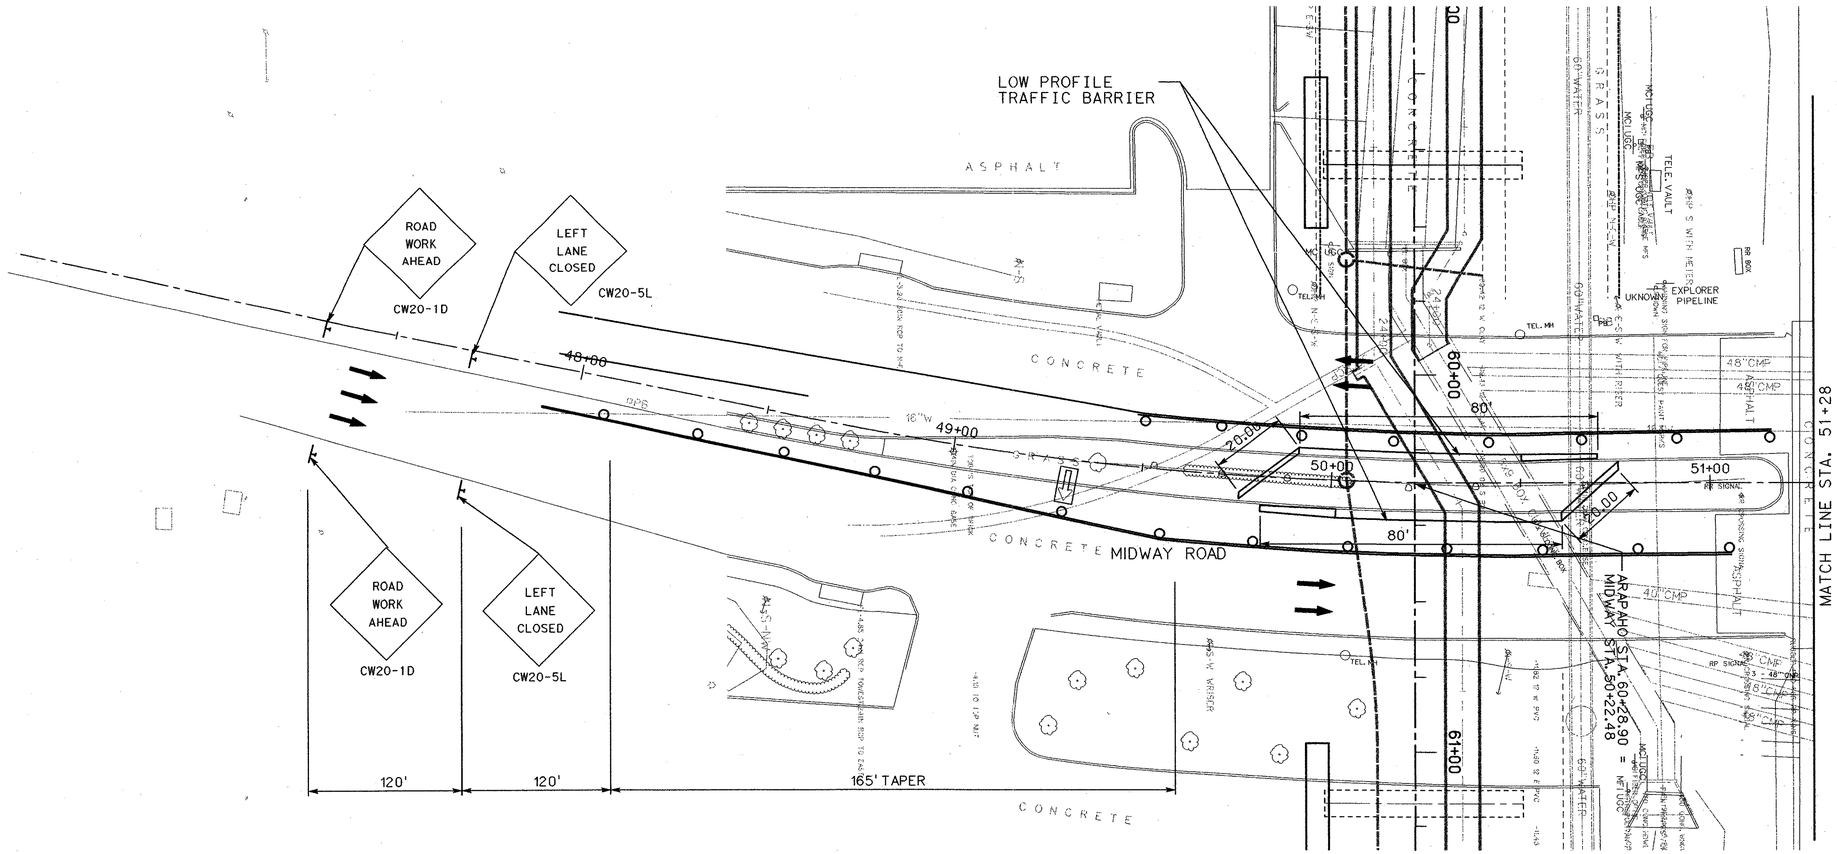

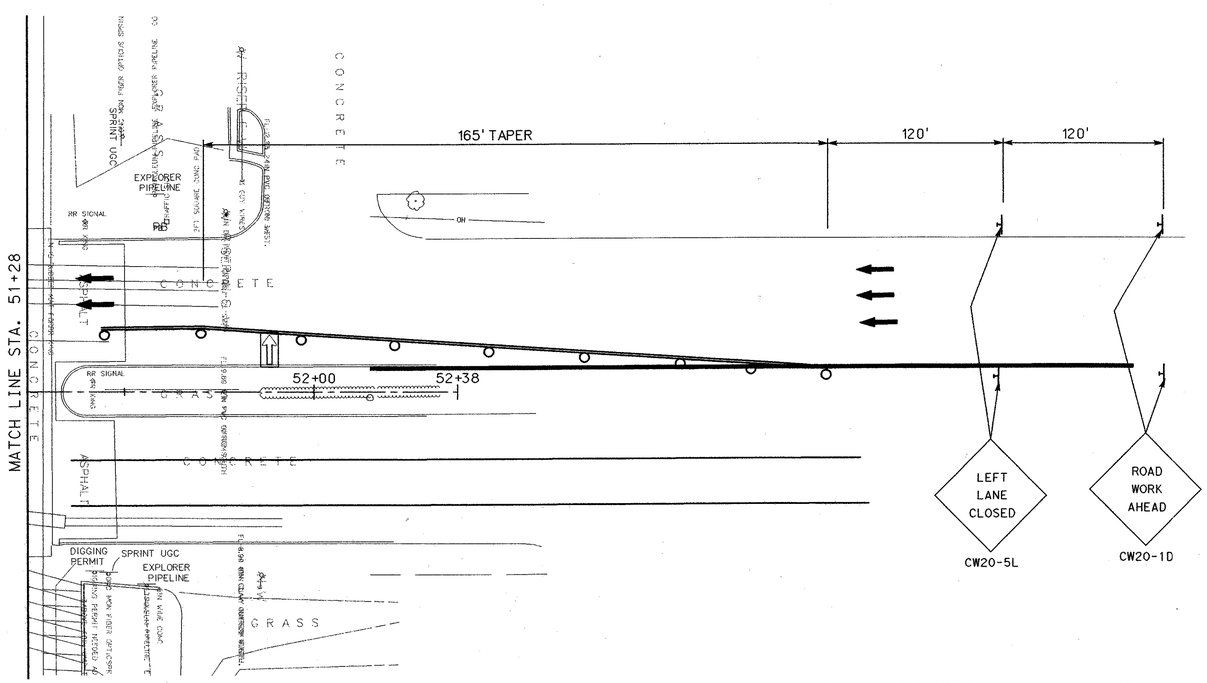

LEGEND

- ARROW BOARD
- CHANNELIZING DEVICE EVERY 25'
- TYPE III BARRICADE
- CONSTRUCTION SIGN
- DIRECTIONAL ARROW

NOTE:

1. ALL TRAFFIC CONTROL ELEMENTS INCLUDING THE RETURN OF MIDWAY ROAD MEDIAN TO IT'S ORIGINAL CONDITION IS THE RESPONSIBILITY OF THE CONTRACTOR AND SHALL BE INCLUDED IN THE UNIT BID PRICE FOR TRAFFIC CONTROL.

STATE OF TEXAS
BRUCE J. PRESTON
55387
REGISTERED
PROFESSIONAL ENGINEER
6/30/04

30B

NO.	DATE	REVISION	APPROV.
0	06/01/04	ADDENDUM CHANGES	BJP

URS
GREYSTONE CENTRE
3010 LBJ FREEWAY, SUITE 1300
DALLAS, TX 75234

ARAPAHO ROAD - PHASE III

SURVEYOR BOULEVARD TO ADDISON ROAD

TRAFFIC CONTROL PLAN
SINGLE LANE CLOSURE

TOWN OF ADDISON , TEXAS

Design	Drawn	DATE	SCALE	PROJECT NO.	SHEET NO.
Check	Check	05-07-04		25768	TC-6

6/30/2004 12:27:40 PM

\\urseddi01\data\projects\arapaho road bridge\cadd\structures\rcp\ar3*rcp04.dgn