
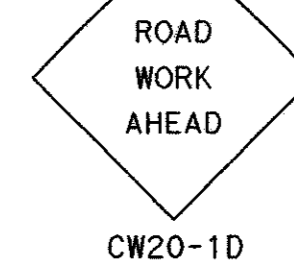
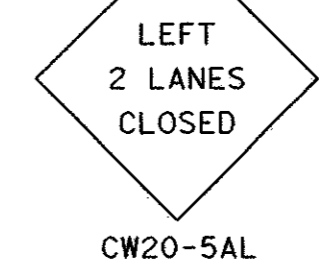


NOTE:

1. ALL TRAFFIC CONTROL ELEMENTS INCLUDING THE RETURN OF MIDWAY ROAD MEDIAN TO IT'S ORIGINAL CONDITION IS THE RESPONSIBILITY OF THE CONTRACTOR AND SHALL BE INCLUDED IN THE UNIT BID PRICE FOR TRAFFIC CONTROL.

LEGEND

- ARROW BOARD
- CHANNELIZING DEVICE EVERY 25'
- TYPE III BARRICADE
- CONSTRUCTION SIGN
- DIRECTIONAL ARROW

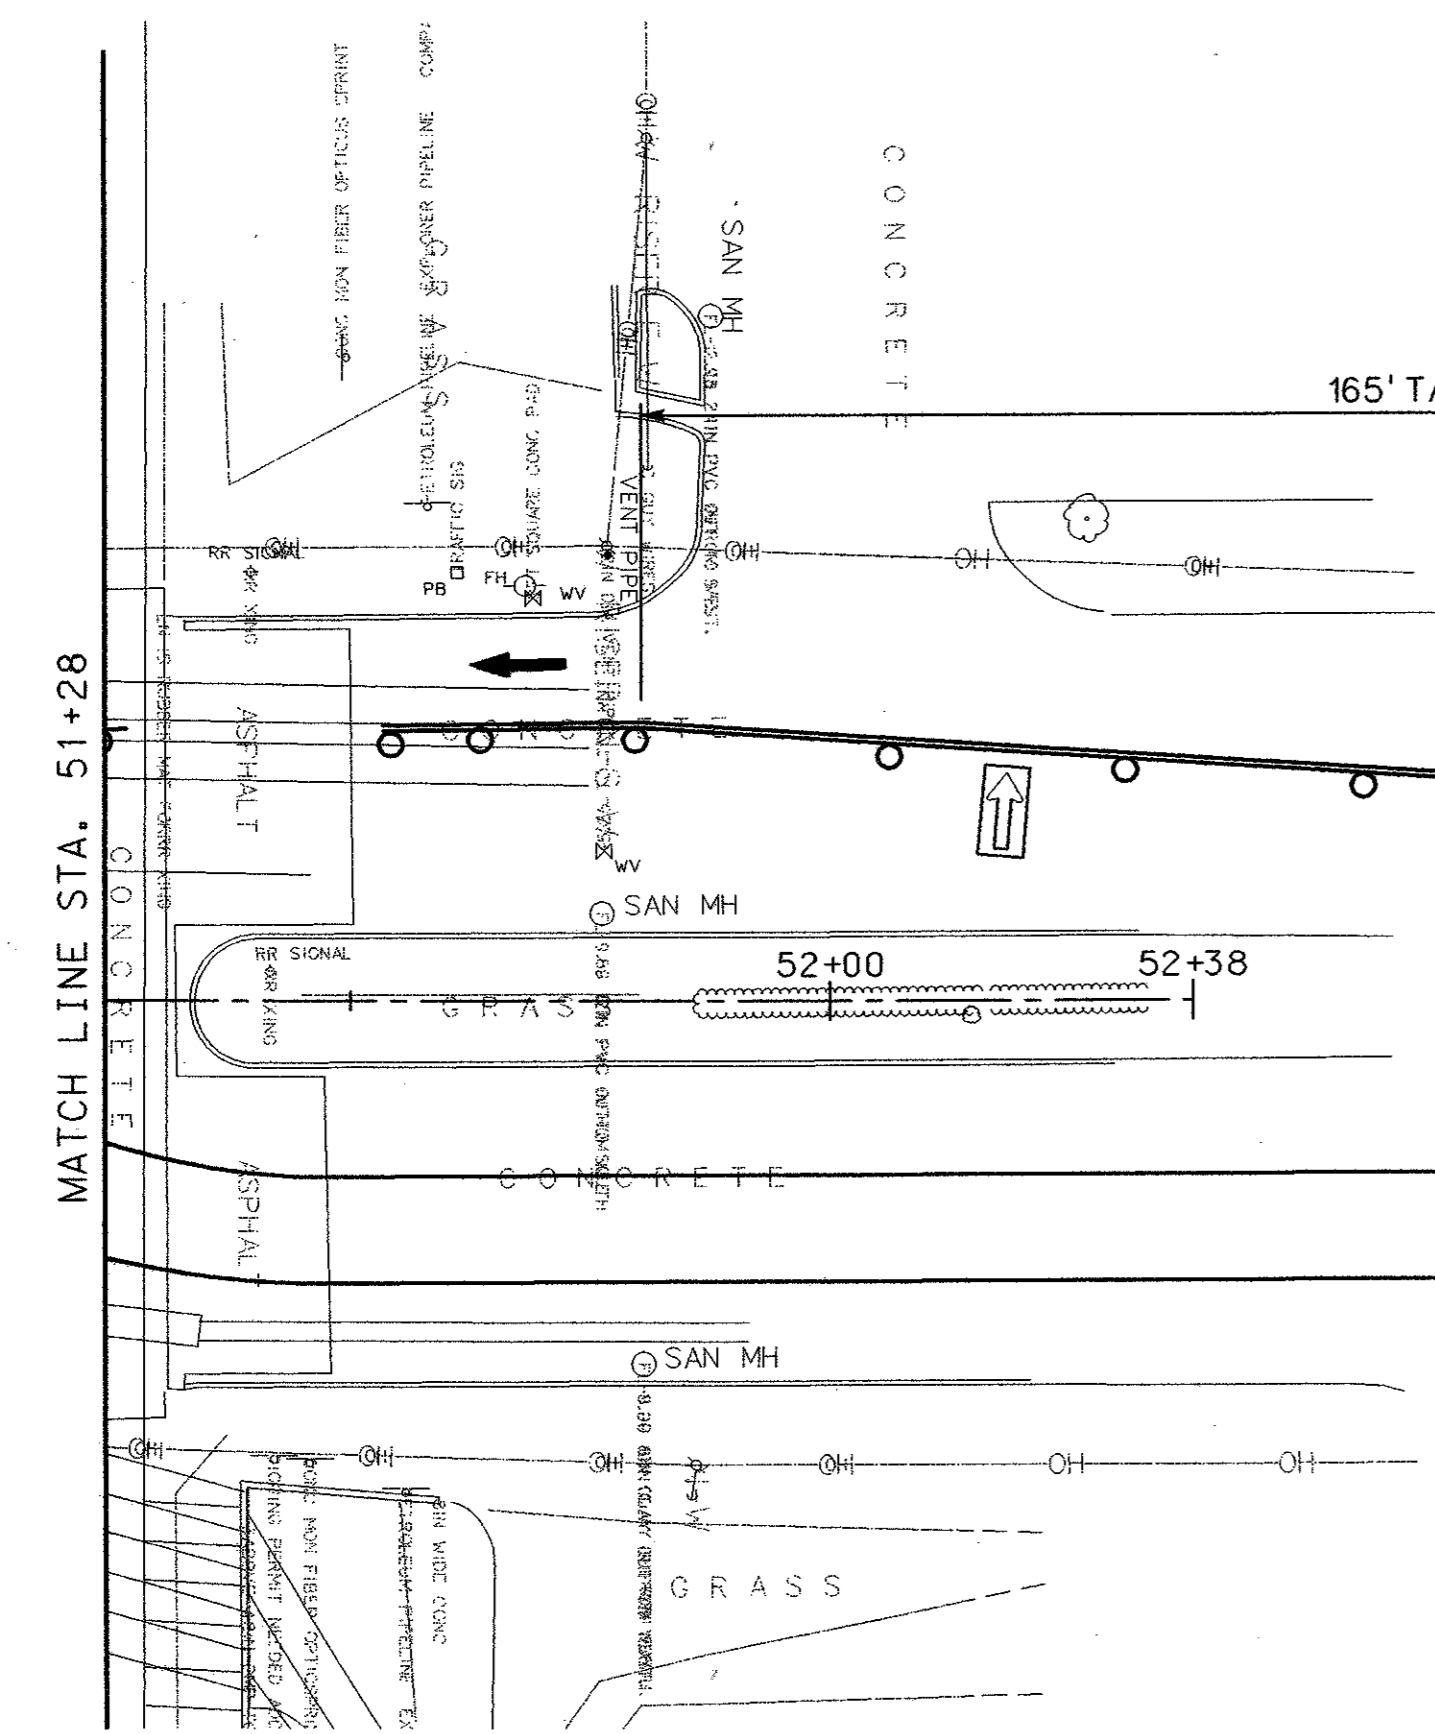

				30C	
0	06/01/04	ADDENDUM CHANGES		BUP	
NO.	DATE	REVISION		APPROV.	
URS GREYSTONE CENTRE 2010 LBJ FREEWAY, SUITE 1500 DALLAS, TX 75254					
ARAPAHO ROAD - PHASE III					
SURVEYOR BOULEVARD TO ADDISON ROAD					
TRAFFIC CONTROL PLAN NORTHBOUND DETOUR					
TOWN OF ADDISON, TEXAS					
Design	Drawn	DATE	SCALE	PROJECT NO.	SHEET NO.
Check	Check	05-07-04		25768	TC-7