


MATCH LINE  
STATION 54 + 00

- LEGEND:**
- TYPE A-1: NORTH ARCH FLOOD
  - TYPE A-2: SOUTH ARCH FLOOD
  - △ TYPE B: DIAPHRAGM LED
  - TYPE C: PEDESTRIAN HANDRAIL LED
  - TYPE D: DECK UNDERSIDE FLOOD
  - ▣ GROUND BOX
  - JUNCTION BOX
  - TYPE F: NORTH AND SOUTH ROADWAY LIGHTS (20')
  - TYPE G: NORTH ROADWAY LIGHTS (35')
  - RMC CONDUIT - SIZE PER CONDUIT & CABLE SCHEDULE
  - PVC CONDUIT - SIZE PER CONDUIT & CABLE SCHEDULE
  - ==== 2" PVC SCH 80 CONDUIT SLEEVE
  - PS "X": PEDESTAL SERVICE "X"
  - ⊠ FUSED DISCONNECT SWITCH

- GENERAL NOTES:**
1. PROVIDE LUMINAIRES, POLES, BASES, CONCRETE FOUNDATIONS AND CIRCUITRY AT EACH LOCATION SHOWN. REFER TO ILLUMINATION SUMMARY AND CONDUIT & CABLE SCHEDULE FOR ADDITIONAL INFORMATION.
  2. SEE LIGHT POLE DETAILS IN STRUCTURAL SECTION PLANS.
  3. ALL SPLICES SHALL BE MADE IN THE POLE BASE, FIXTURE BASE, IN THE GROUND BOX, OR JUNCTION BOX.
  4. ALL METAL CONDUITS, METAL ENCLOSURES, BOXES, POLE BASES AND LUMINAIRE HOUSING SHALL BE GROUNDED.
  5. ALL EXISTING UTILITY LOCATIONS ARE APPROXIMATE, CONTRACTOR SHALL VERIFY EXACT LOCATIONS.
  6. ALL STATION AND OFFSETS ARE FROM CENTERLINE OF ARAPAHO ROAD, AND ASSOCIATED MARKINGS.
  7. ALL STREET POLES SHALL BE CONTINUOUSLY GROUNDED TO THE ELECTRICAL SERVICE GROUND CONDUCTOR SYSTEM.

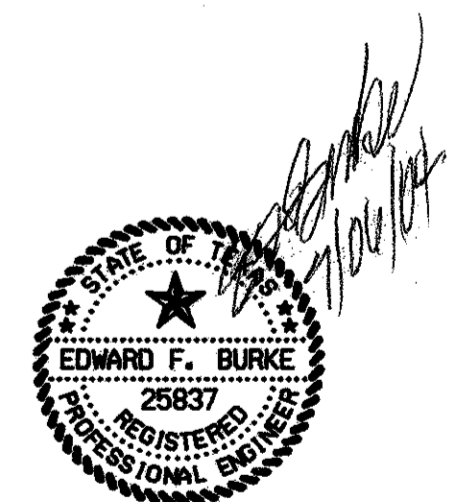

NO.		DATE	REVISION	APPROV.
322				
<b>URS</b>				
GREYSTONE CENTRE 2010 LBJ FRIEWAY, SUITE 1500 DALLAS, TX 75284				
<b>ARAPAHO ROAD - PHASE III</b>				
SURVEYOR BOULEVARD TO ADDISON ROAD				
BRIDGE LIGHTING PLAN 240 AND 120 V				
SHEET 1 OF 4				
TOWN OF ADDISON, TEXAS				
Design	EFB	Drawn	DT	DATE
Check	Check	05-07-04	25768	BL-1

7/1/2004 3:32:27 PM

\\urs-sd1\del\data\projects\arapaho\_road\105-06-04\ar3\3b\01e.dgn