

VIEW LOOKING NORTH


RECEPTACLE LOCATIONS:

SOUTH SIDE		
R1	59136.98	14' WEST OF POLE F8
R2	59153.98	3' EAST OF POLE F8
R3	60403.57	3' EAST OF POLE F10
R4	60451.23	3' WEST OF POLE F12
R5	61403.82	3' EAST OF POLE F14
R6	61420.82	14' EAST OF POLE F14

NORTH SIDE		
R1	59136.98	14' WEST OF POLE F7
R2	59153.98	3' EAST OF POLE F7
R3	60403.57	3' EAST OF POLE F9
R4	60451.23	3' WEST OF POLE F11
R5	61403.82	3' EAST OF POLE F13
R6	61420.82	14' EAST OF POLE F13

NOTES:

- 1) ALL RECEPTACLE LOCATIONS ARE APPROXIMATE. RECEPTACLES WILL BE LOCATED ON THE OUTSIDE OF TRAFFIC BARRIER (i.e. OUTSIDE OF ROADWAY). RECEPTACLES WILL BE LOCATED APPROXIMATELY HALF DISTANCE FROM ROADWAY TO TOP OF BARRIER, EVEN WITH CONNECTING CONDUIT RUN.
- 2) XXX LOCATED ON SOUTH SIDE OF BRIDGE
(XXX) LOCATED ON NORTH SIDE OF BRIDGE

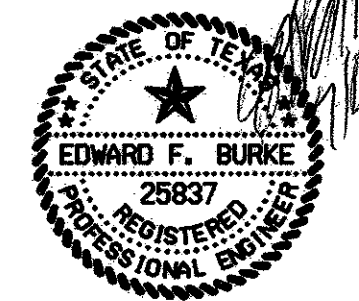

NO.		DATE	ADDENDUM CHANGES	CRH	APPROV.
1		05/24/04			
URS		GREYSTONE CENTRE 3010 LBJ FREEWAY, SUITE 1300 DALLAS, TX 75234			
ARAPAHO ROAD - PHASE III					
SURVEYOR BOULEVARD TO ADDISON ROAD					
BRIDGE LIGHTING MAIN SPAN					
TOWN OF ADDISON, TEXAS					
Design	EFB	Drawn	DT	DATE	SCALE
Check	Check			05-07-04	
PROJECT NO.	25768		SHEET NO.	BL-9	

330