


LEGEND

- ===== EXISTING CURB
- ===== PROPOSED CURB
- TP=XXX.XX TOP OF PAVEMENT ELEVATION
- TC=XXX.XX TOP OF CURB ELEVATION
- G=XXX.XX GUTTER ELEVATION
- CR CURB RETURN
- X FENCE
- FIRE HYDRANT
- ☼ LIGHT POLE
- POWER POLE
- MH SAN. SEWER MANHOLE
- ⊥ SIGN
- ☼ TL TRAFFIC SIGNAL
- ☼ VEGETATION
- ☼ TREE
- W — WATER LINE
- TEMPORARY CONSTRUCTION EASEMENT
- ▨ PROPOSED PAVING
- ▩ BRIDGE

- NOTES:**
1. ALL DIMENSIONS AND CALL OUTS ARE TO BACK OF CURB UNLESS OTHERWISE NOTED.
 2. SEE SHEET DT-05 FOR FENCE DETAIL.
 3. REFER TO SITEWORK AND LANDSCAPING PLANS FOR ADDITIONAL MEDIAN TREATMENTS.

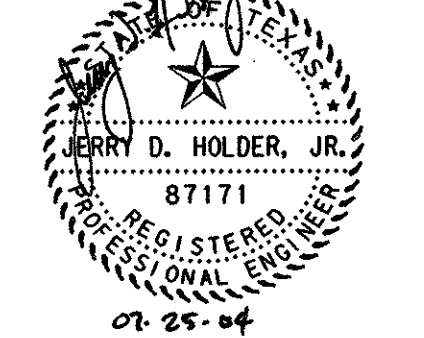

NO.	DATE	REVISION	APPROV.
HNTB ARCHITECTS ENGINEERS PLANNERS The HNTB Companies			
ARAPAHO ROAD - PHASE III			
SURVEYOR BOULEVARD TO ADDISON ROAD			
PAVING PLAN AND PROFILE			
STA 37+00 TO STA 40+00			
TOWN OF ADDISON, TEXAS			
Design JSN	Drawn GFS	DATE	SCALE
Check JDH	Check JSN	APRIL 04	H: 1"=20' V: 1"=5'
PROJECT NO. 25768			SHEET NO. PP-2

29-JUN-2004 12:20 C:\p3\h1\cds\ar3pp02.dgn