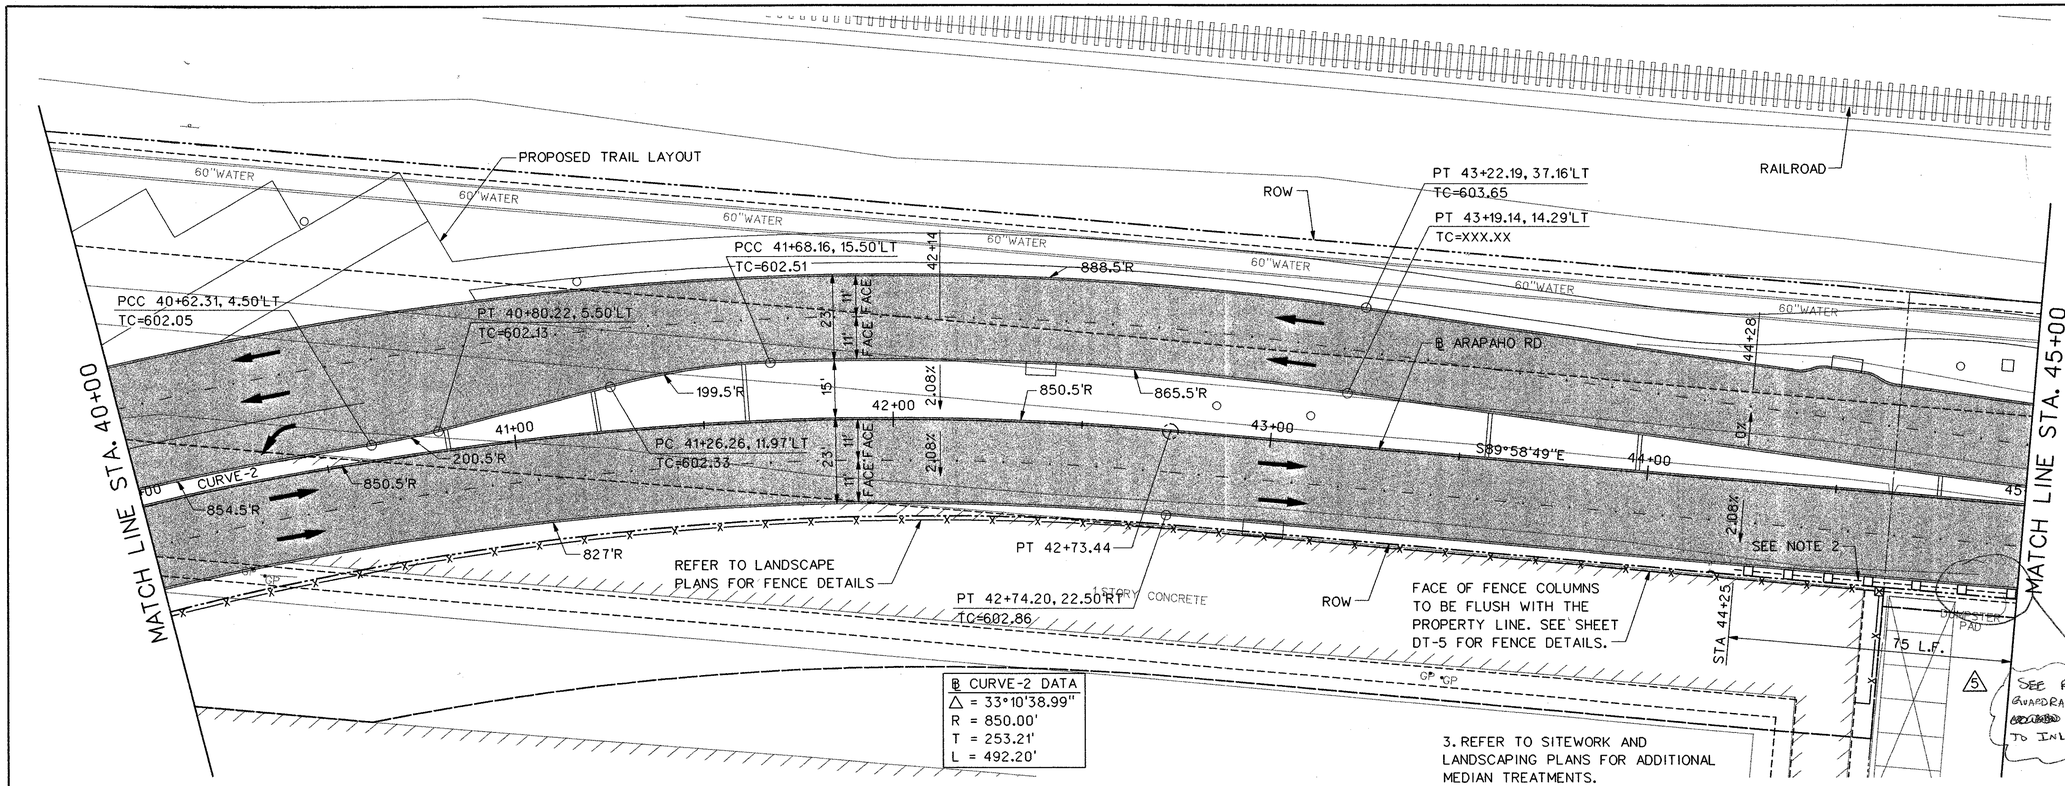

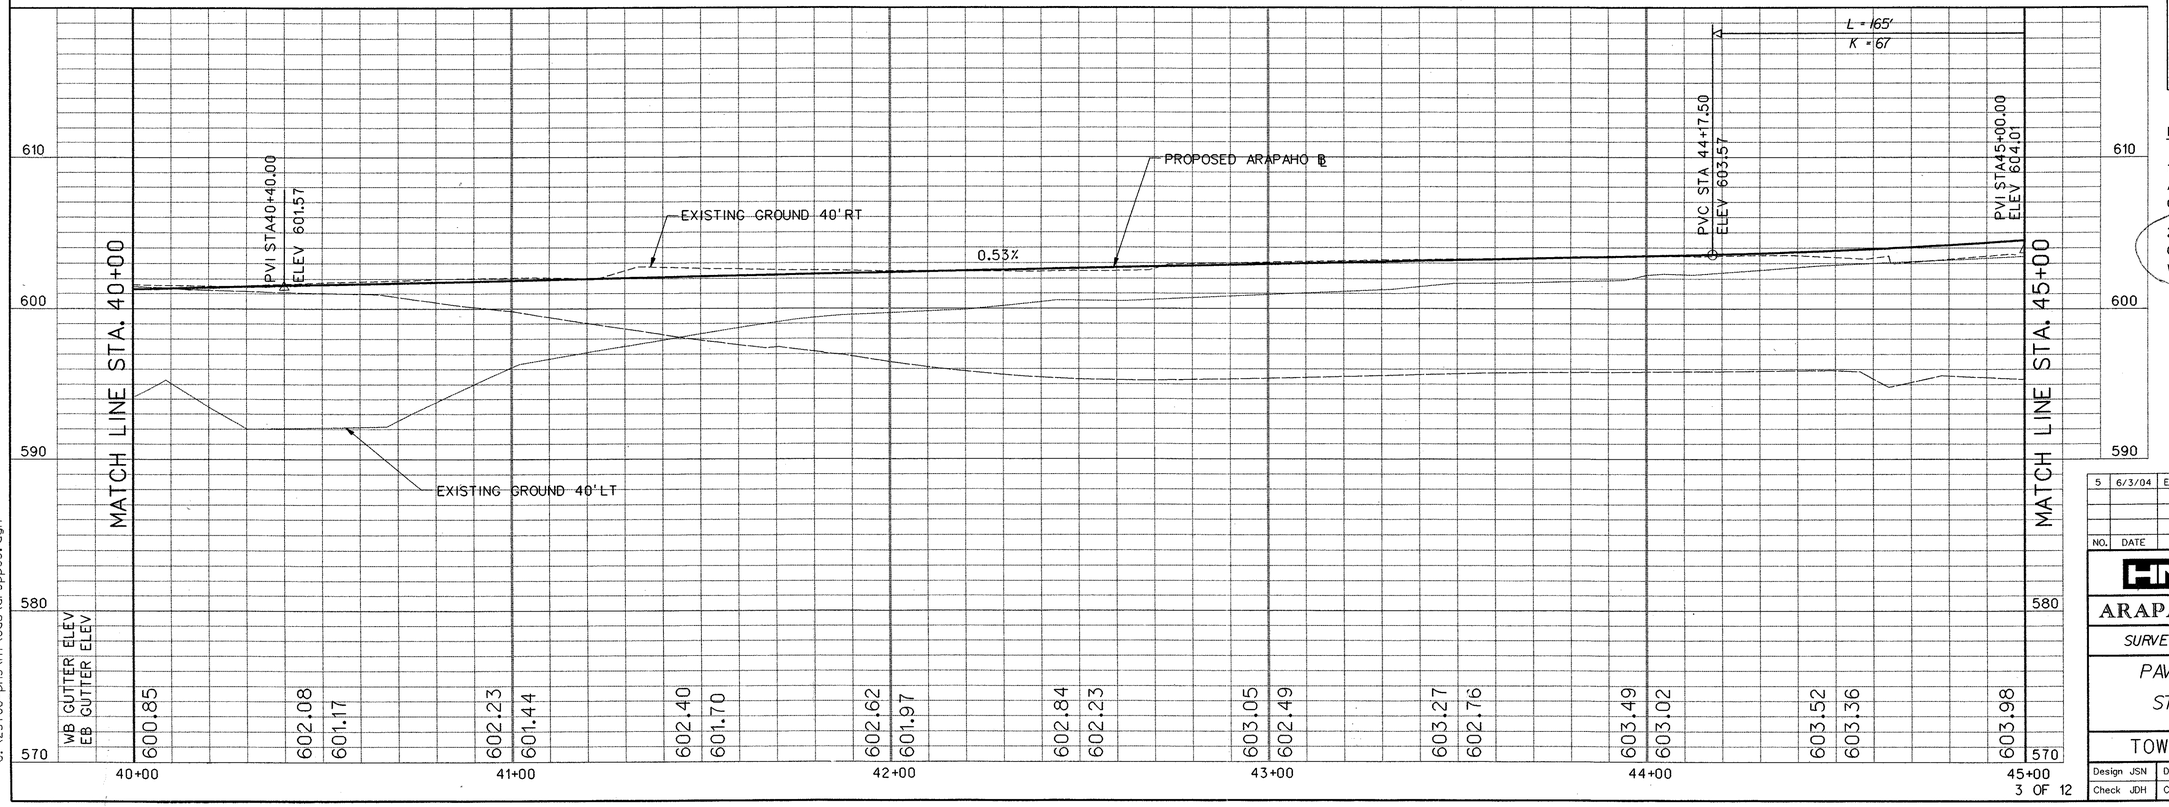

LEGEND

- EXISTING CURB
- PROPOSED CURB
- TP=XXX.XX — TOP OF PAVEMENT ELEVATION
- TC=XXX.XX — TOP OF CURB ELEVATION
- G=XXX.XX — GUTTER ELEVATION
- CR — CURB RETURN
- FENCE
- FIRE HYDRANT
- LIGHT POLE
- POWER POLE
- MH — SAN. SEWER MANHOLE
- SIGN
- TL — TRAFFIC SIGNAL
- VEGETATION
- TREE
- W — WATER LINE
- TEMPORARY CONSTRUCTION EASEMENT
- PROPOSED PAVING
- BRIDGE

NOTES:

1. ALL DIMENSIONS AND CALL OUTS ARE TO BACK OF CURB UNLESS OTHERWISE NOTED.
2. 75 L.F. OF TxDOT SGT(8). CONTRACTOR TO INSTALL HB-03A WITH IMPACT HEAD.

SEE RFI # 089

STATE OF TEXAS
JERRY D. HOLDER, JR.
87171
REGISTERED
PROFESSIONAL ENGINEER
07-23-04

43

NO.	DATE	REVISION	APPROV.
5	6/3/04	EXTENDED SGT	JSN

HNTB ARCHITECTS ENGINEERS PLANNERS
The HNTB Companies

ARAPAHO ROAD - PHASE III

SURVEYOR BOULEVARD TO ADDISON ROAD

PAVING PLAN AND PROFILE
STA 40+00 TO STA 45+00

TOWN OF ADDISON, TEXAS

Design JSN	Drawn GFS	DATE	SCALE	PROJECT NO.	SHEET NO.
Check JDH	Check JSN	APRIL 04	H: 1"= 20' V: 1"=5'	25768	PP-3

3 OF 12

29-JUN-2004 12:20
G:\25768-ph3\hl\cds\or3pp03.dgn