

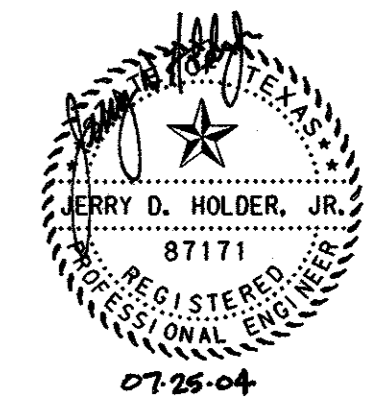


LEGEND	
	EXISTING CURB
	PROPOSED CURB
TP=XXX.XX	TOP OF PAVEMENT ELEVATION
TC=XXX.XX	TOP OF CURB ELEVATION
G=XXX.XX	GUTTER ELEVATION
CR	CURB RETURN
	FENCE
	FIRE HYDRANT
	LIGHT POLE
	POWER POLE
	SAN. SEWER MANHOLE
	SIGN
	TRAFFIC SIGNAL
	VEGETATION
	TREE
	WATER LINE
	TEMPORARY CONSTRUCTION EASEMENT
	PROPOSED PAVING
	BRIDGE

- NOTES:**
1. ALL DIMENSIONS AND CALL OUTS ARE TO BACK OF CURB UNLESS OTHERWISE NOTED.
  2. REFER TO PLANS FOR RETAINING WALL AND BRIDGE INFORMATION AND DETAILS.

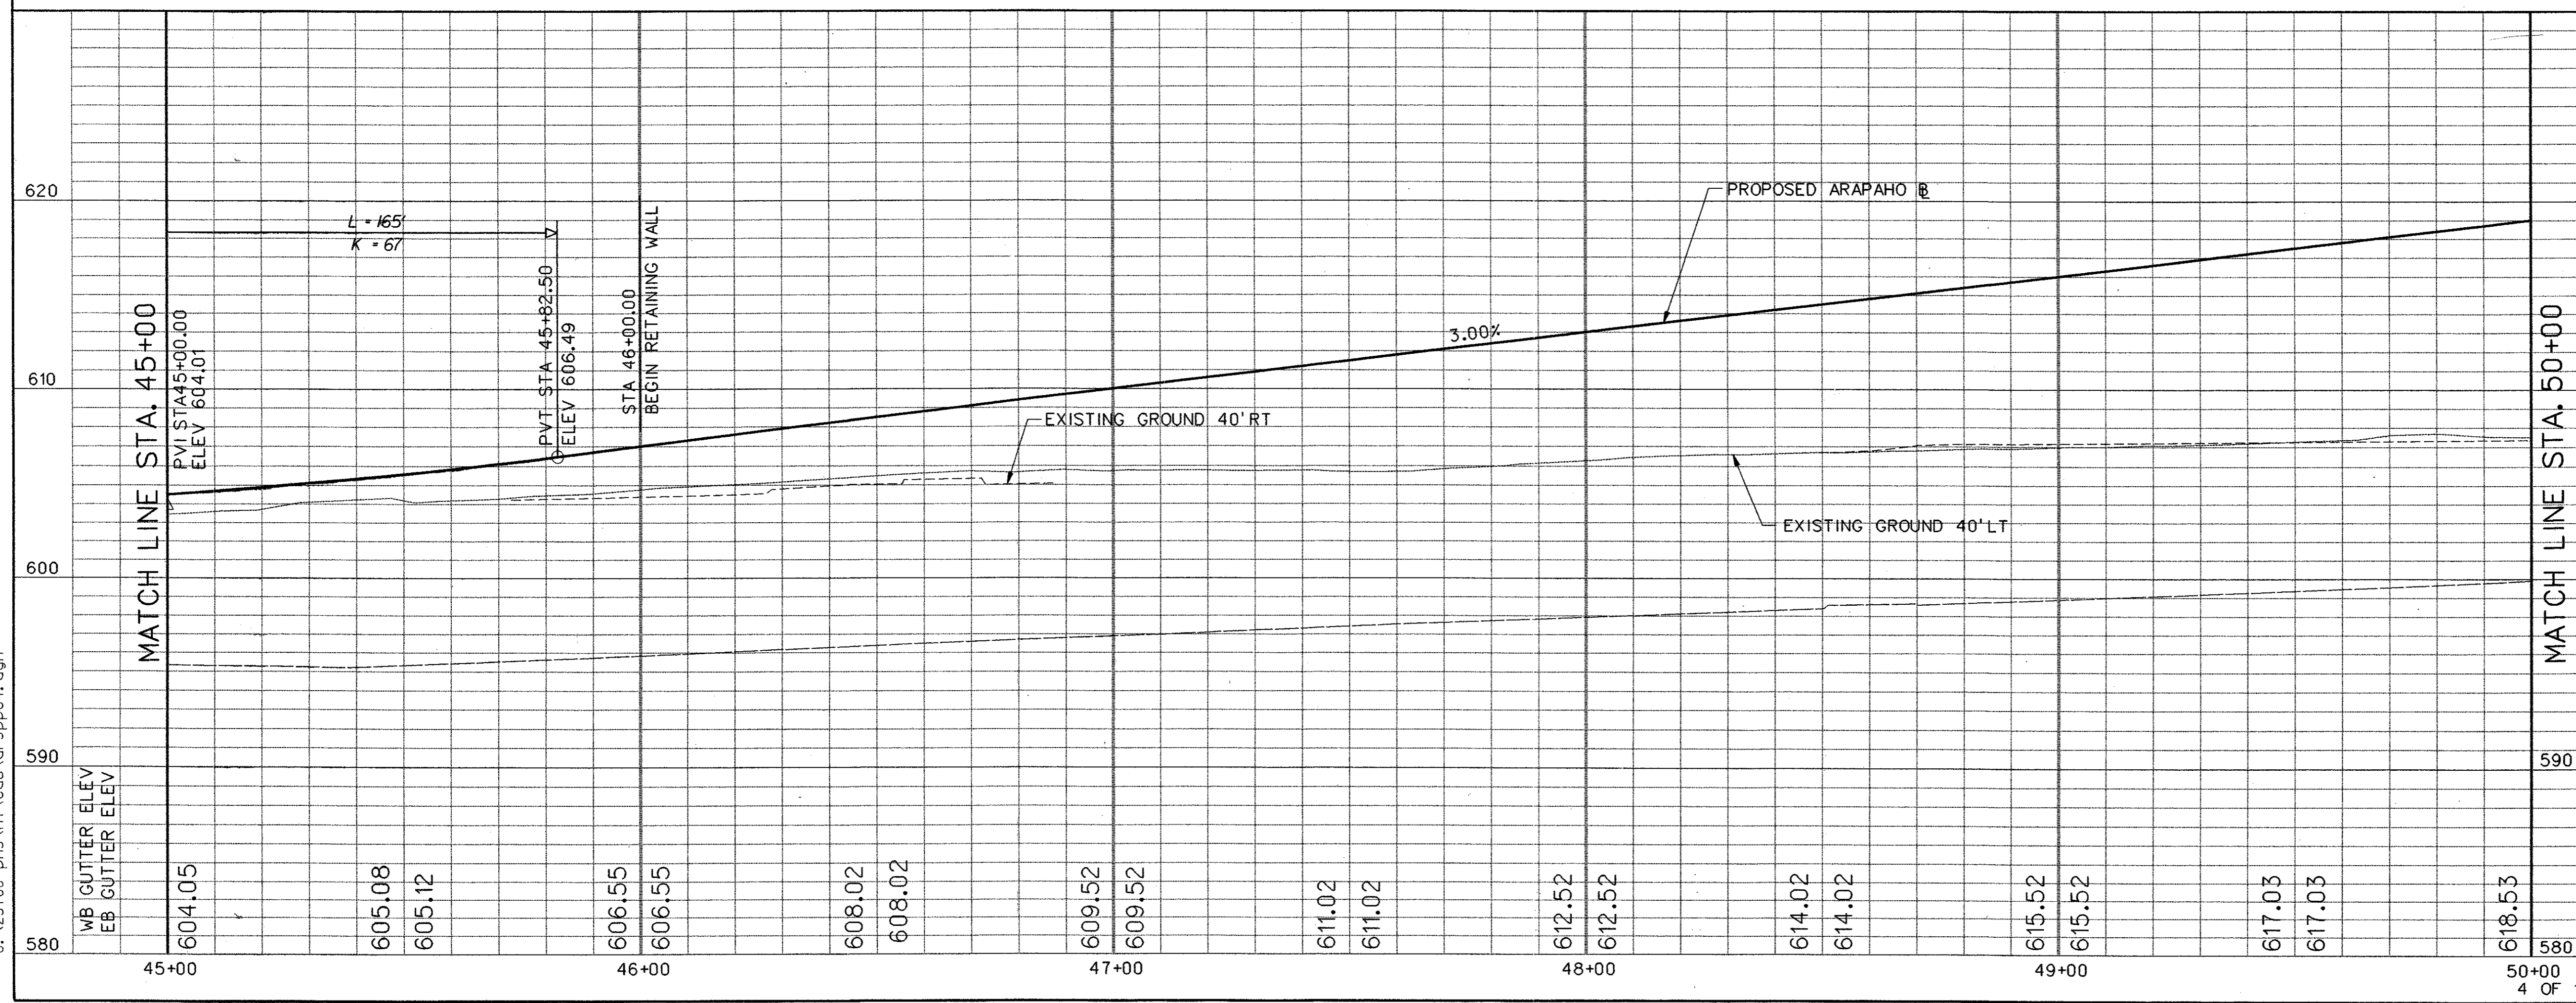

NO.	DATE	REVISION	APPROV.
<b>HNTB</b> ARCHITECTS ENGINEERS PLANNERS The HNTB Companies			
<b>ARAPAHO ROAD - PHASE III</b>			
SURVEYOR BOULEVARD TO ADDISON ROAD			
PAVING PLAN AND PROFILE			
STA 45+00 TO STA 50+00			
TOWN OF ADDISON, TEXAS			
Design JSN	Drawn GFS	DATE	SCALE
Check JDH	Check JSN	APRIL 04	H: 1"=20' V: 1"=5'
PROJECT NO. 25768		SHEET NO. PP-4	

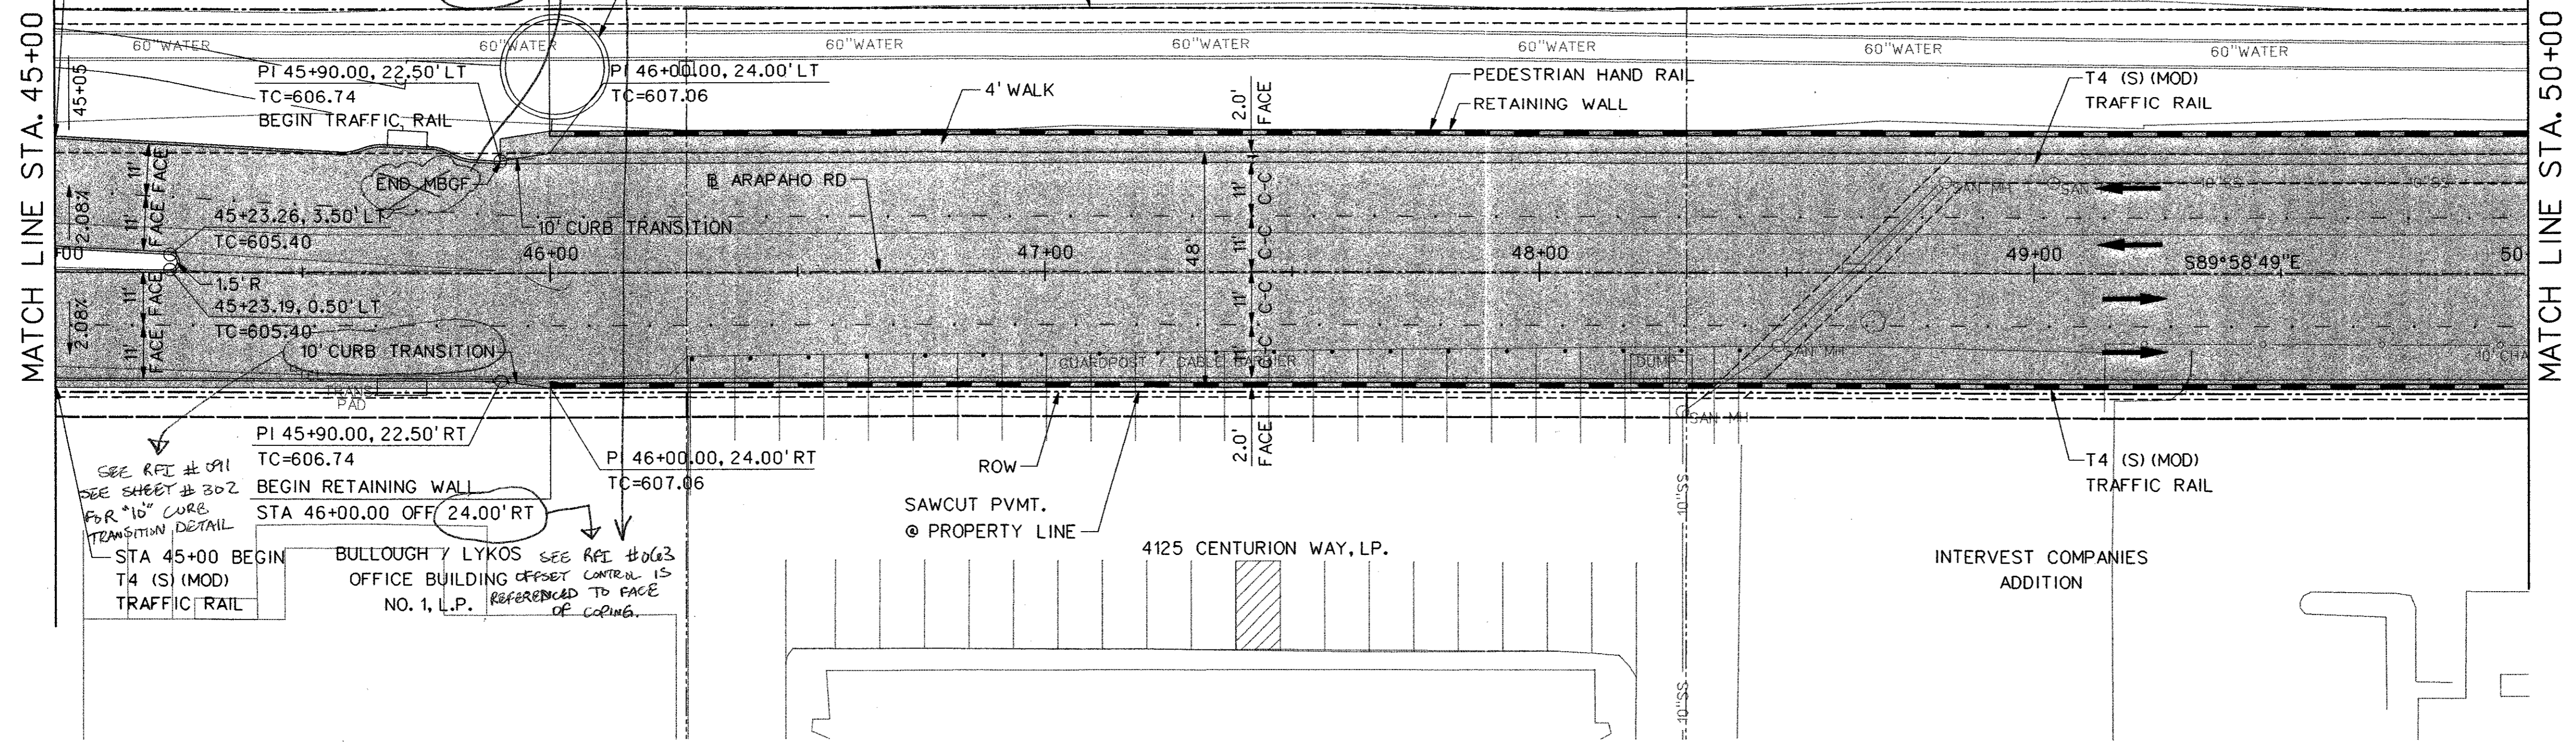

29-JUN-2004 12:21 G:\25768-pa3\h1\Cad\3pp04.dgn