
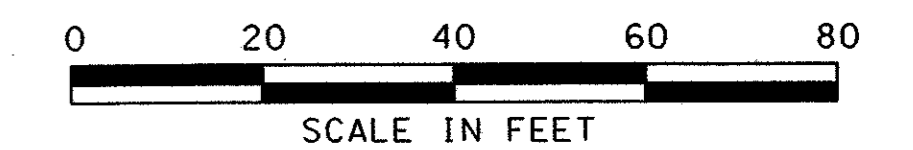



29-JUN-2004 12:21
G:\25768-ph3\h1\Cds\ar3pp05.dgn

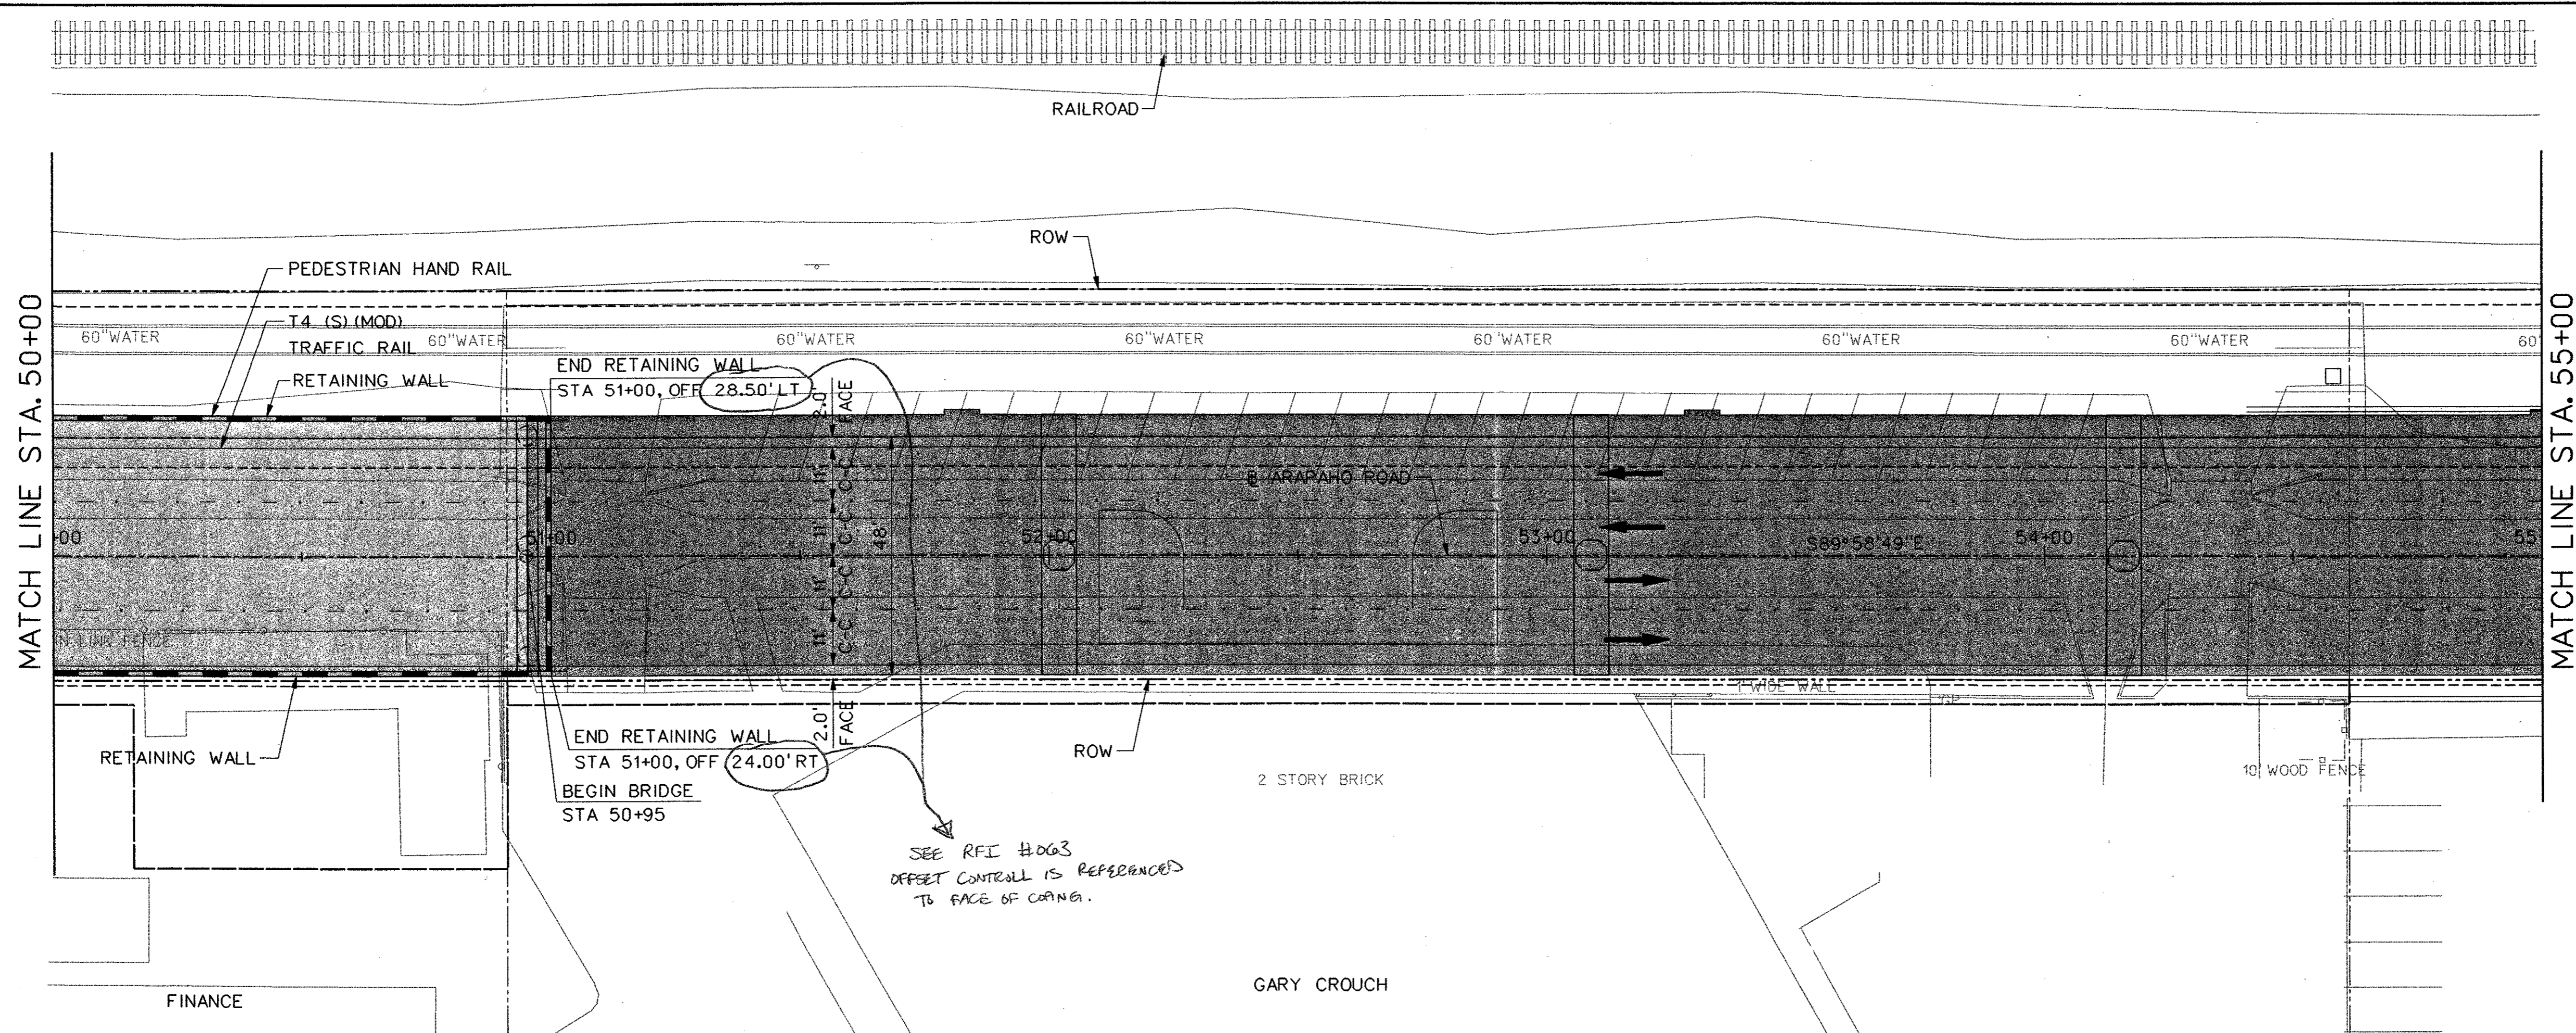

LEGEND

- EXISTING CURB
- PROPOSED CURB
- TP=XXX.XX TOP OF PAVEMENT ELEVATION
- TC=XXX.XX TOP OF CURB ELEVATION
- G=XXX.XX GUTTER ELEVATION
- CR CURB RETURN
- ✕ FENCE
- ⊙ FIRE HYDRANT
- ⊙ LIGHT POLE
- POWER POLE
- ⊙ MH SAN. SEWER MANHOLE
- ⊕ SIGN
- ⊙ TL TRAFFIC SIGNAL
- ⊙ VEGETATION
- ⊙ TREE
- W WATER LINE
- TEMPORARY CONSTRUCTION EASEMENT
- ▨ PROPOSED PAVING
- ▨ BRIDGE

- NOTES:**
1. ALL DIMENSIONS AND CALL OUTS ARE TO BACK OF CURB UNLESS OTHERWISE NOTED.
 2. REFER TO PLANS FOR RETAINING WALL AND BRIDGE INFORMATION AND DETAILS.

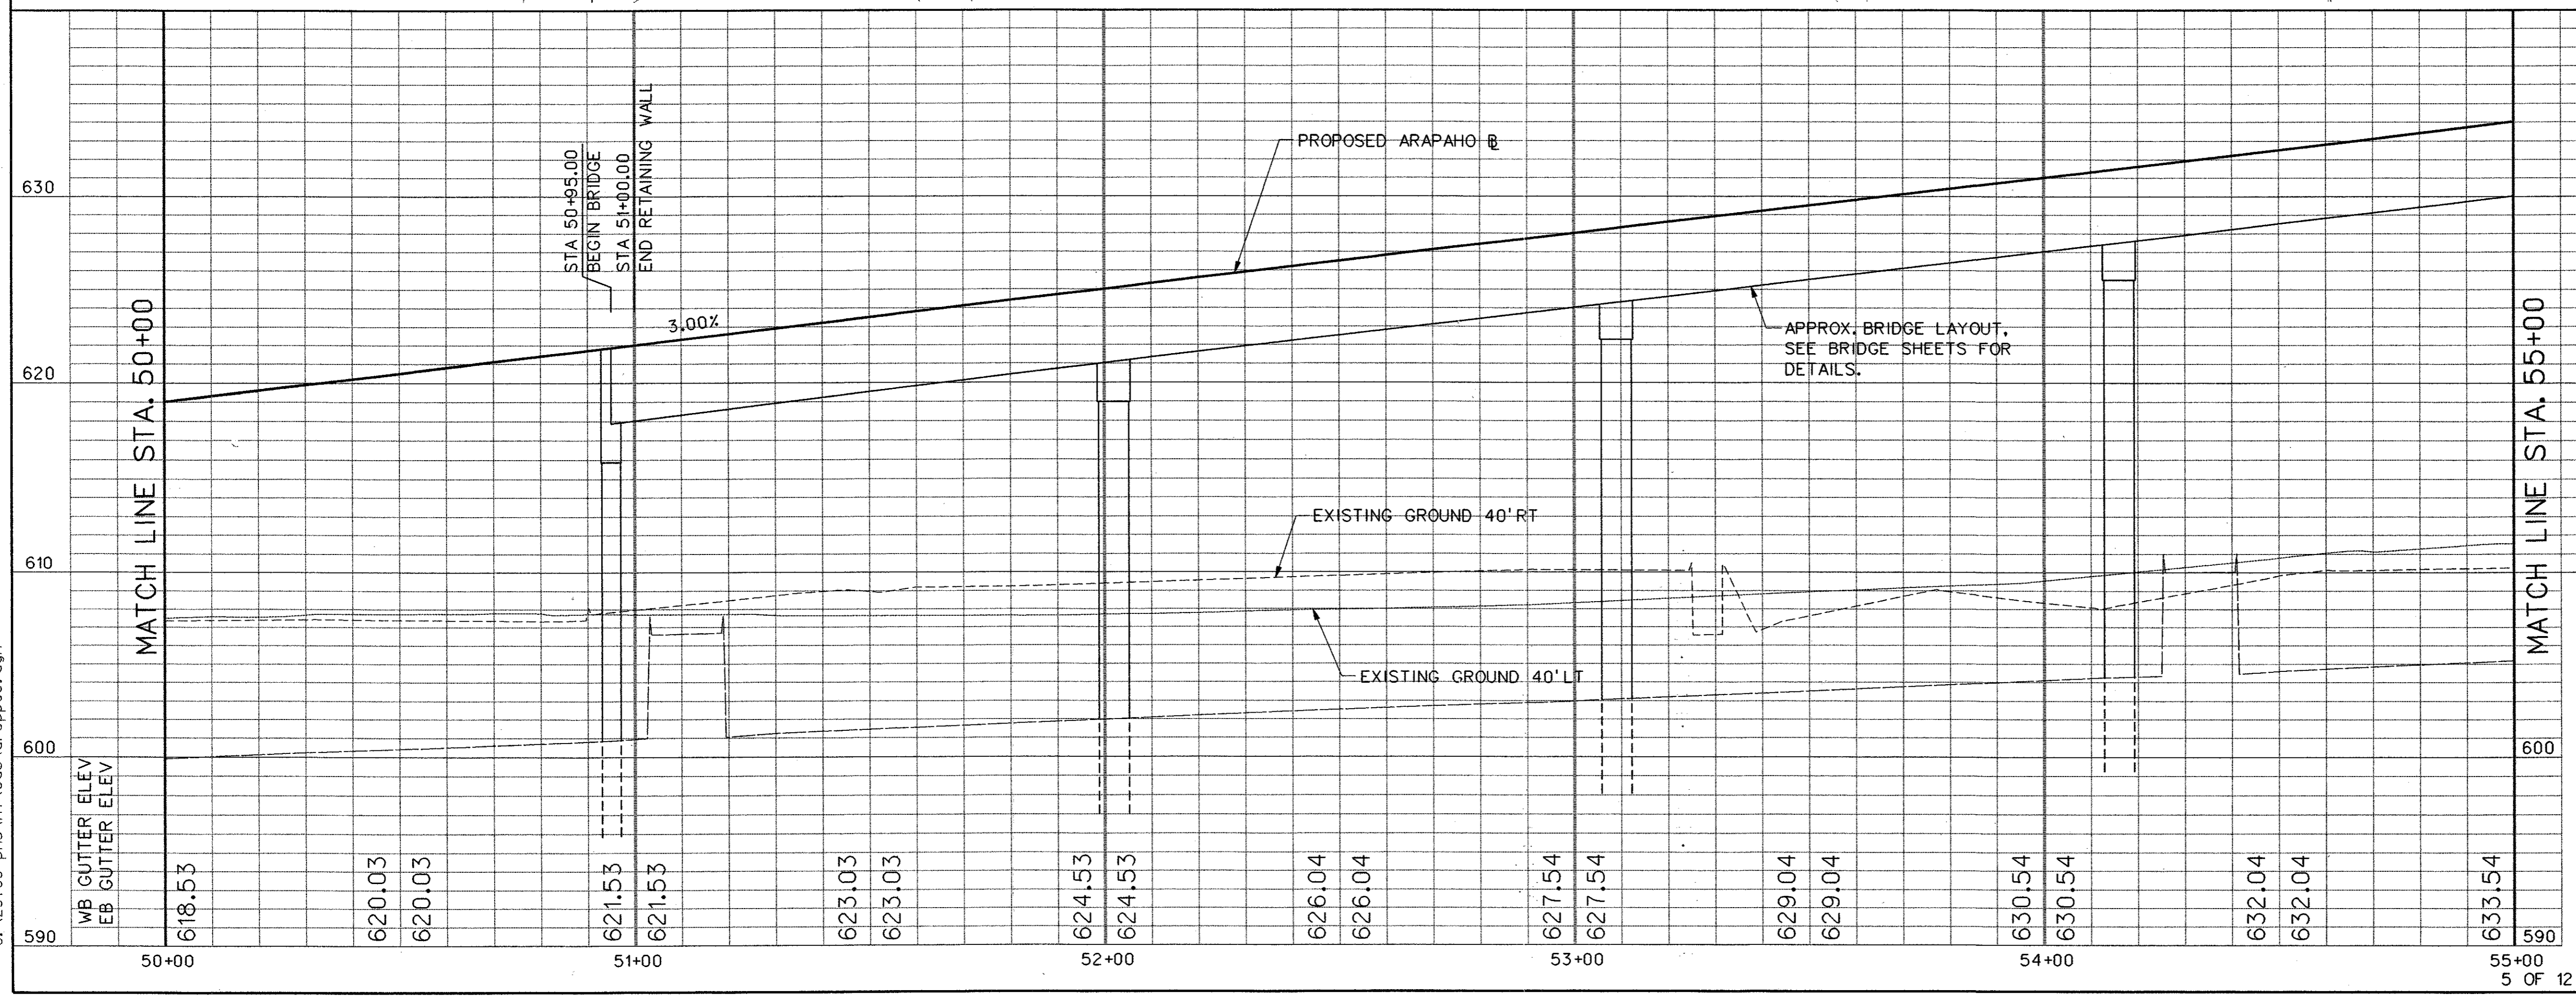

| | | | |
|-----------------------------------------------------------------|-----------|----------------|-----------------------|
| NO. | DATE | REVISION | APPROV. |
| | | | |
| HNTB ARCHITECTS ENGINEERS PLANNERS The HNTB Companies | | | |
| ARAPAHO ROAD - PHASE III | | | |
| SURVEYOR BOULEVARD TO ADDISON ROAD | | | |
| PAVING PLAN AND PROFILE STA 50+00 TO STA 55+00 | | | |
| TOWN OF ADDISON, TEXAS | | | |
| Design JSN | Drawn GFS | DATE | SCALE |
| Check JDH | Check JSN | APRIL 04 | H: 1"=20' V: 1"=5' |
| PROJECT NO. 25768 | | SHEET NO. PP-5 | |

45