
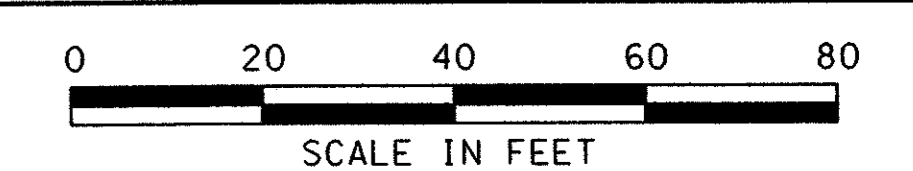



29-JUN-2004 12:21
 G:\25768-ph3\h1\Cad\ar3pp06.dgn

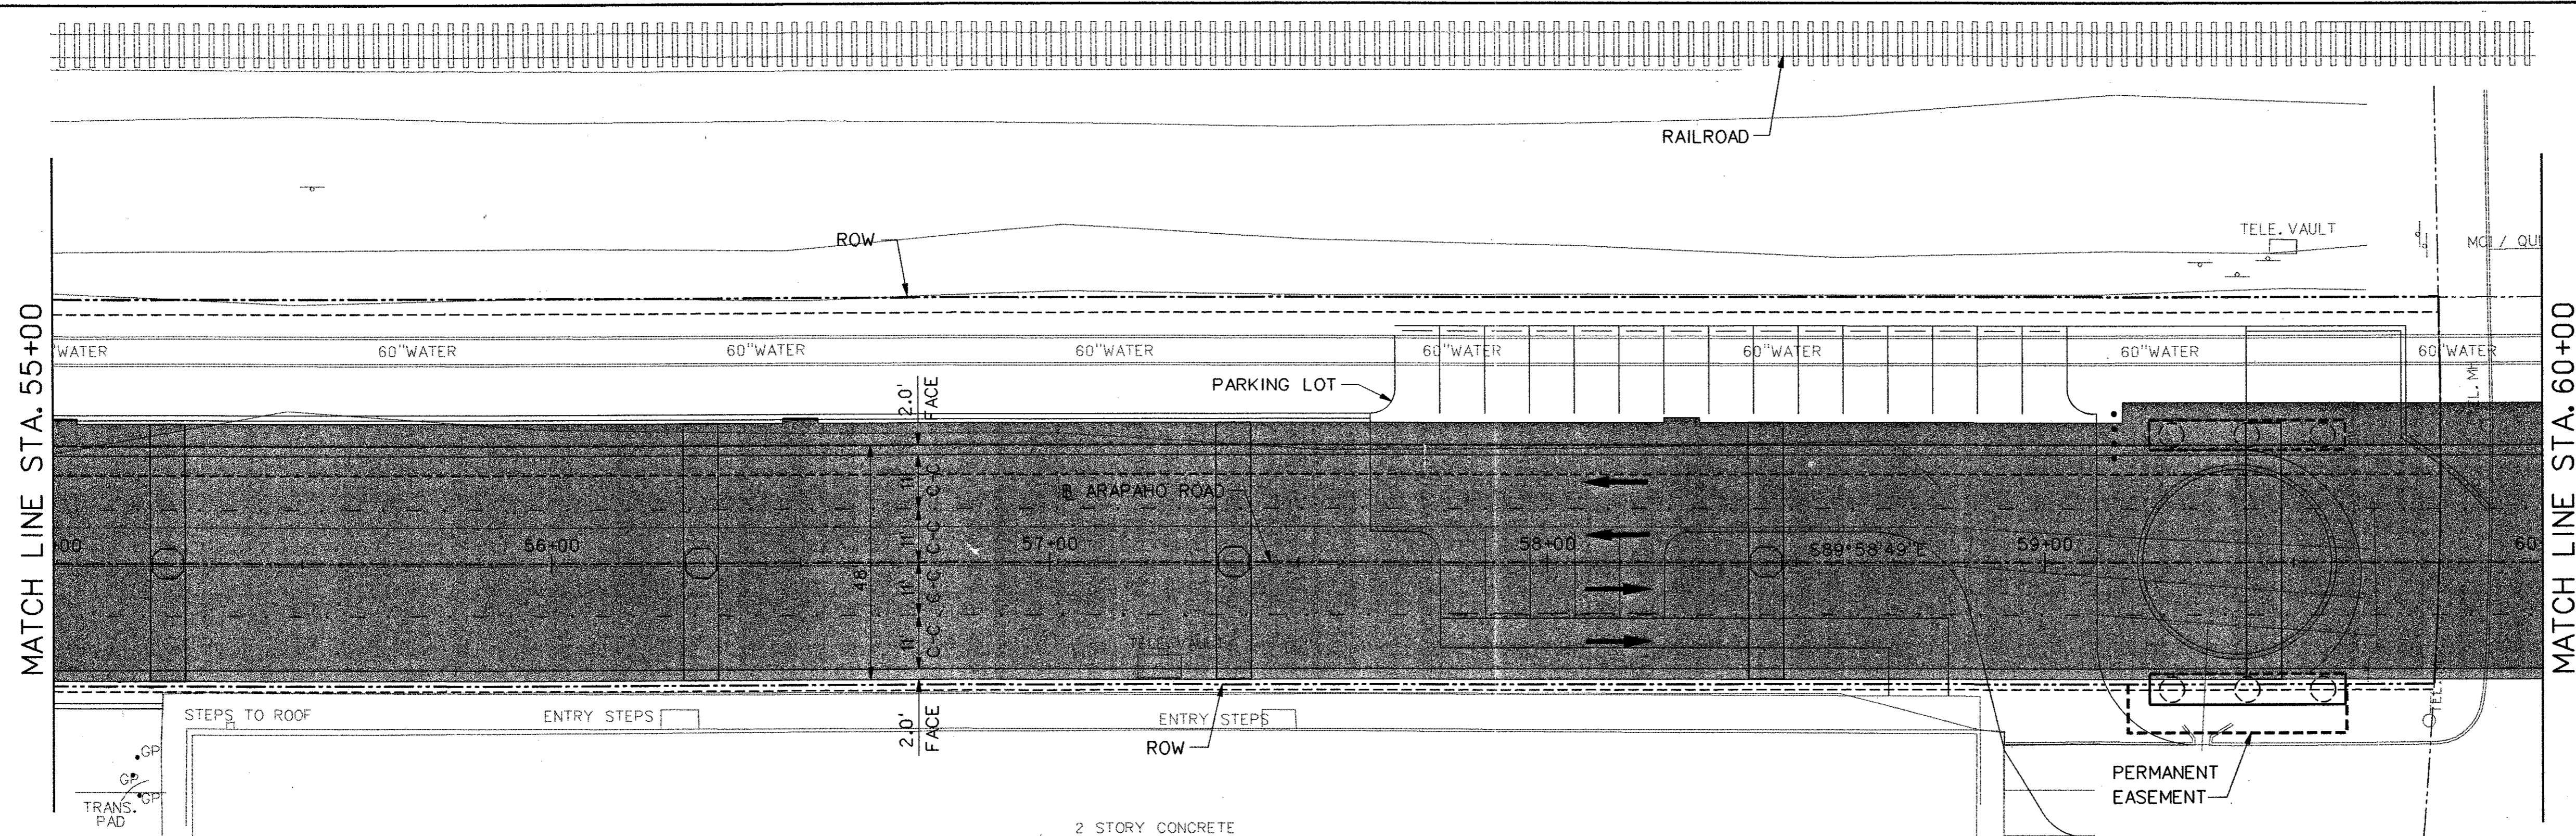

LEGEND

- EXISTING CURB
- PROPOSED CURB
- TP=XXX.XX TOP OF PAVEMENT ELEVATION
- TC=XXX.XX TOP OF CURB ELEVATION
- G=XXX.XX GUTTER ELEVATION
- CR CURB RETURN
- ⊗ FENCE
- ⊙ FIRE HYDRANT
- ⊛ LIGHT POLE
- POWER POLE
- ⊙ MH SAN. SEWER MANHOLE
- ⊞ SIGN
- ⊛ TL TRAFFIC SIGNAL
- ⊞ VEGETATION
- ⊙ TREE
- W WATER LINE
- - - TEMPORARY CONSTRUCTION EASEMENT
- ▨ PROPOSED PAVING
- ▩ BRIDGE

- NOTES:**
- ALL DIMENSIONS AND CALL OUTS ARE TO BACK OF CURB UNLESS OTHERWISE NOTED.
 - REFER TO PLANS FOR RETAINING WALL AND BRIDGE INFORMATION AND DETAILS.

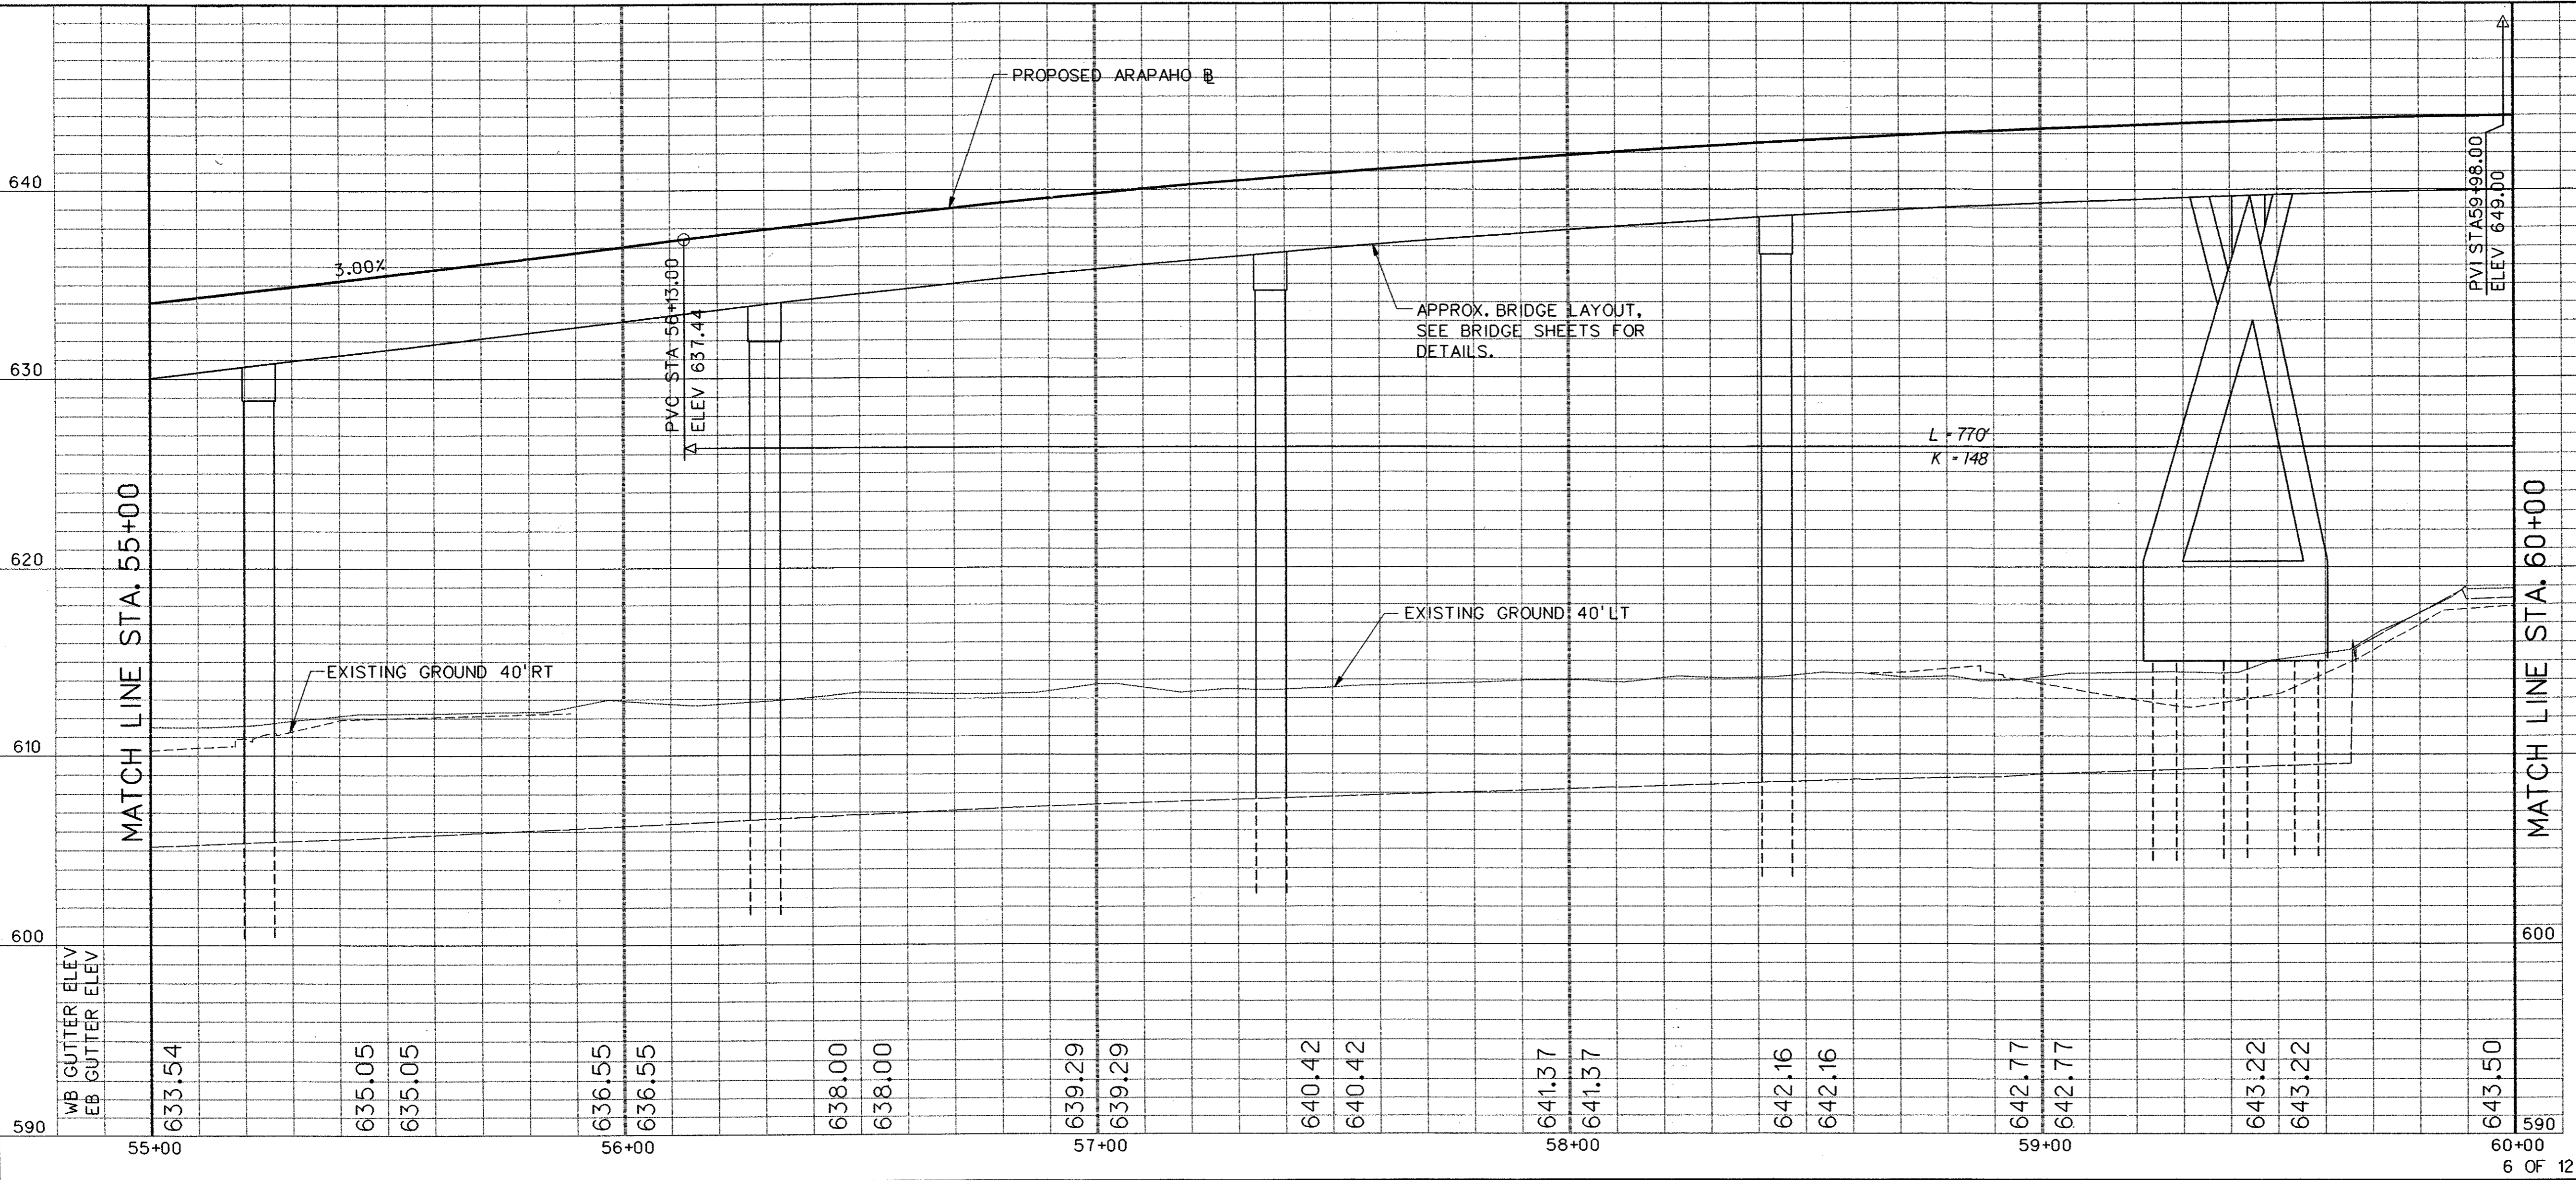

NO.	DATE	REVISION	APPROV.
ARAPAHO ROAD - PHASE III SURVEYOR BOULEVARD TO ADDISON ROAD PAVING PLAN AND PROFILE STA 55+00 TO STA 60+00 TOWN OF ADDISON, TEXAS			
Design JSN	Drawn GFS	DATE	SCALE
Check JDH	Check JSN	APRIL 04	H: 1"=20' V: 1"=5'
PROJECT NO. 25768		SHEET NO. PP-6	