




**LEGEND**

- EXISTING CURB
- PROPOSED CURB
- TP=XXX.XX TOP OF PAVEMENT ELEVATION
- TC=XXX.XX TOP OF CURB ELEVATION
- G=XXX.XX GUTTER ELEVATION
- CR CURB RETURN
- ✕ FENCE
- ⊙ FIRE HYDRANT
- ☼ LIGHT POLE
- POWER POLE
- MH SAN. SEWER MANHOLE
- ⊥ SIGN
- ✱ TL TRAFFIC SIGNAL
- ☁ VEGETATION
- ⊙ TREE
- W WATER LINE
- TEMPORARY CONSTRUCTION EASEMENT
- ▨ PROPOSED PAVING
- ▩ BRIDGE

- NOTES:**
1. ALL DIMENSIONS AND CALL OUTS ARE TO BACK OF CURB UNLESS OTHERWISE NOTED.
  2. REFER TO PLANS FOR RETAINING WALL AND BRIDGE INFORMATION AND DETAILS.
  3. SEE SHEETS PK1-PK4 FOR PARKING LOT LAYOUT AND DETAILS.

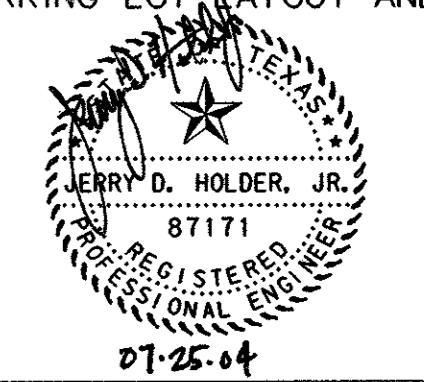

NO.	DATE	REVISION	APPROV.
<b>HNTB</b> ARCHITECTS ENGINEERS PLANNERS <i>The HNTB Companies</i>			
<b>ARAPAHO ROAD - PHASE III</b> SURVEYOR BOULEVARD TO ADDISON ROAD PAVING PLAN AND PROFILE STA 60+00 TO STA 65+00 TOWN OF ADDISON, TEXAS			
Design JSN	Drawn GFS	DATE	SCALE
Check JDH	Check JSN	APRIL 04	H: 1"=20' V: 1"=5'
PROJECT NO. 25768			SHEET NO. PP-7

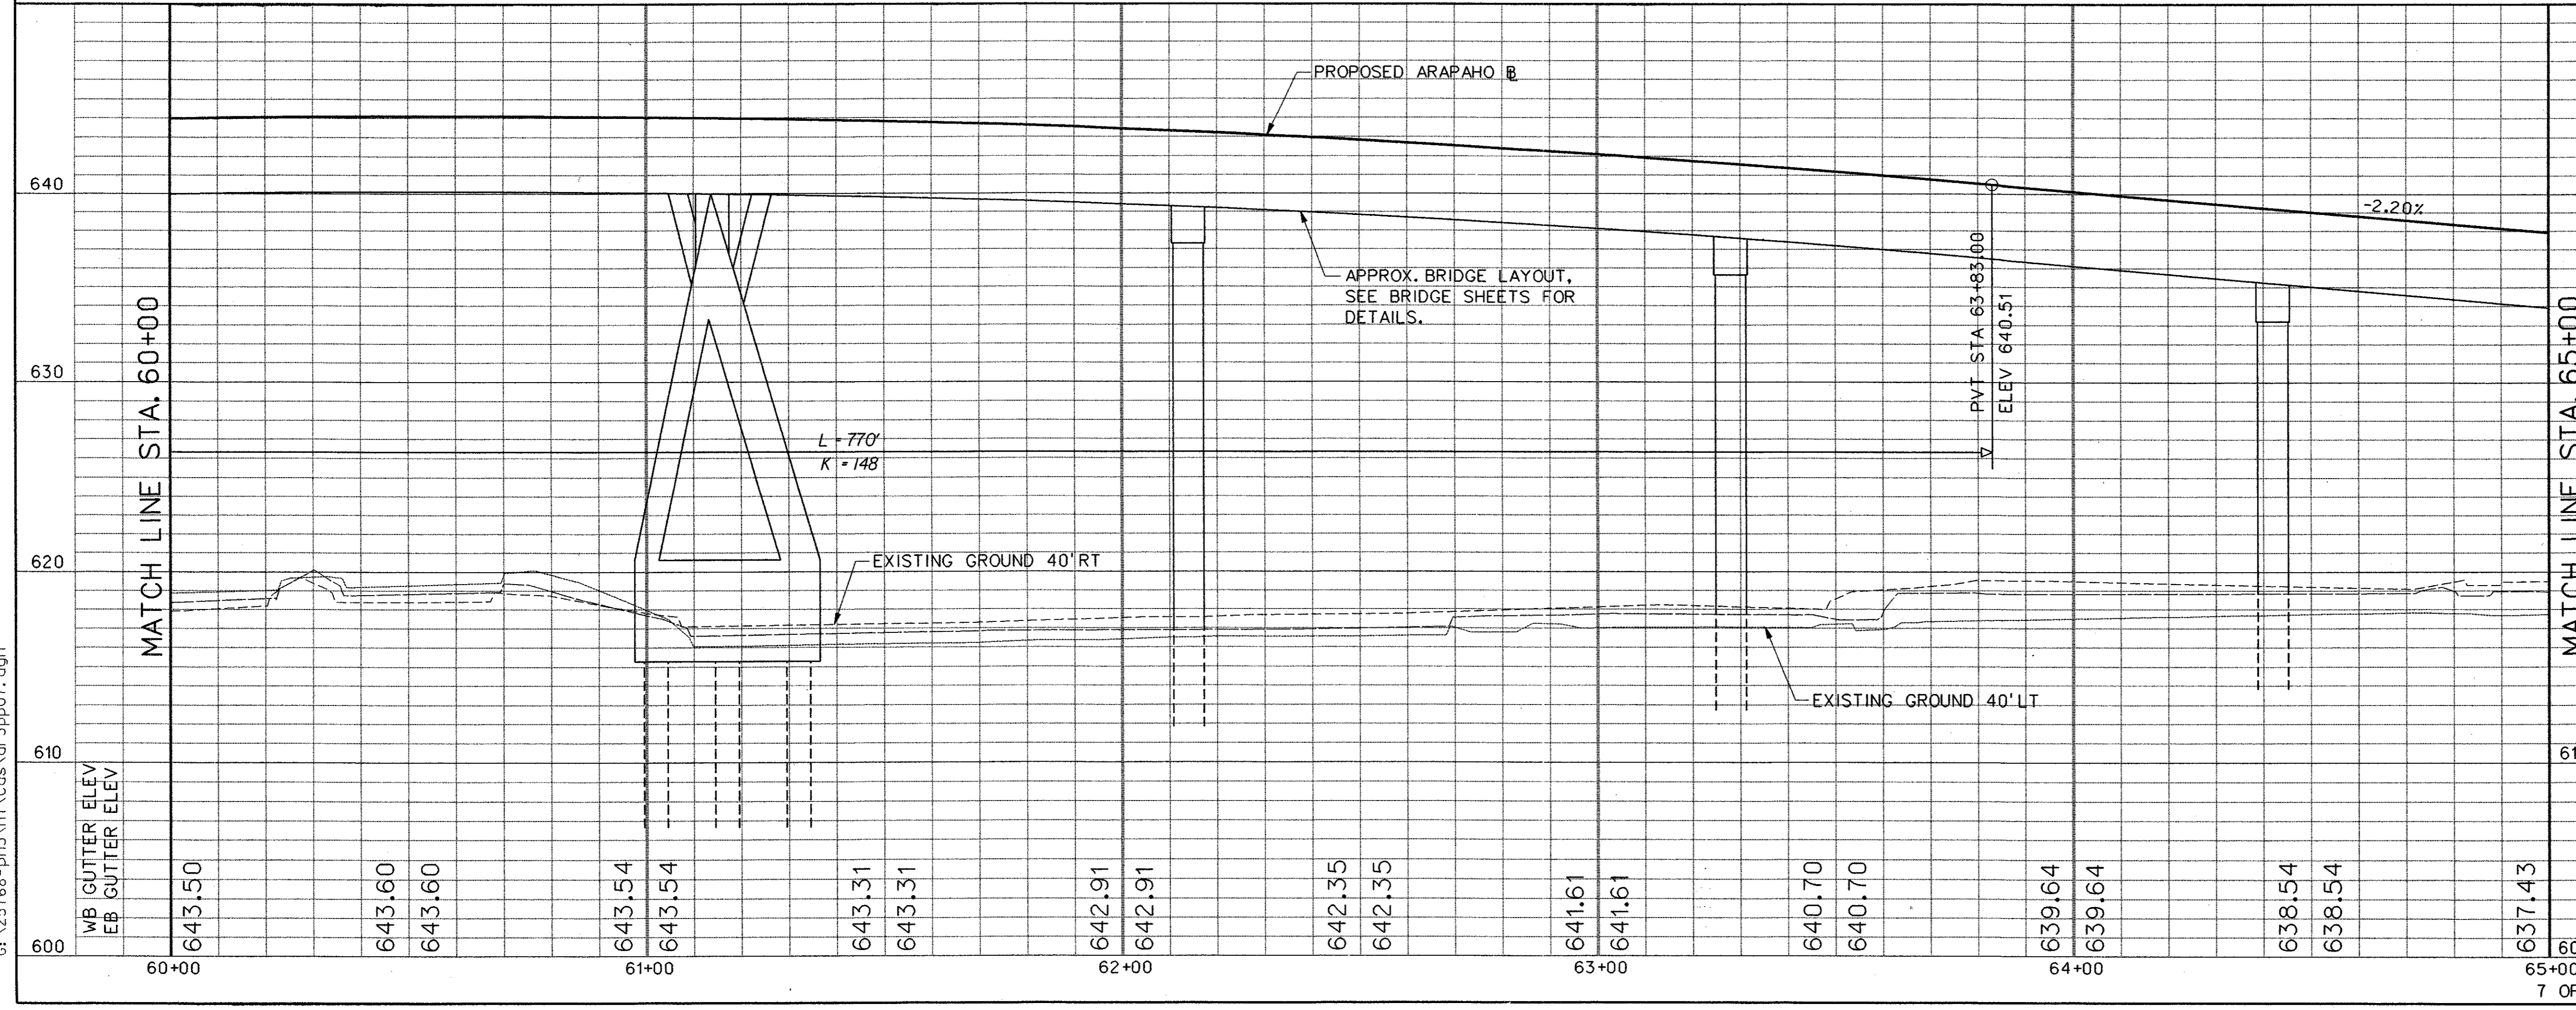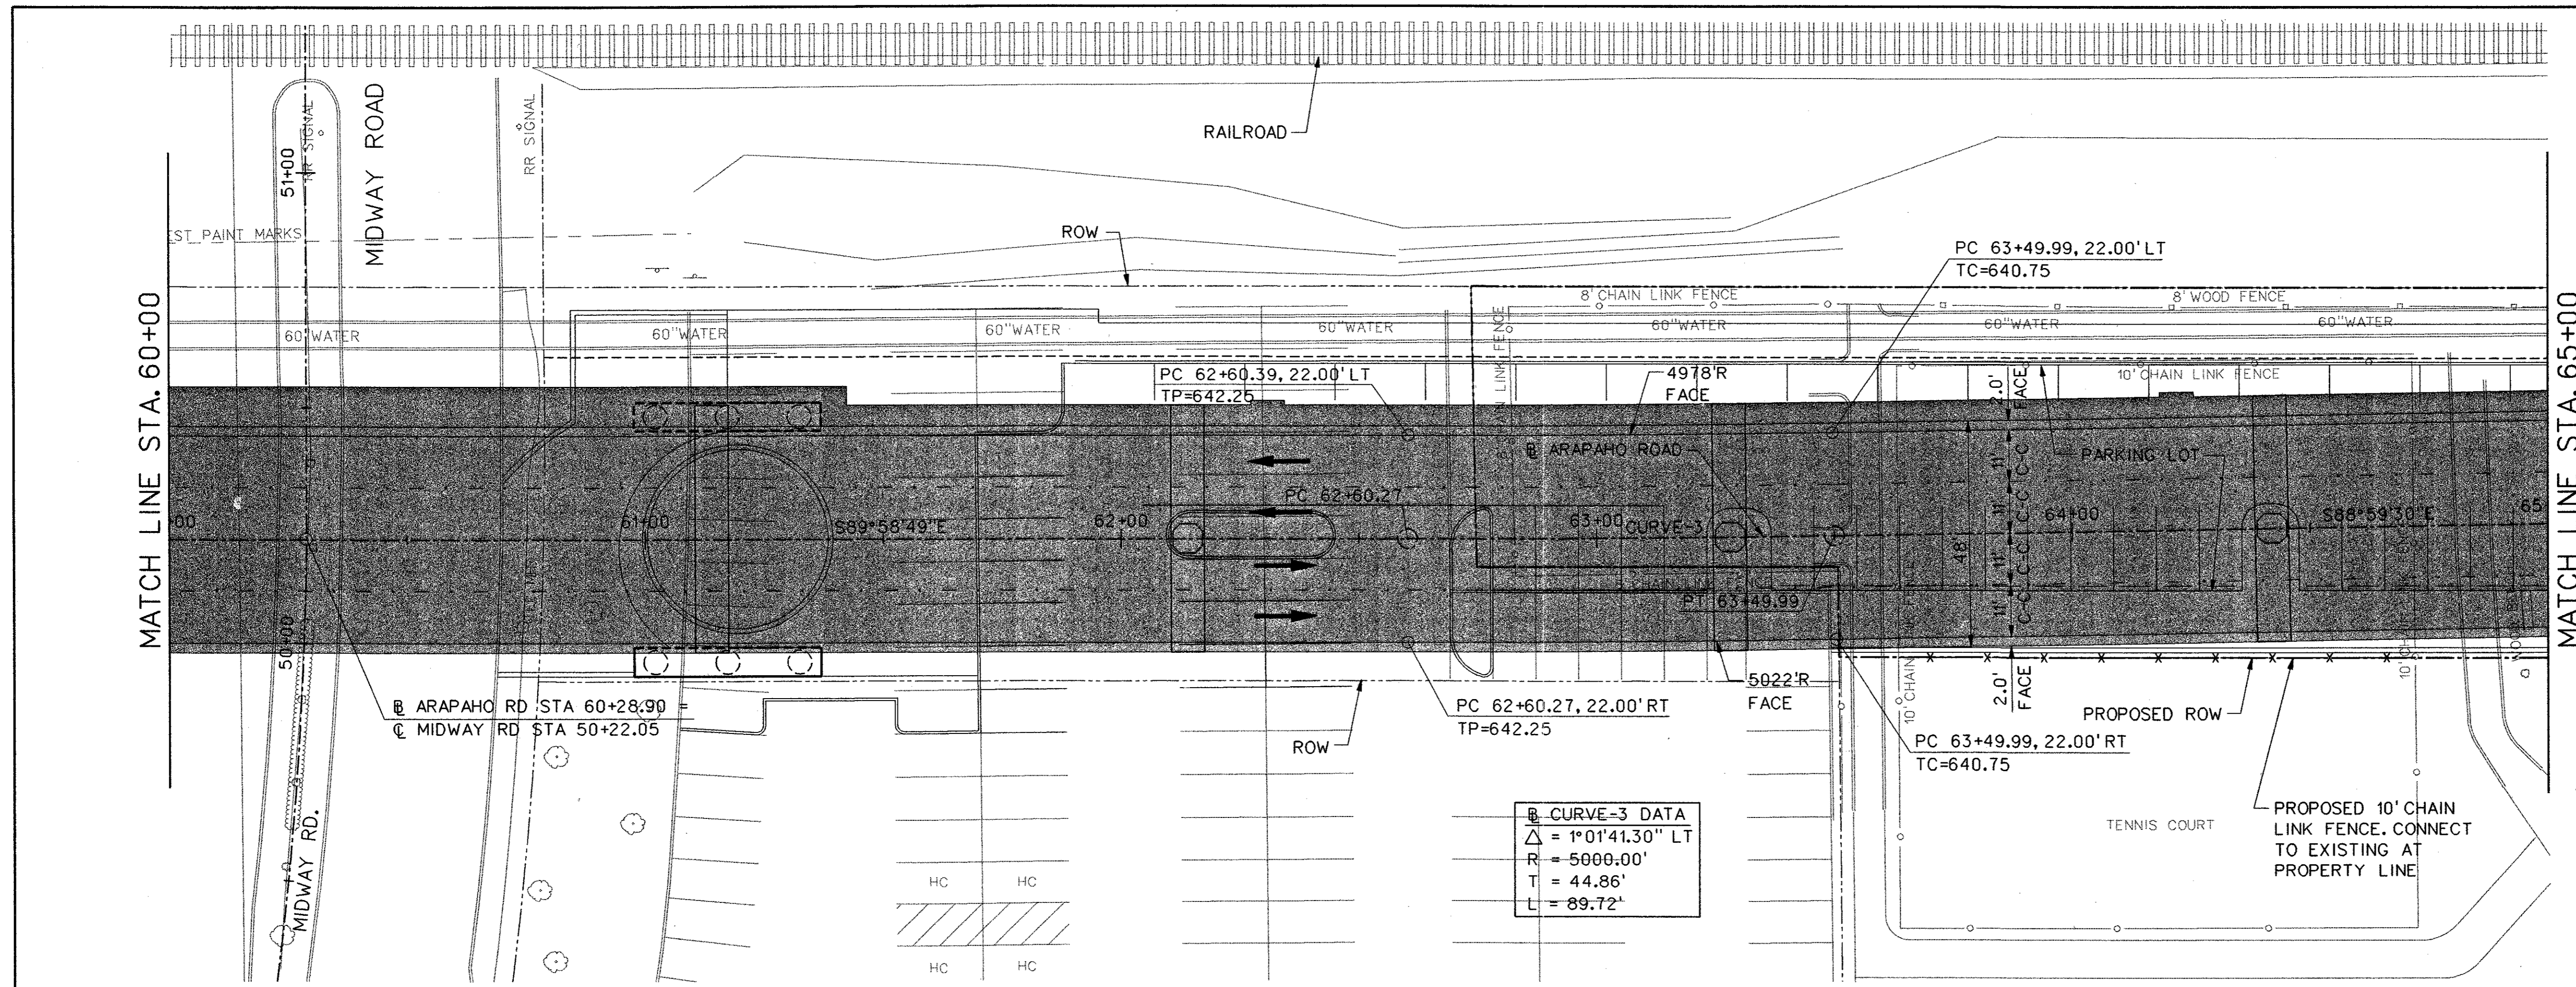

29-JUN-2004 12:21 G:\25768-PK3\H1\Cds\ar3pp07.dgn