


**LEGEND**

- EXISTING CURB
- PROPOSED CURB
- TP=XXX.XX TOP OF PAVEMENT ELEVATION
- TC=XXX.XX TOP OF CURB ELEVATION
- G=XXX.XX GUTTER ELEVATION
- CR CURB RETURN
- X FENCE
- FIRE HYDRANT
- ⊙ LIGHT POLE
- POWER POLE
- /MH SAN. SEWER MANHOLE
- ⊞ SIGN
- ⊙/TL TRAFFIC SIGNAL
- ⊙ VEGETATION
- ⊙ TREE
- WATER LINE
- TEMPORARY CONSTRUCTION EASEMENT
- ▨ PROPOSED PAVING
- ▩ BRIDGE

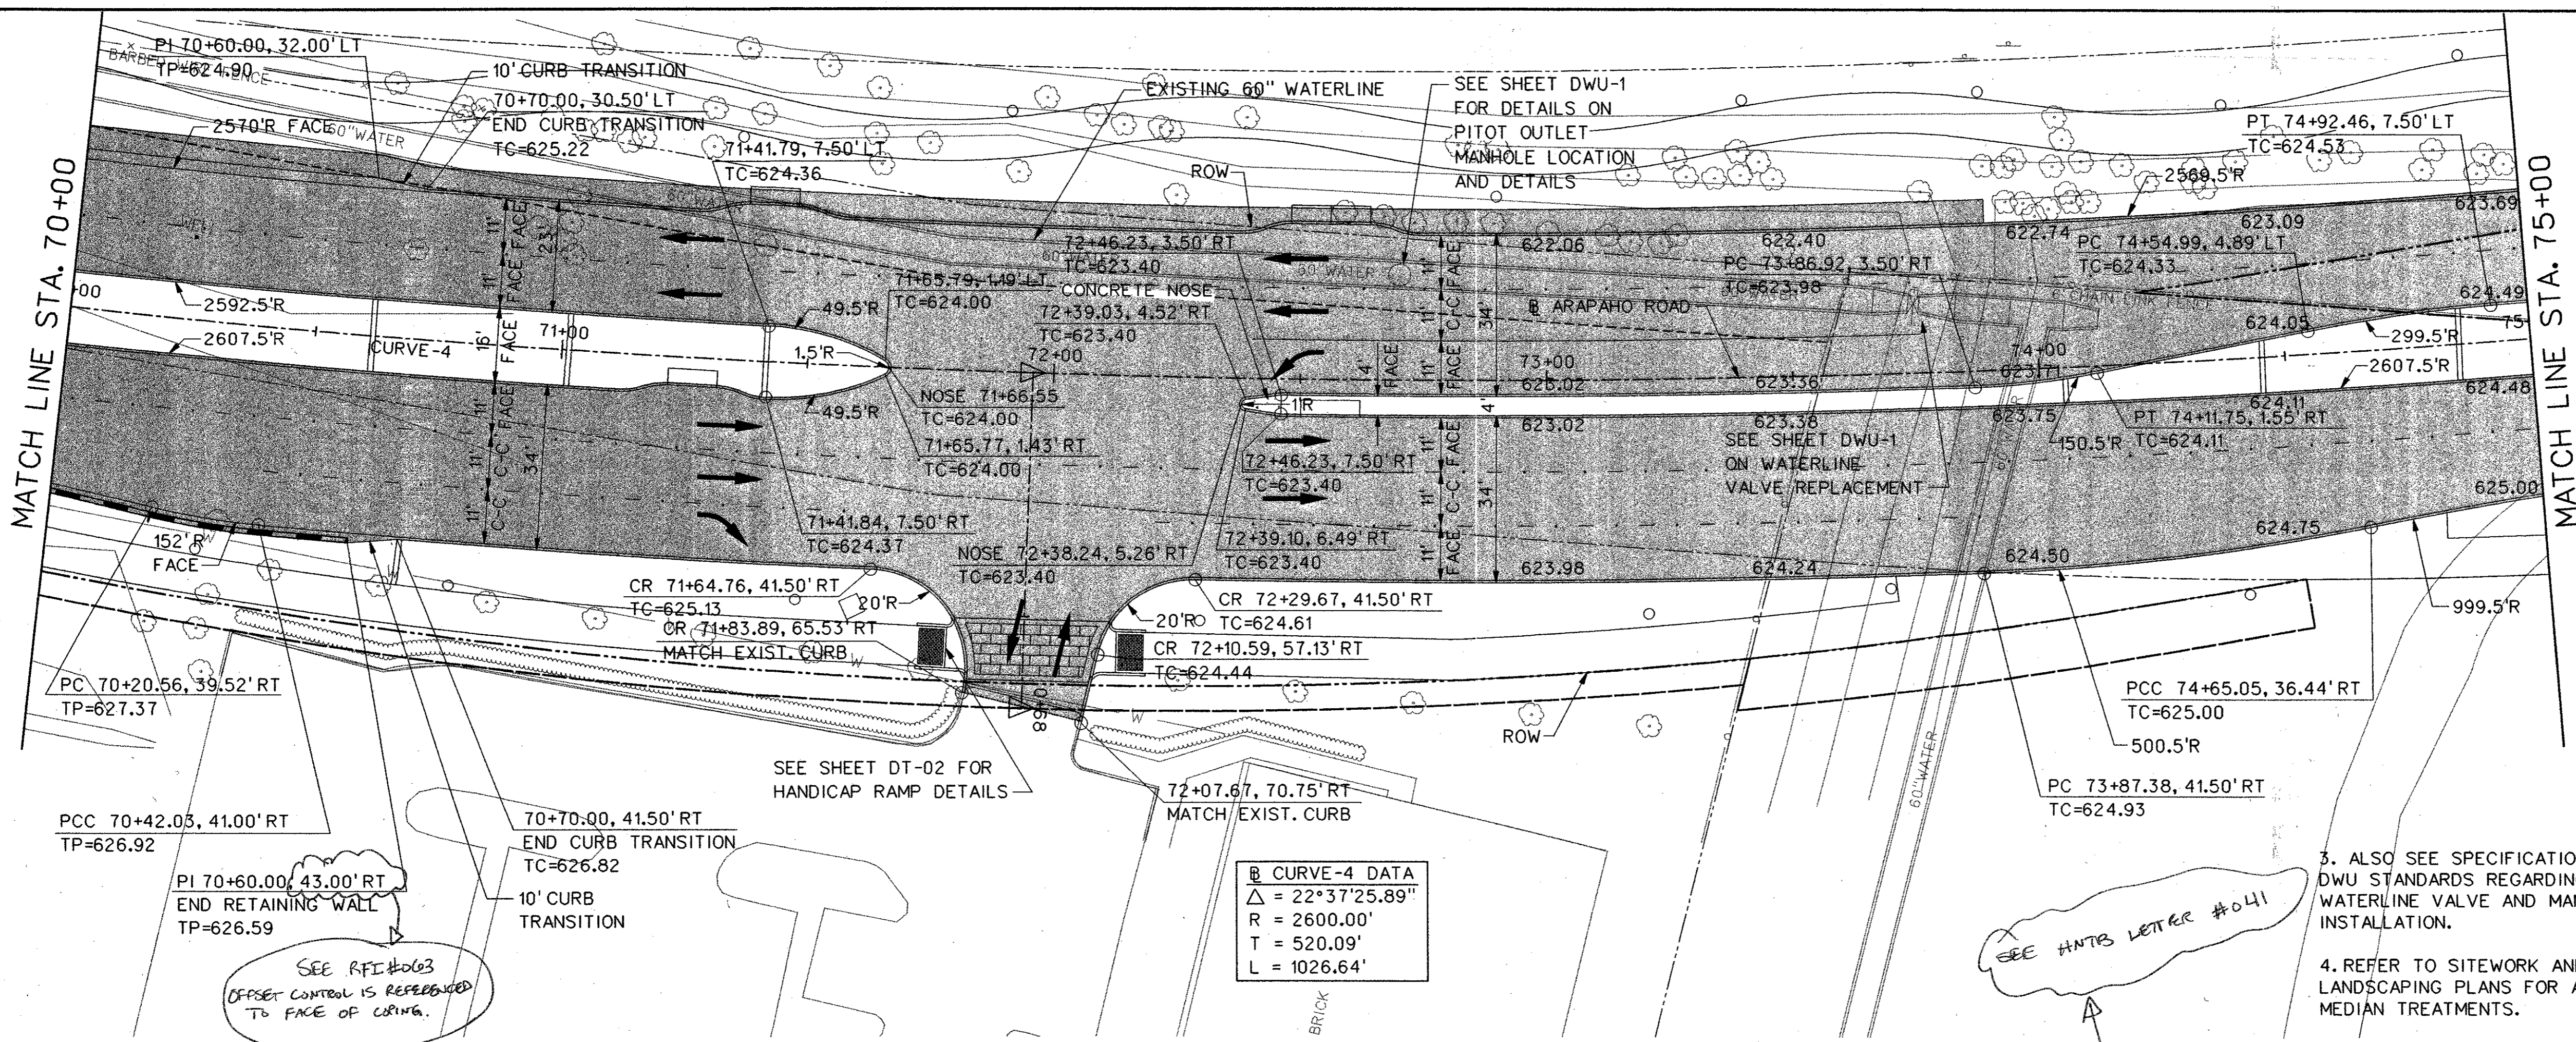



**Curve-4 DATA**

Δ = 22°37'25.89"

R = 2600.00'

T = 520.09'

L = 1026.64'

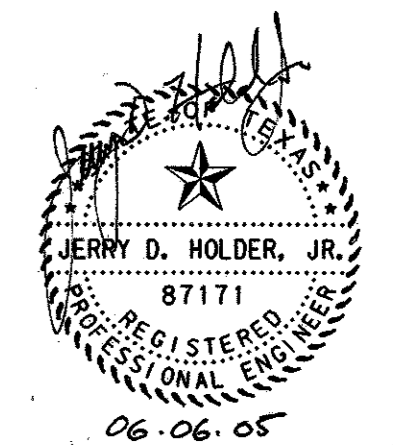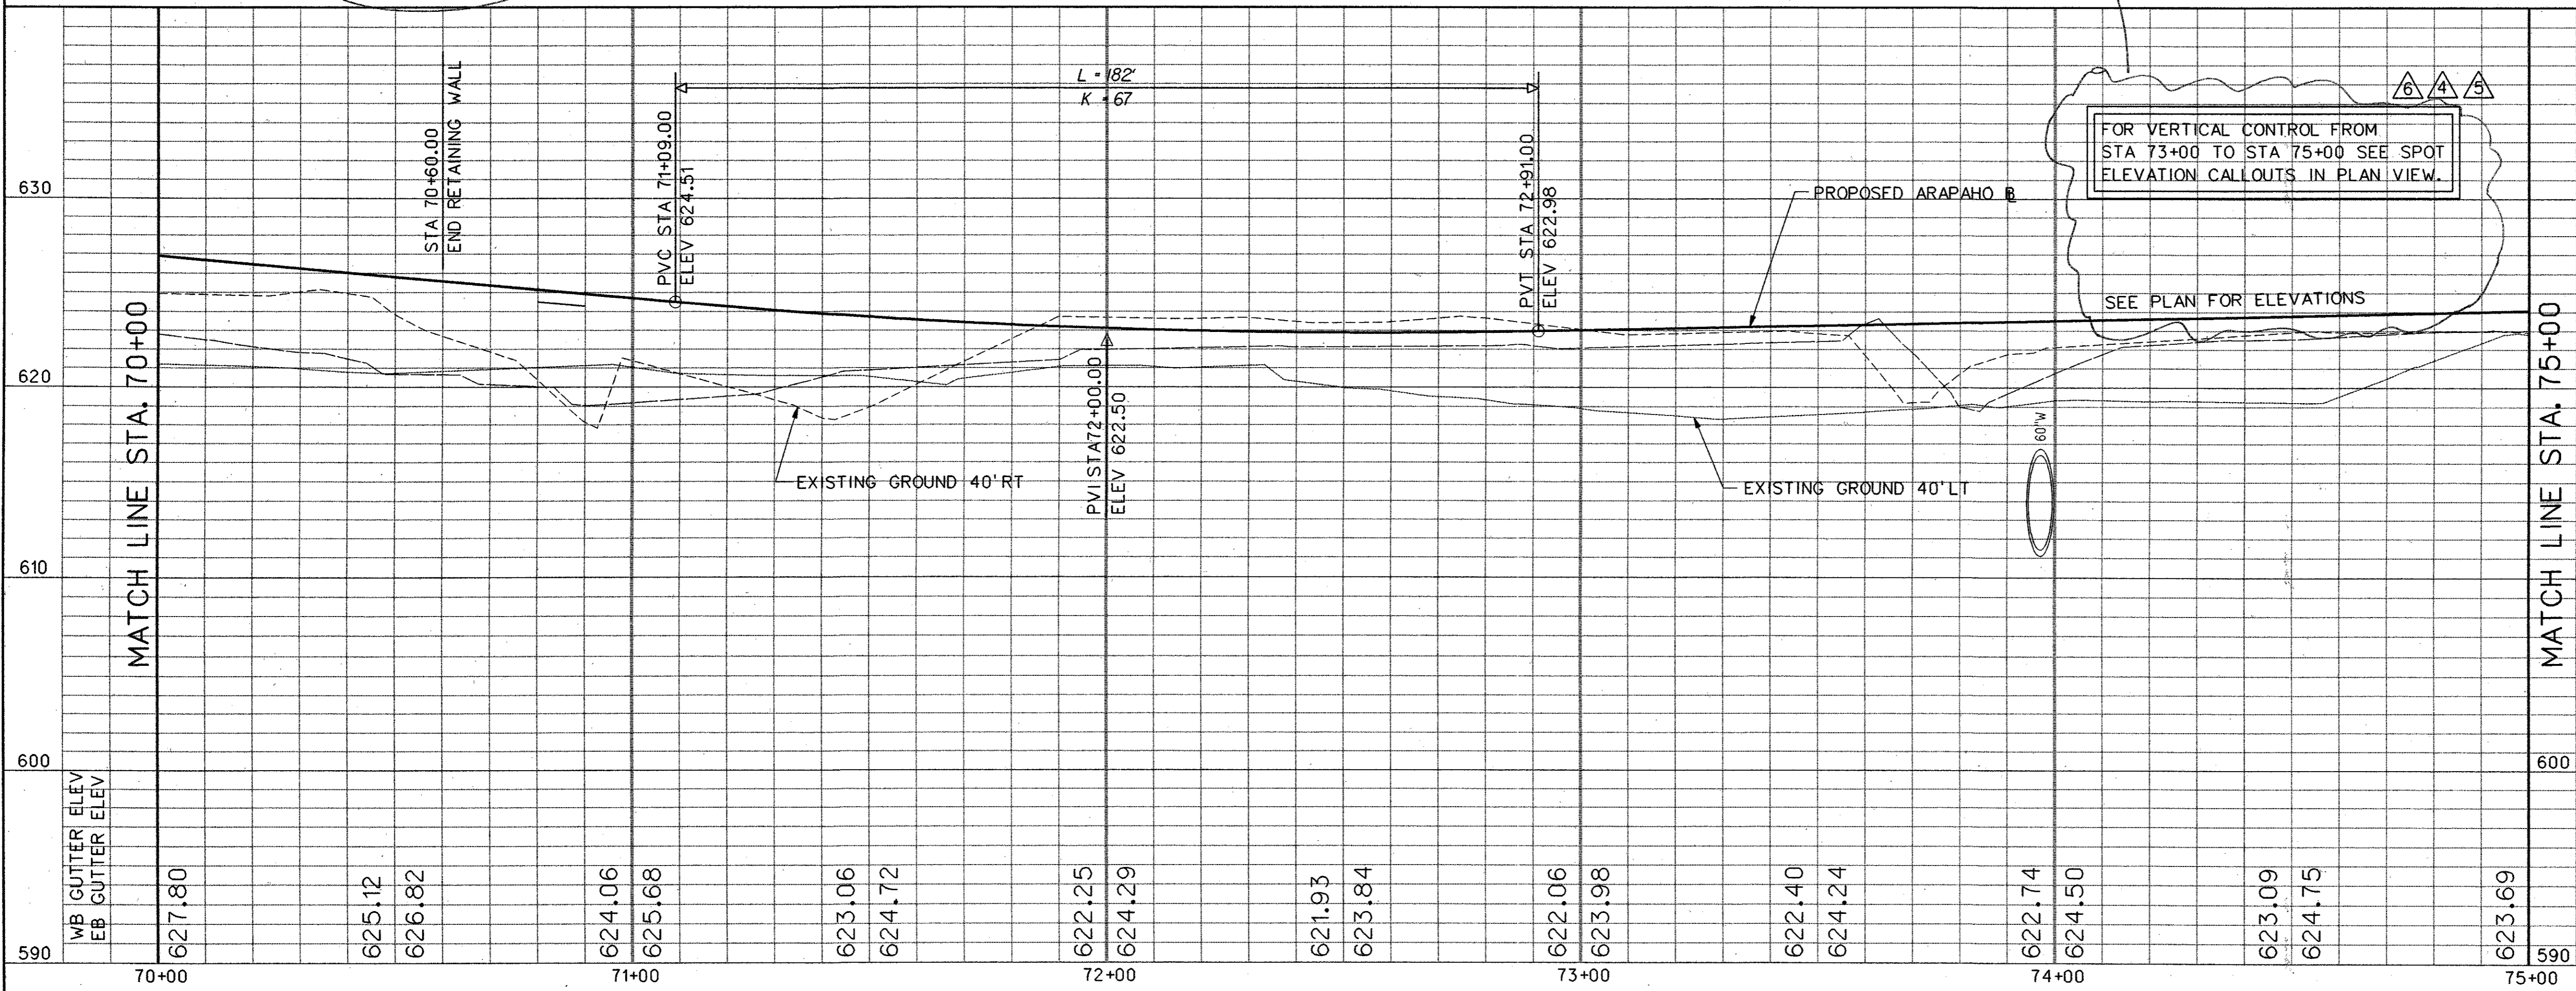

NO.	DATE	REVISION	APPROV.
6	6-6-05	REVISED GUTTER SPOT ELEVATIONS	JDH

**HNTB** ARCHITECTS ENGINEERS PLANNERS  
The HNTB Companies

**ARAPAHO ROAD - PHASE III**  
SURVEYOR BOULEVARD TO ADDISON ROAD

PAVING PLAN AND PROFILE  
STA 70+00 TO STA 75+00

TOWN OF ADDISON, TEXAS

Design JSN Drawn GFS DATE SCALE PROJECT NO. SHEET NO.  
Check JDH Check JSN APRIL 04 H: 1"=20' V: 1"=5' 25768 PP-9

07-JUN-2005 10:18 C:\cs\ar3pp09.dgn