


LEGEND

- 614 — EXISTING CONTOUR
- 612.5 — PROPOSED CONTOUR
- x 612.42 PROPOSED SPOT GRADE

NOTE:
 GRADING OUTSIDE PARKING LAYOUT
 ON THESE PLANS IS FOR ROUGH
 GRADING. CONTRACTOR TO
 REFERENCE LANDSCAPE PLANS FOR
 FINAL GRADES AND ELEVATIONS FOR
 TRAIL LAYOUT AND LANDSCAPING
 SCHEME.

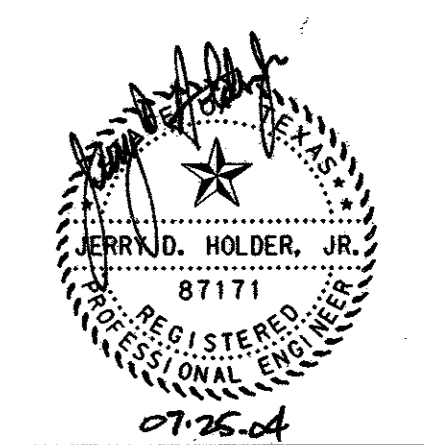

NO.		DATE	REVISION	APPROV.	61
HNTB ARCHITECTS ENGINEERS PLANNERS The HNTB Companies					
ARAPAHO ROAD - PHASE III					
SURVEYOR BOULEVARD TO ADDISON ROAD					
GRADING PLAN					
MBNA					
TOWN OF ADDISON, TEXAS					
Design JSN	Drawn GFS	DATE	SCALE	PROJECT NO.	SHEET NO.
Check JDH	Check JSN	APRIL 04	H: 1" = 20'	25768	G-1

29-JUN-2004 12:30
G:\25768-ph3\NH\CCS\dr3gd02.dgn