


ITEM NO.	DESCRIPTION & UNIT PRICE IN WORDS	UNIT	EST. QTY.
SIGNALIZATION AND LIGHTING IMPROVEMENTS			
301	TRAFFIC SIGNALS - ARAPAHO ROAD AT ADDISON ROAD	L.S.	1
302	TRAFFIC SIGNALS - ARAPAHO ROAD AT SURVEYOR BLVD.	L.S.	1
303	CONDUIT, 2" SCHEDULE 40 PVC	L.F.	11003
304	CONDUIT, 2" SCHEDULE 40 PVC, BORED AND TRENCHED	L.F.	108
305	CONDUIT, 4" SCHEDULE 40 PVC, BORED AND TRENCHED	L.F.	195
306	CONDUIT (RM) (1 1/2")	L.F.	243
307	35'-3" STREET LIGHT POLE	EA.	9
308	PEDESTRIAN LIGHT POLE	EA.	64
309	COMBINATION, STREET LIGHT W/PEDESTRIAN FIXTURE	EA.	13
310	RETAINING WALL MOUNTED LIGHT POLE	EA.	4
311	70W WALL MOUNTED LUMINAIRE FIXTURE	EA.	4
312	CABLE, INSULATED #6 AWG	L.F.	22706
313	CABLE, INSULATED #8 AWG	L.F.	770
314	BARE GROUND, #8 AWG	L.F.	385
315	BARE GROUND, #6 AWG	L.F.	11353
316	CABLE, INSULATED #4 AWG	L.F.	780
317	BARE GROUND, #4 AWG	L.F.	390
318	FOUNDATION, 35'-3" STREET LIGHT POLE	EA.	21
319	FOUNDATION, PEDESTRIAN LIGHT POLE	EA.	64
320	GROUND MOUNTED PULL BOX, TYPE A	EA.	24
321	GROUND MOUNTED PULL BOX, TYPE C	EA.	1
322	LIGHTING CONTROL CABINET	EA.	3

NOTES:

LIGHTING CONTROL CABINET INCLUDES FOUNDATION, CABINET, INTERNAL CONTROL DEVICES, INTERNAL WIRING, AND ALL INCIDENTALS NECESSARY TO COMPLETE THE WORK.

ITEM NO.	DESCRIPTION & UNIT PRICE IN WORDS	UNIT	EST. QTY.
STREETSCAPE IMPROVEMENTS			
401	FURNISH AND INSTALL SHUMARD OAK (4" CAL.)	EA.	36
402	FURNISH AND INSTALL SHANTUNG MAPLE (3" CAL.)	EA.	37
403	FURNISH AND INSTALL SAVANNAH HOLLY (30 GAL. SPECIMEN)	EA.	105
404	FURNISH AND INSTALL VITEX/CHASTE TREE (30 GAL. SPECIMEN)	EA.	8
405	FURNISH AND INSTALL CREPE MYRTLE (30 GAL.)	EA.	43
406	FURNISH AND INSTALL DWARF BUFORD HOLLY (5 GAL.)	EA.	225
407	FURNISH AND INSTALL FRINGE FLOWER (5 GAL.)	EA.	108
408	FURNISH AND INSTALL HARBOR DWARF NANDINA (3 GAL.)	EA.	263
409	FURNISH AND INSTALL MARY NELL HOLLY (5 GAL.)	EA.	178
410	FURNISH AND INSTALL PURPLE WINTERCREEPER (1 GAL.)	EA.	1727
411	FURNISH AND INSTALL ASIAN JASMINE (1 GAL.)	EA.	14706
412	FURNISH AND INSTALL INDIAN GRASS (5 GAL.)	EA.	66
413	FURNISH AND INSTALL BUSHY BLUESTEM GRASS (5 GAL.)	EA.	130
414	FURNISH AND INSTALL LITTLE BLUESTEM GRASS (3 GAL.)	EA.	615
415	FURNISH AND INSTALL LINDHEIMER'S MUHLY (3 GAL.)	EA.	104
416	FURNISH AND INSTALL SOLID SOD (BERMUDA)	S.Y.	12800
417	FURNISH AND INSTALL HYDROMULCH (BERMUDA)	S.Y.	105,082
418	FURNISH AND INSTALL TREE PROTECTION	L.F.	4000
419	FURNISH AND PLACE COMPOST IN TURF AREAS (SOD ONLY)	C.Y.	363
420	FURNISH AND INSTALL FINELY SHREDED HARDWOOD BARK MULCH	C.Y.	346
421	FURNISH AND INSTALL BED PREPARATION WITH COMPOST	C.Y.	346
422	FURNISH AND INSTALL IRRIGATION SYSTEM, TURNKEY	L.S.	1
423	FURNISH AND INSTALL CROSSWALK BRICK PAVERS (SEE SPECS)	S.F.	2016
424	FURNISH AND INSTALL MEDIAN PAVERS (SEE SPECS)	S.F.	3724
425	FURNISH AND INSTALL WALKWAY PAVERS (SEE SPECS)	S.F.	4472
426	FURNISH AND PLACE 5" REINFORCED CONCRETE PAVING	S.F.	43207
427	FURNISH AND PLACE 5" REINFORCED CONCRETE PATH	S.F.	28845
428	FURNISH AND PLACE 12" CONCRETE BANDS	L.F.	2396
429	EMBANKMENT	C.Y.	248
430	FURNISH AND INSTALL FLUSH CONCRETE STRIPS (2'X10')	S.F.	20
431	FURNISH AND PLACE DECOMPOSED GRANITE PAVING	S.F.	32488
432	FURNISH AND PLACE RIVER COBBLES WITH DRAIN PIPE, IF SHOWN	C.Y.	59
433	FURNISH AND INSTALL FLAGSTONE PAVING	S.F.	6100
434	FURNISH AND INSTALL ADA RAMP	EA.	7
435	FURNISH AND INSTALL TREE GRATE	EA.	22
436	FURNISH AND PLACE CONCRETE BENCHES (18" HT.)	EA.	3

ITEM NO.	DESCRIPTION & UNIT PRICE IN WORDS	UNIT	EST. QTY.
STREETSCAPE IMPROVEMENTS			
437	FURNISH AND INSTALL CMU WALL (INCLUDES FOOTING)	L.F.	144
438	FURNISH AND INSTALL BRICK VENEER (SEE SPECS)	S.F.	608
439	FURNISH AND INSTALL CAST STONE CAP	L.F.	144
440	FURNISH AND INSTALL MODULAR RETAINING WALL SYSTEM (MESA)	S.F.	1708
441	FURNISH AND INSTALL SECURITY FENCE ON RETAINING WALL	L.F.	477
442	FURNISH AND INSTALL DECORATIVE METAL FENCE	L.F.	895
443	FURNISH AND INSTALL DECORATIVE METAL GATE	EA.	1
444	FURNISH AND PLACE BRICK COLUMNS	EA.	6
445	FURNISH AND INSTALL PEDESTAL VOICE COMMUNICATION UNIT (INCLUDES FOOTING)	EA.	3
446	FURNISH AND INSTALL STEEL EDGING	L.F.	484

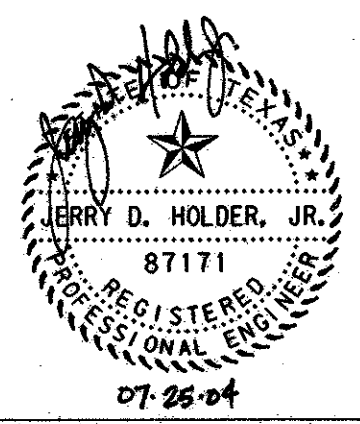

NO.	DATE	REVISION	APPROV.
5	6-01-04	REISSUE SHEET	JSN
3	5-24-04	REISSUE SHEET	JSN

7

**HNTB** ARCHITECTS ENGINEERS PLANNERS  
The HNTB Companies

**ARAPAHO ROAD - PHASE III**  
SURVEYOR BOULEVARD TO ADDISON ROAD

**SIGNALIZATION & LIGHTING AND STREETSCAPE QUANTITIES**

TOWN OF ADDISON, TEXAS

Design	Drawn	DATE	SCALE	PROJECT NO.	SHEET NO.
Check	Check	APRIL 04		25768	Q-3

29-JUN-2004 12:07 G:\25768-phs\m\l\cds\ar3qt03.dgn