
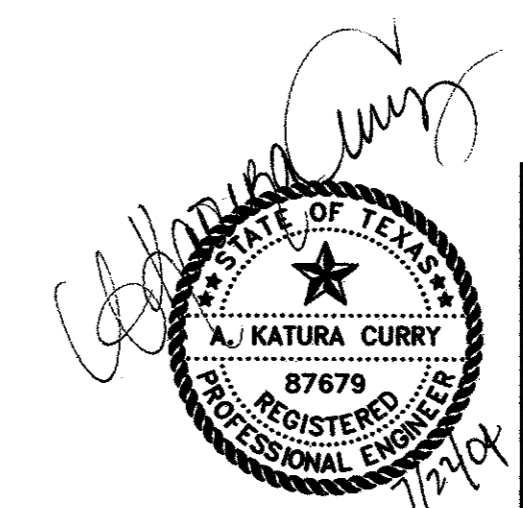
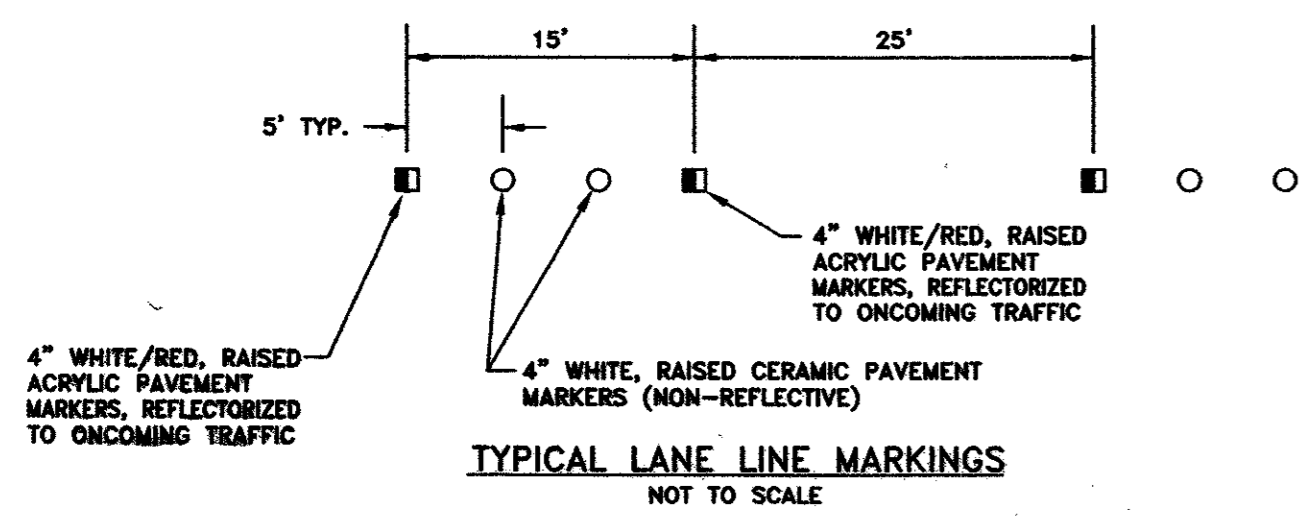
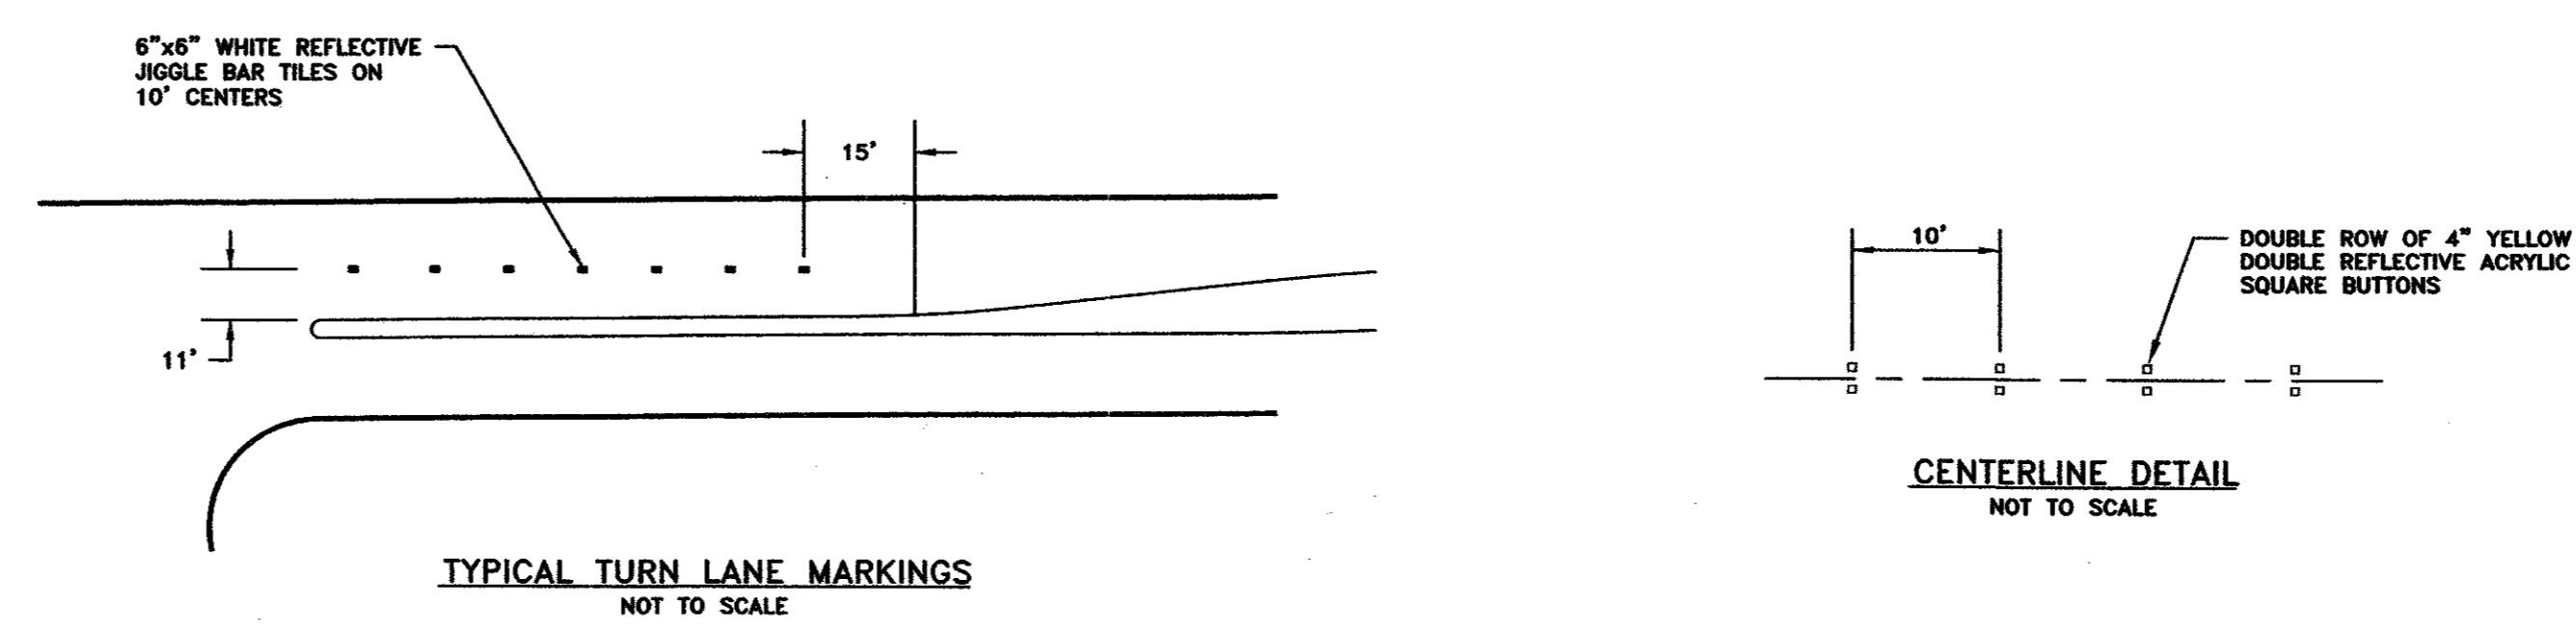
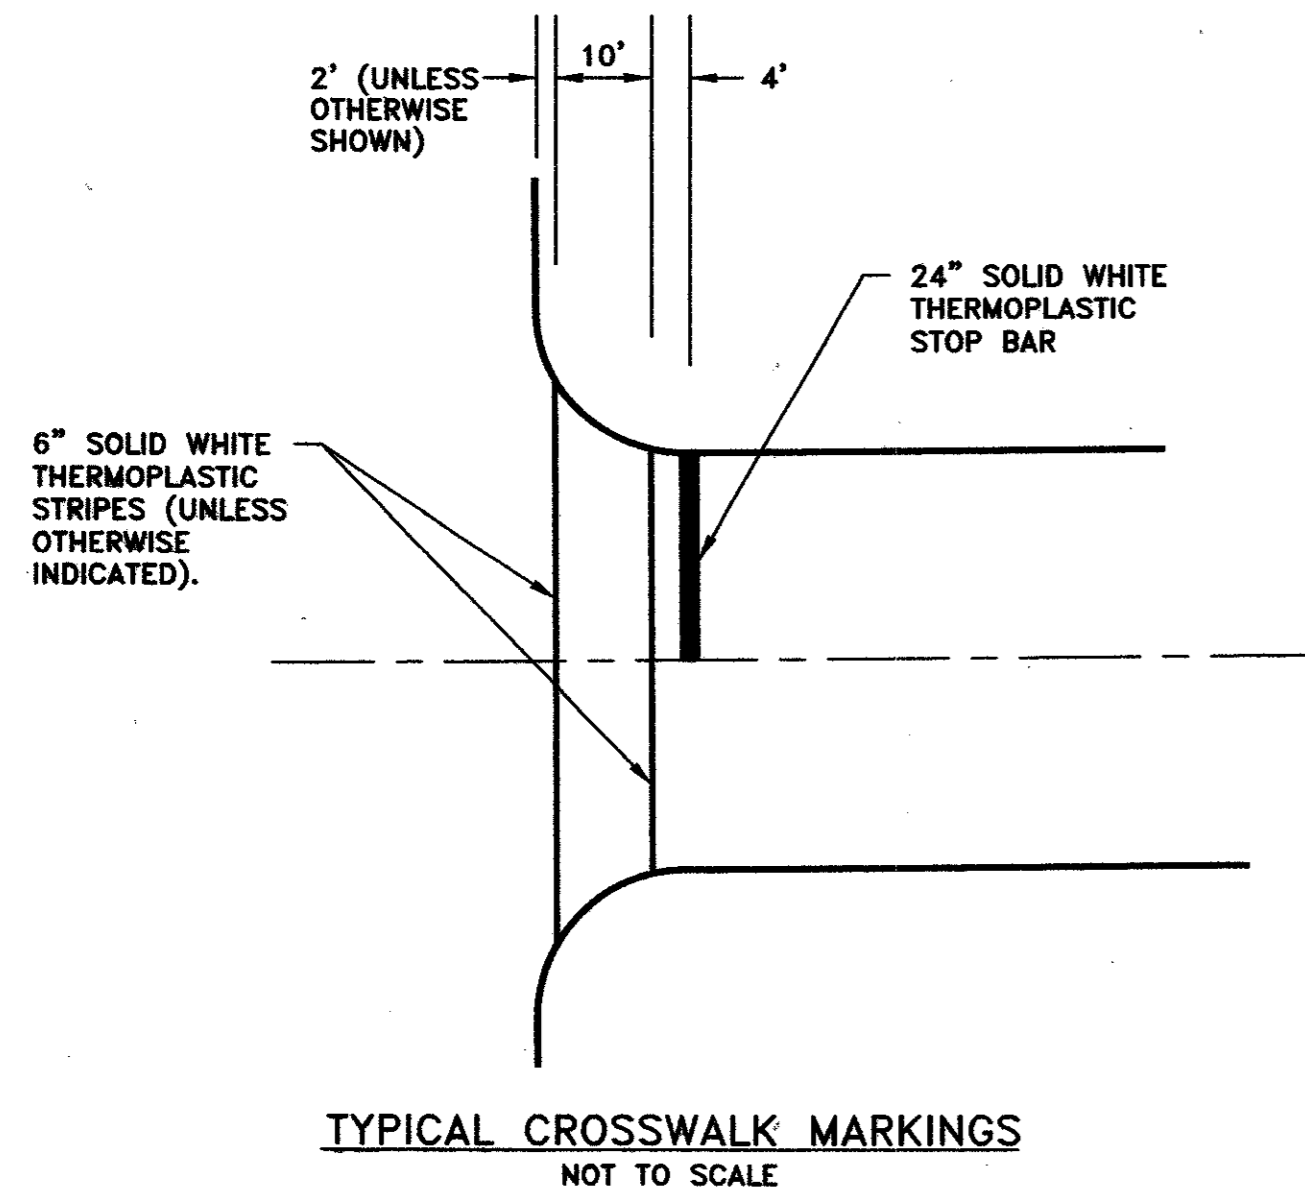


NO.	DATE	REVISION	APPROV.
1			
2	07/21/04	REVISED PER G&A	A.K.C.
3			

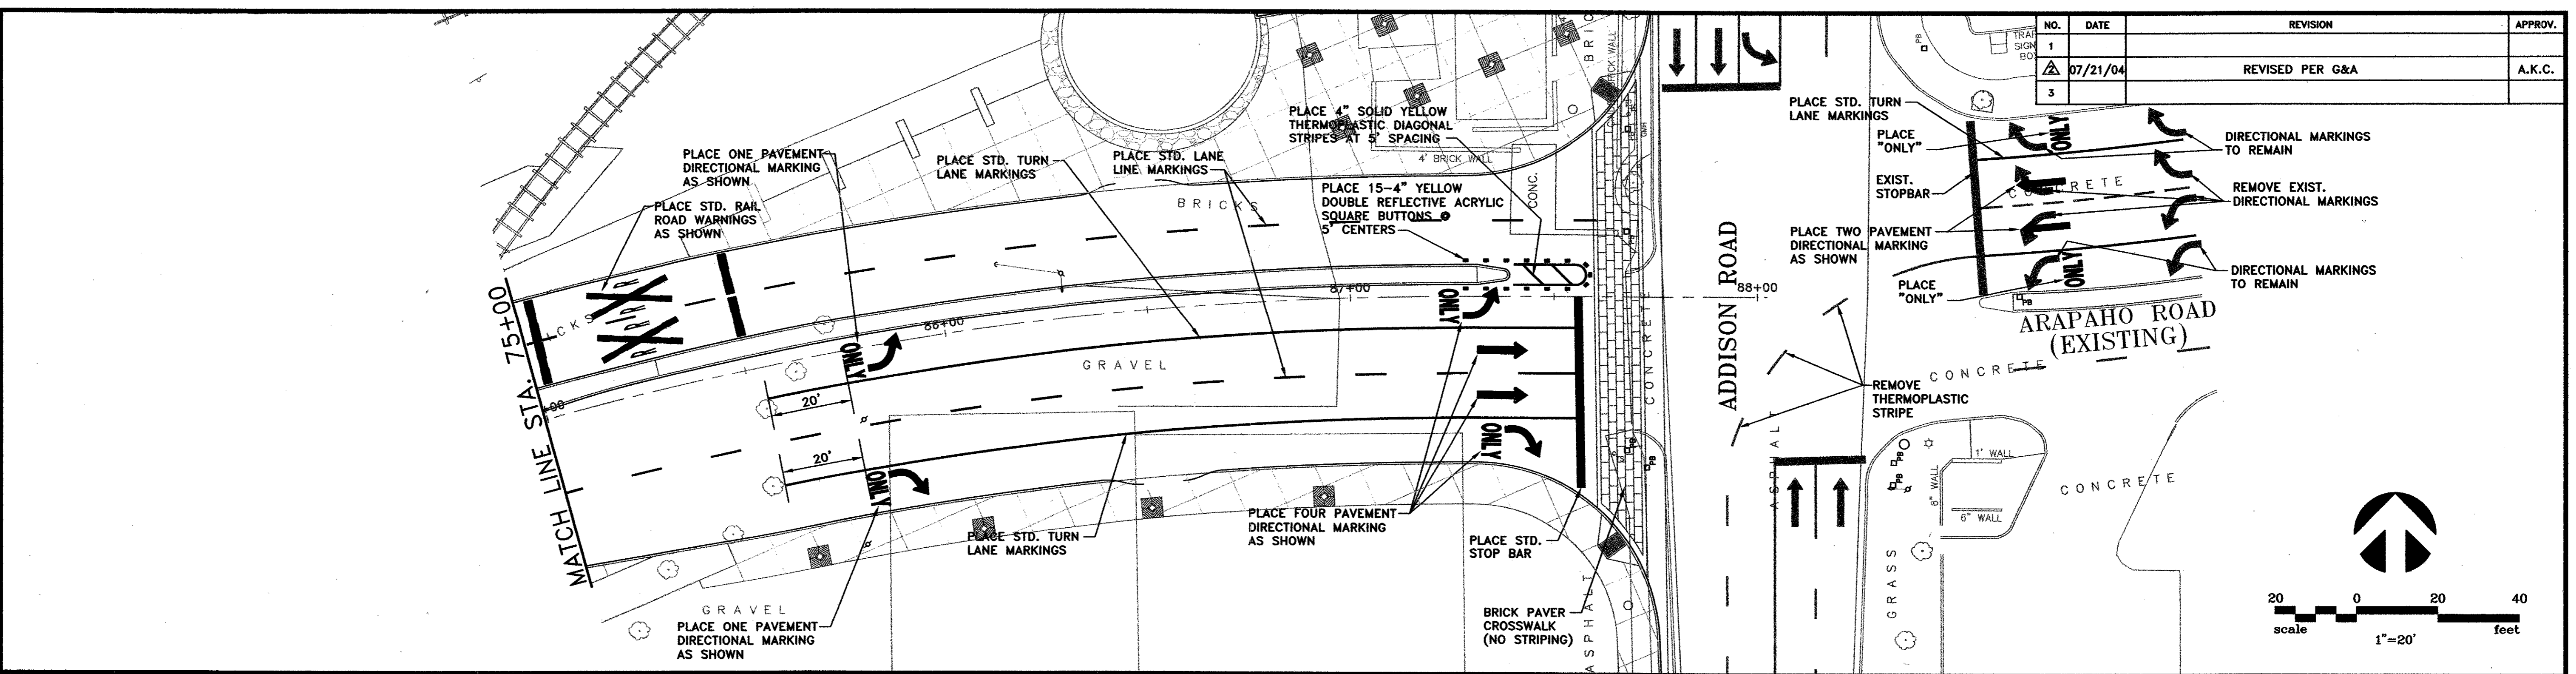

THE SEAL APPEARING ON THIS DOCUMENT WAS AUTHORIZED BY:
A. KATURA CURRY
ON 7-21-04.
ALTERATION OF A SEALED DOCUMENT WITHOUT PROPER NOTIFICATION TO THE RESPONSIBLE ENGINEER IS AN OFFENSE UNDER THE TEXAS ENGINEERING PRACTICE ACT.

DATE:	MAY 2004	SCALE:	1"=20'	JOB NO.:	02-320
DRAWN:	G&A	DESIGN:	AKC	REVIEWED:	DWG: 320STRIP01.DWG
ARAPAHO ROAD PHASE III					
STRIPING PLAN					
STA. 85+00 TO END					
TOWN OF ADDISON					
g&a Grantham & Associates, Inc.				SHT. ST-7	
1919 S. SHILOH ROAD, SUITE 310, L.B. 8 GARLAND, TEXAS 75042				(972) 864-2333 (TEL) (972) 864-2334 (FAX)	