


- LEGEND:**
- DRAINAGE DIVIDE
 - - - EXISTING STORM SEWER SYSTEM
 - PROPOSED STORM SEWER SYSTEM
 - DRAINAGE AREA
 - 1.66 ACRES
 - 8.0 Q_{100}

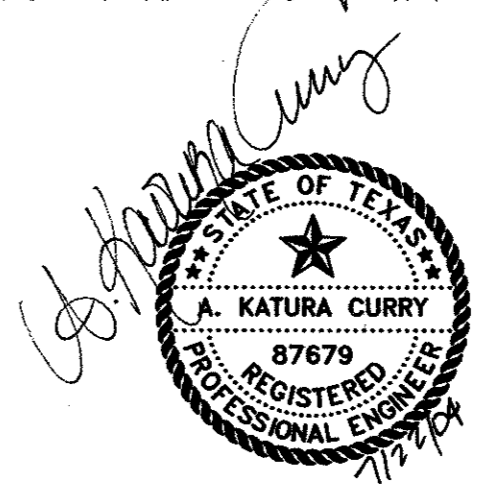

THE SEAL APPEARING ON THIS DOCUMENT WAS AUTHORIZED BY:
 A. KATURA CURRY
 ON 7-21-04.
 ALTERATION OF A SEALED DOCUMENT WITHOUT PROPER NOTIFICATION TO THE RESPONSIBLE ENGINEER IS AN OFFENSE UNDER THE TEXAS ENGINEERING PRACTICE ACT.

DATE:	MAY 2004	SCALE:	1"=200'	JOB NO.:	02-320
DRAWN:	G&A	DESIGN:	AKC	REVIEWED:	BRG
DWG:		320DRNAREA			
ARAPAHO ROAD PHASE III					
DRAINAGE AREA MAP - SHEET 2					
TOWN OF ADDISON					
g&a		Grantham & Associates, Inc.		SHT. D-2	
1919 S. SHILOH ROAD, SUITE 310, L.B. 8 GARLAND, TEXAS 75042				(972) 864-2333 (TEL) (972) 864-2334 (FAX)	

MATCH LINE STA. 59+00