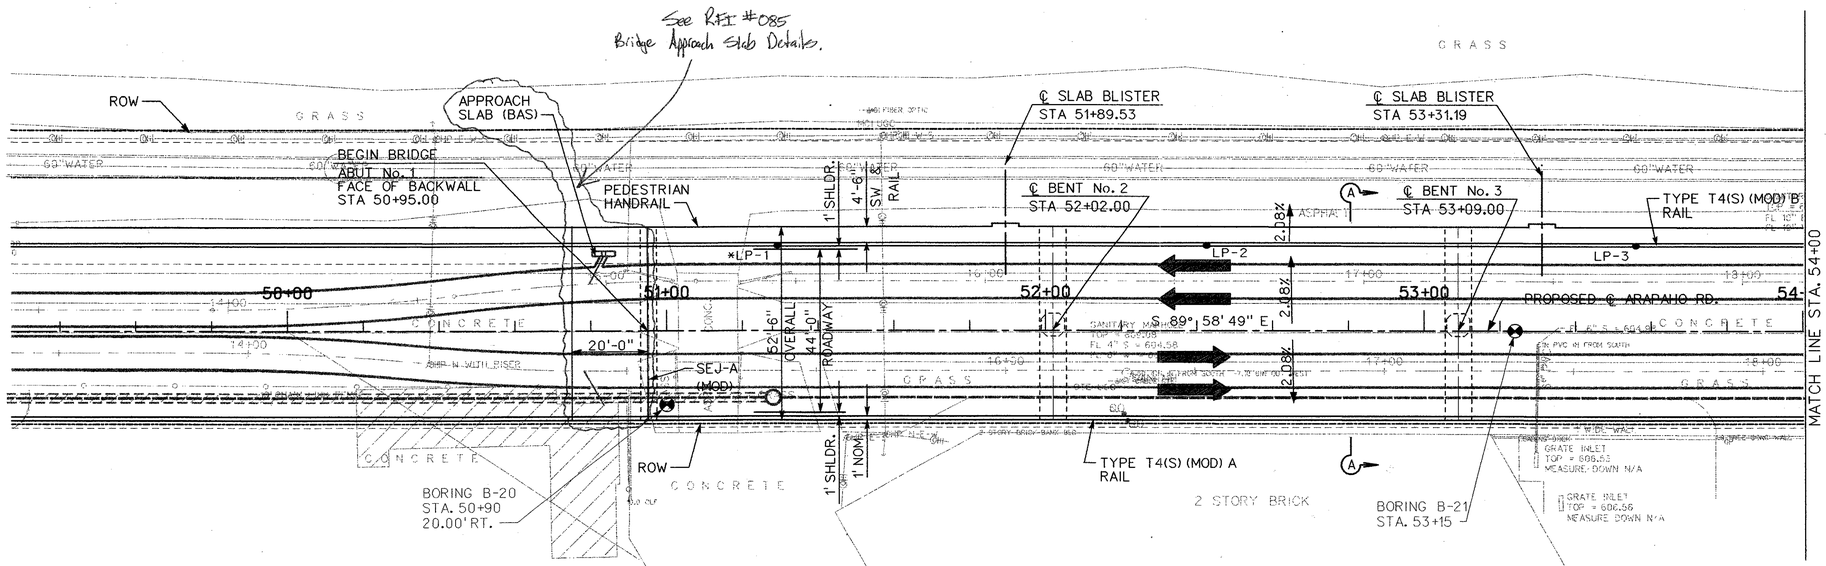

* SEE SHEET 4 OF 4 FOR ℄ LIGHT POLE LOCATIONS.

PROJECT RECORD COPY

0 20 40 60 80
SCALE IN FEET

GENERAL NOTES:

1. DESIGNED IN ACCORDANCE WITH AASHTO "STANDARD SPECIFICATIONS FOR HIGHWAY BRIDGES" - 16TH EDITION WITH CURRENT INTERIM SPECIFICATIONS, FOR HS20-44 LOADING.
2. ALL DIMENSIONS ARE EITHER HORIZONTAL OR VERTICAL AND MUST BE CORRECTED FOR GRADE, CROWN, AND/OR SUPERELEVATION.
3. ALL BENTS ARE RADIAL UNLESS NOTED OTHERWISE.
4. SEE TEXAS DEPARTMENT OF TRANSPORTATION'S "STANDARD SPECIFICATIONS FOR CONSTRUCTION OF HIGHWAYS, STREETS AND BRIDGES, 1993" FOR THE CONTROLLING CONSTRUCTION SPECIFICATIONS FOR THE BRIDGE.
5. REFER TO BRIDGE LIGHTING PLANS AND BRIDGE LIGHTING DETAILS FOR LOCATIONS AND TYPES OF CONDUIT AND LIGHT FIXTURES. CONTRACTOR IS RESPONSIBLE FOR MOUNTING DETAILS BASED ON LIGHT MANUFACTURES RECOMMENDATIONS.
6. CONTRACTOR IS RESPONSIBLE FOR PROTECTING THE 60" WATER LINE THROUGHOUT CONSTRUCTION.
7. FOR SECTIONS A-A AND B-B SEE TYPICAL SECTIONS SHEET.
8. FOR COLOR SCHEME, SEE SURFACE FINISHES FOR STRUCTURES SHEET.
9. BEAM END CONDITIONS:
   D = DENOTES EXPANSION ALIGNMENT DEVICE (SLOTTED HOLE) IN SLAB.
10. CONTRACTOR TO SUPPLY AND MOUNT TWO 24"x24" BRONZE MONUMENT PLAQUES. CONTRACTOR SHALL COORDINATE WITH THE TOWN OF ADDISON FOR LOCATION, WORDING AND MOUNTING DETAILS FOR THE PLAQUES.

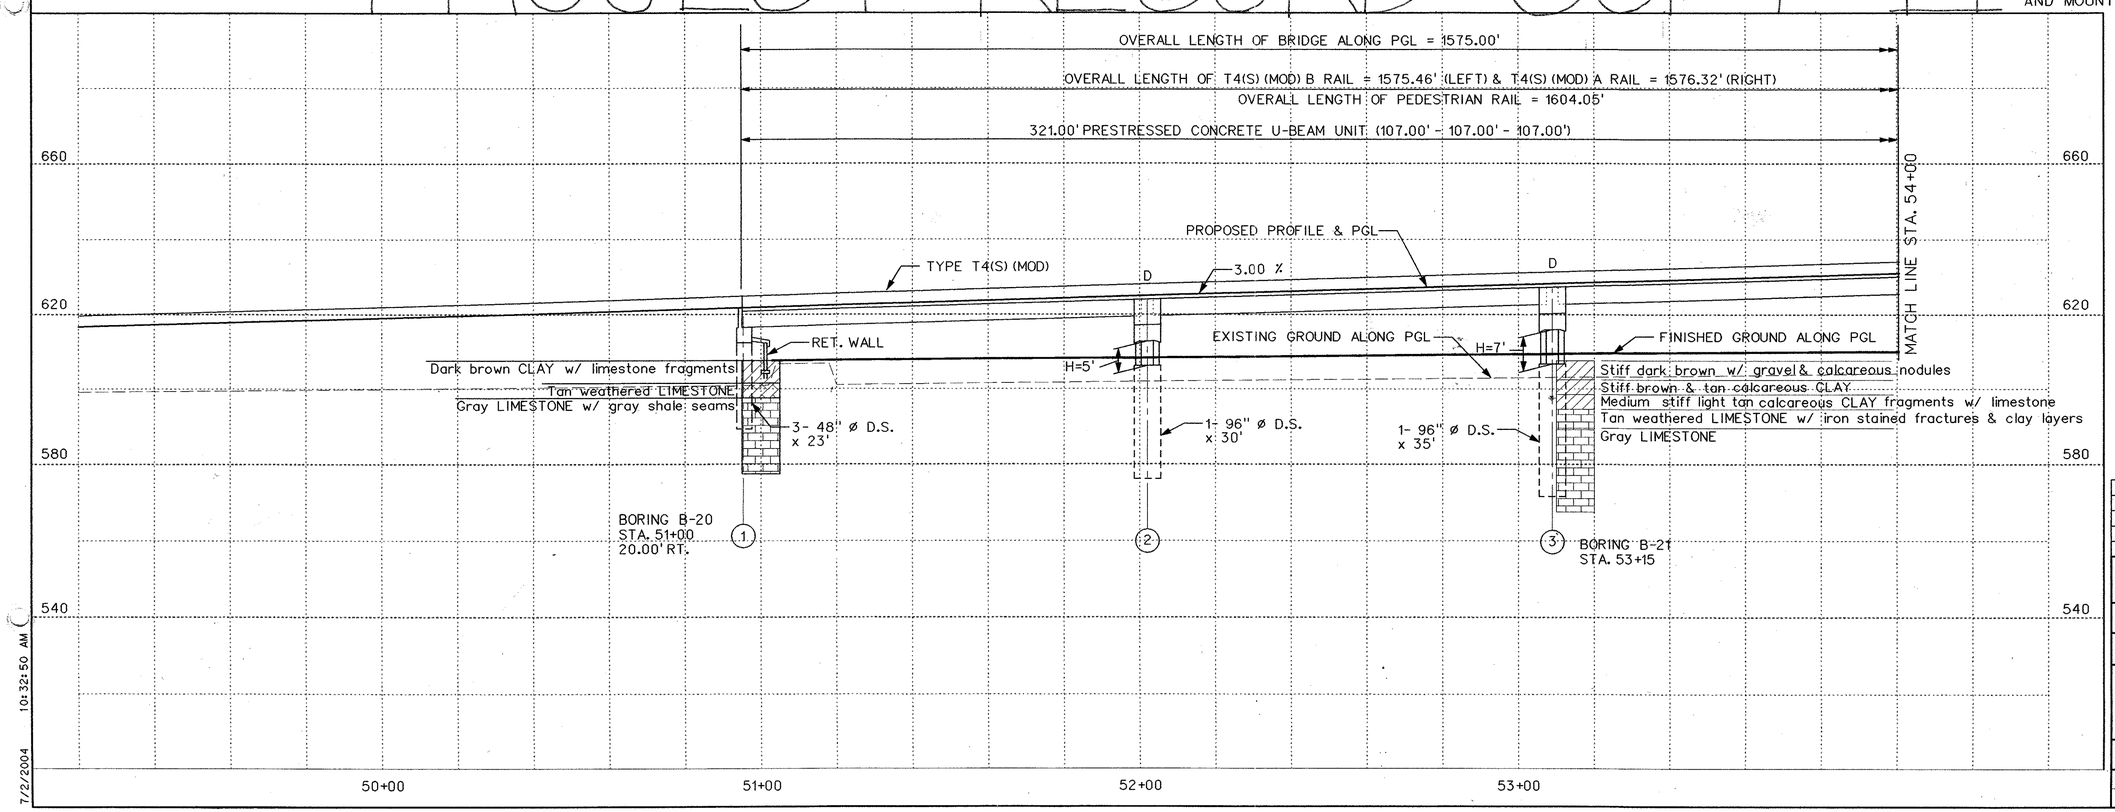

STATE OF TEXAS
CLIFF R. HALL
82211
REGISTERED PROFESSIONAL ENGINEER
7/2/04

239

NO.	DATE	REVISION	APPROV.

URS
GREYSTONE CENTRE
3010 LBJ FREEWAY, SUITE 1300
DALLAS, TX 75234

ARAPAHO ROAD - PHASE III

SURVEYOR BOULEVARD TO ADDISON ROAD

BRIDGE LAYOUT

SHEET 1 OF 4

TOWN OF ADDISON, TEXAS

Design	Drawn	DATE	SCALE	PROJECT NO.	SHEET NO.
Check	Check	05-07-04		25768	BR-1

7/2/2004 10:32:50 AM

\\urs\dal\data\projects\arapaho road bridge\cadd\structures\bridge layouts\ar3ab101.dgn