



TABLE OF ESTIMATED QUANTITIES


BAR	NO.	SIZE	LENGTH	WEIGHT
A	14	#11	52'-2"	3880
G	51	#5	14'-1 1/4"	750
H	22	#5	52'-2"	1197
J	2	#5	10'-9 1/4"	23
S	98	#6	17'-1"	2515
U	28	#5	4'-10 1/4"	142
TOTAL LBS.				8,507
ITEM			UNIT	QUANTITY
REINFORCING STEEL			LB	8,507
CL "F" CONC (CAP)			CY	41.9

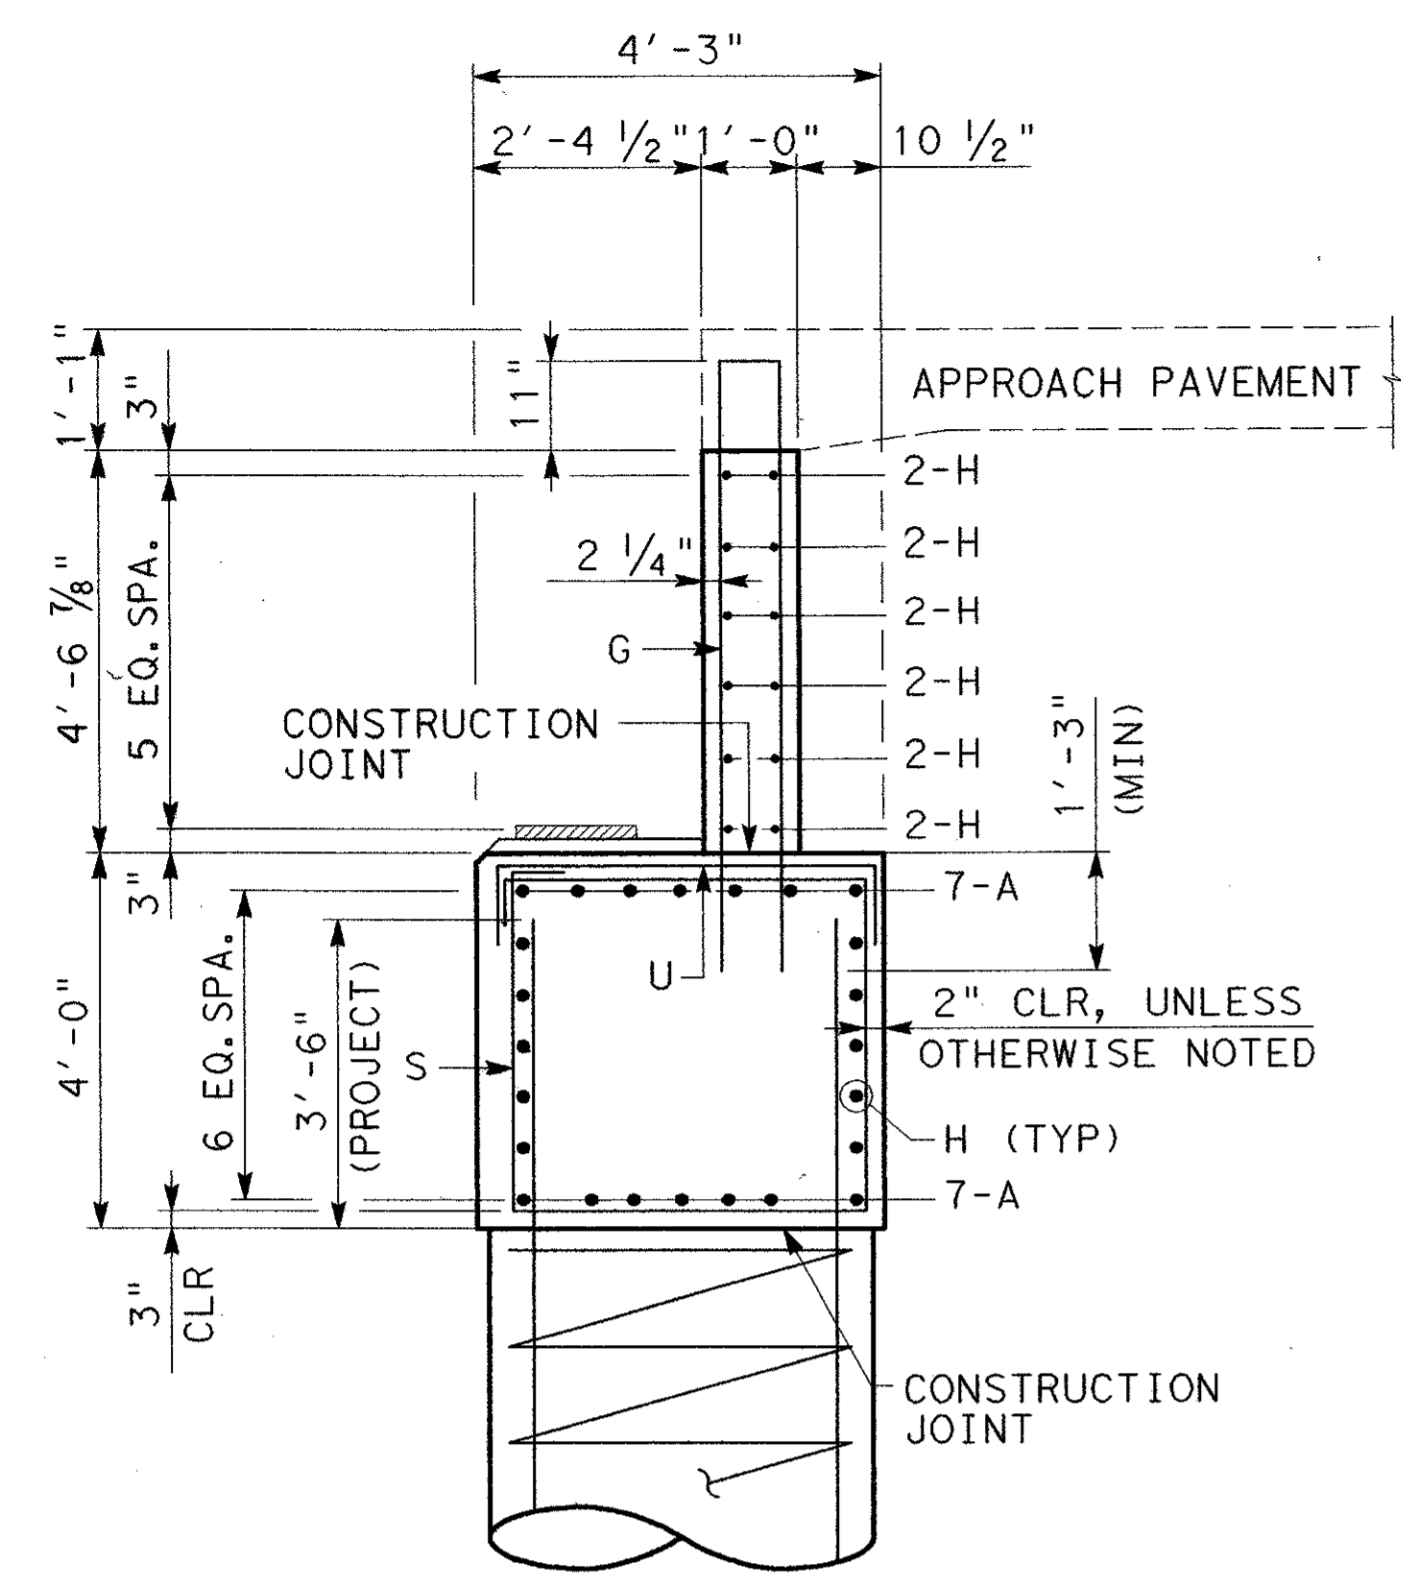


SECTION A-A

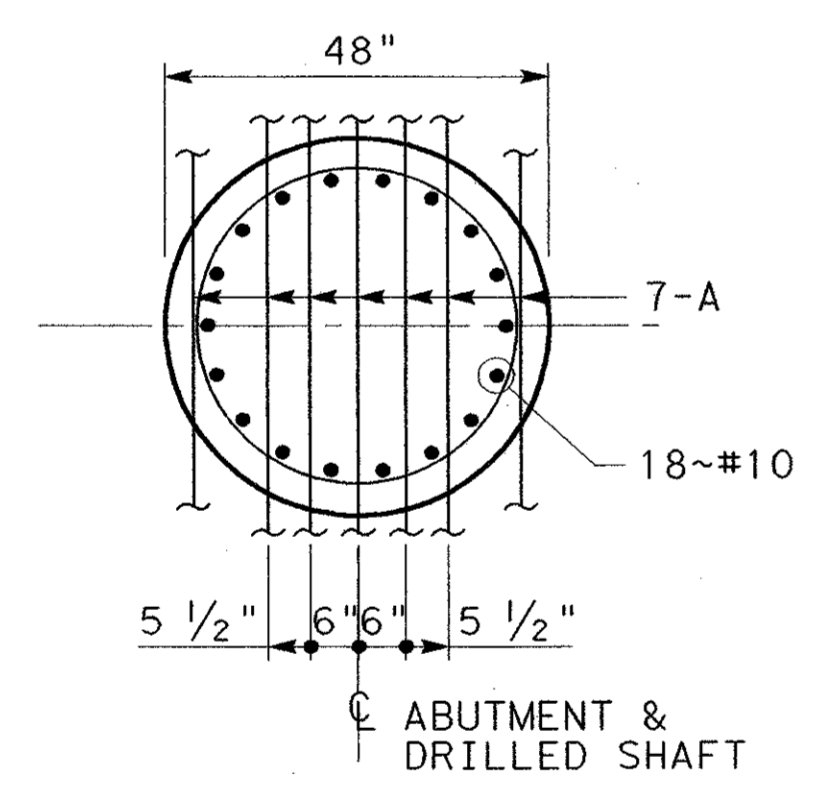


PLAN

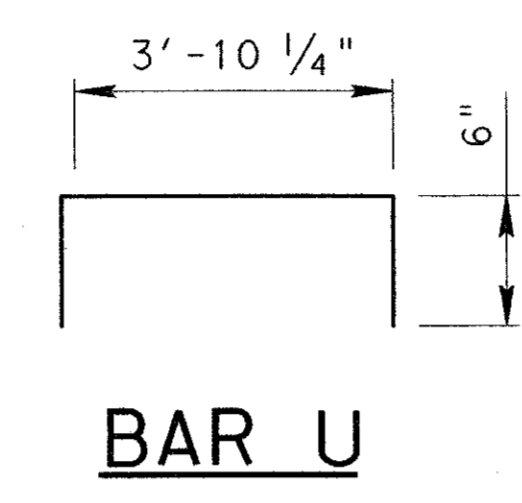

BAR U

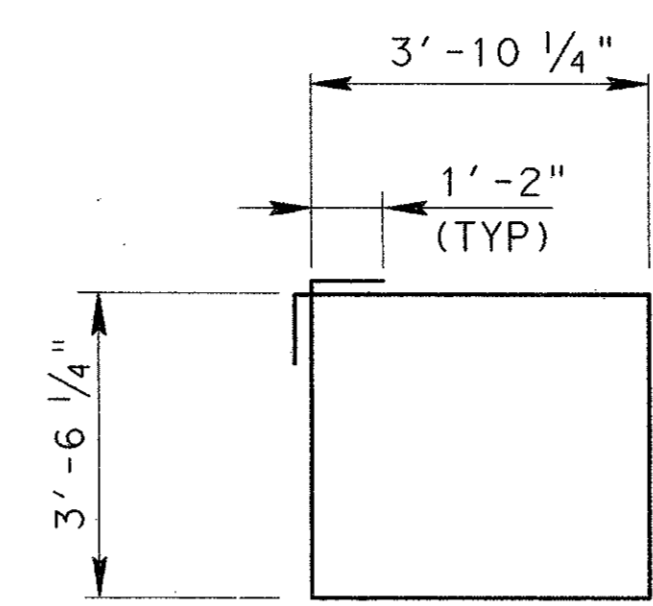

BAR S

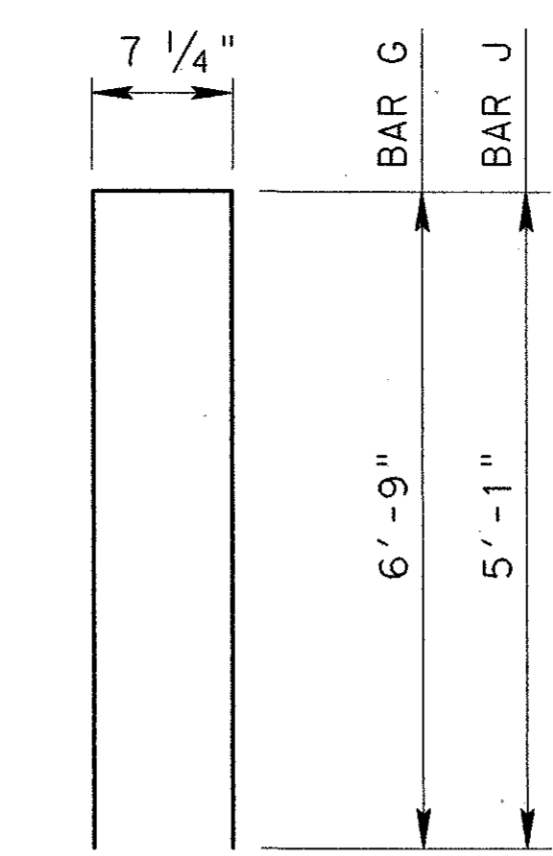

BAR G & J



NO.	DATE	REVISION	APPROV.	253
GREYSTONE CENTRE 2010 LBJ FREEWAY, SUITE 1300 DALLAS, TX 75204				
ARAPAHO ROAD - PHASE III SURVEYOR BOULEVARD TO ADDISON ROAD				
ABUTMENT 1 DETAILS SHEET 2 OF 2				
TOWN OF ADDISON, TEXAS				
Design	Drawn	DATE	SCALE	PROJECT NO. SHEET NO.
Check	Check	05-07-04		25768 BR-15