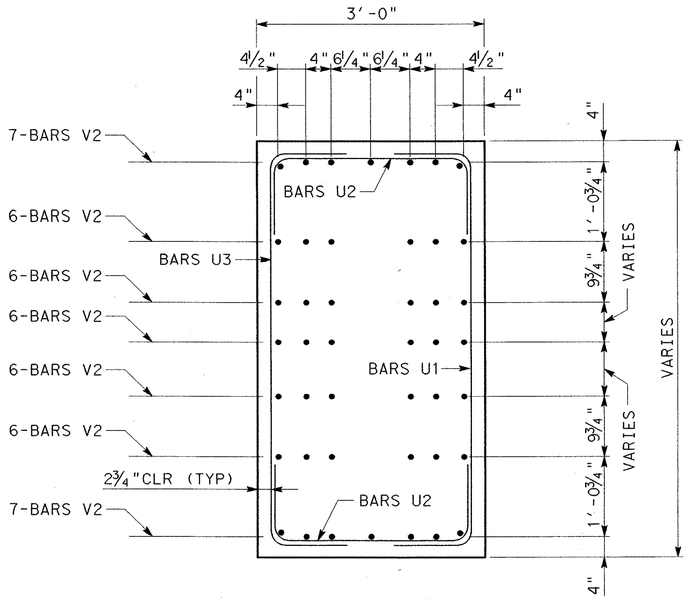

SECTION G-G

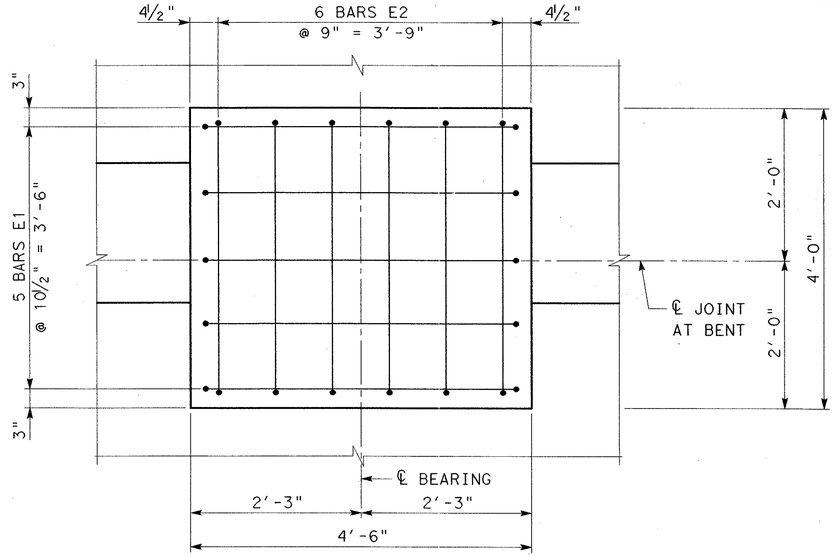

PLAN - PEDESTAL REINFORCING

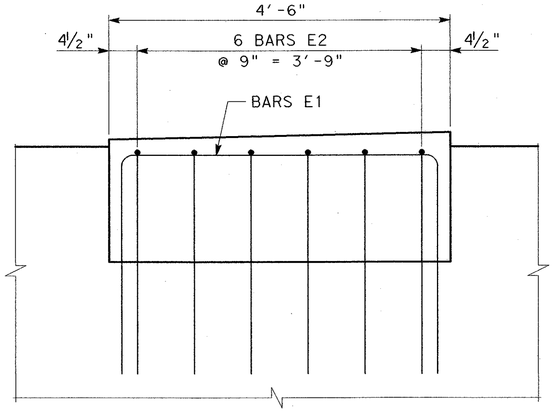

ELEVATION - PEDESTAL REINFORCING

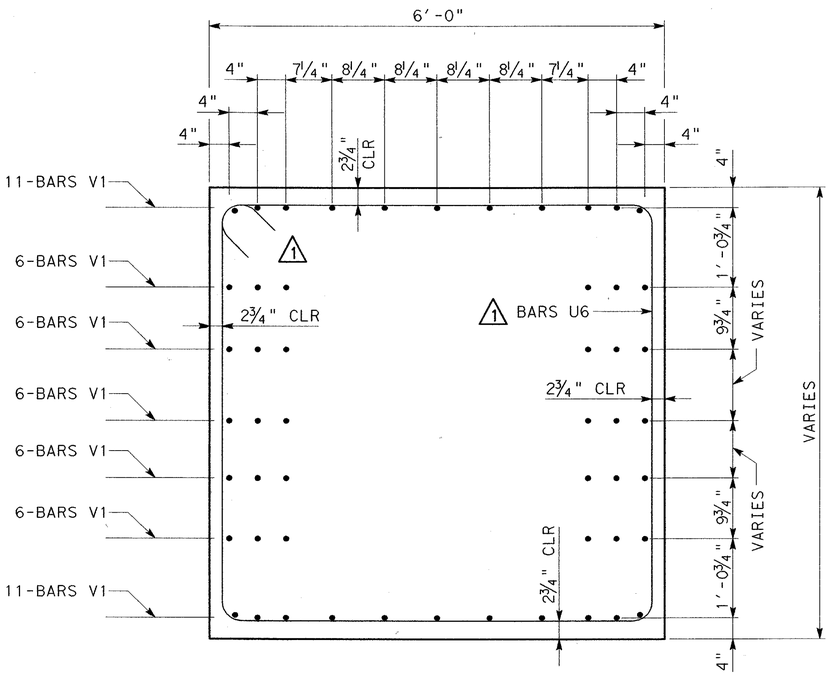

SECTION F-F

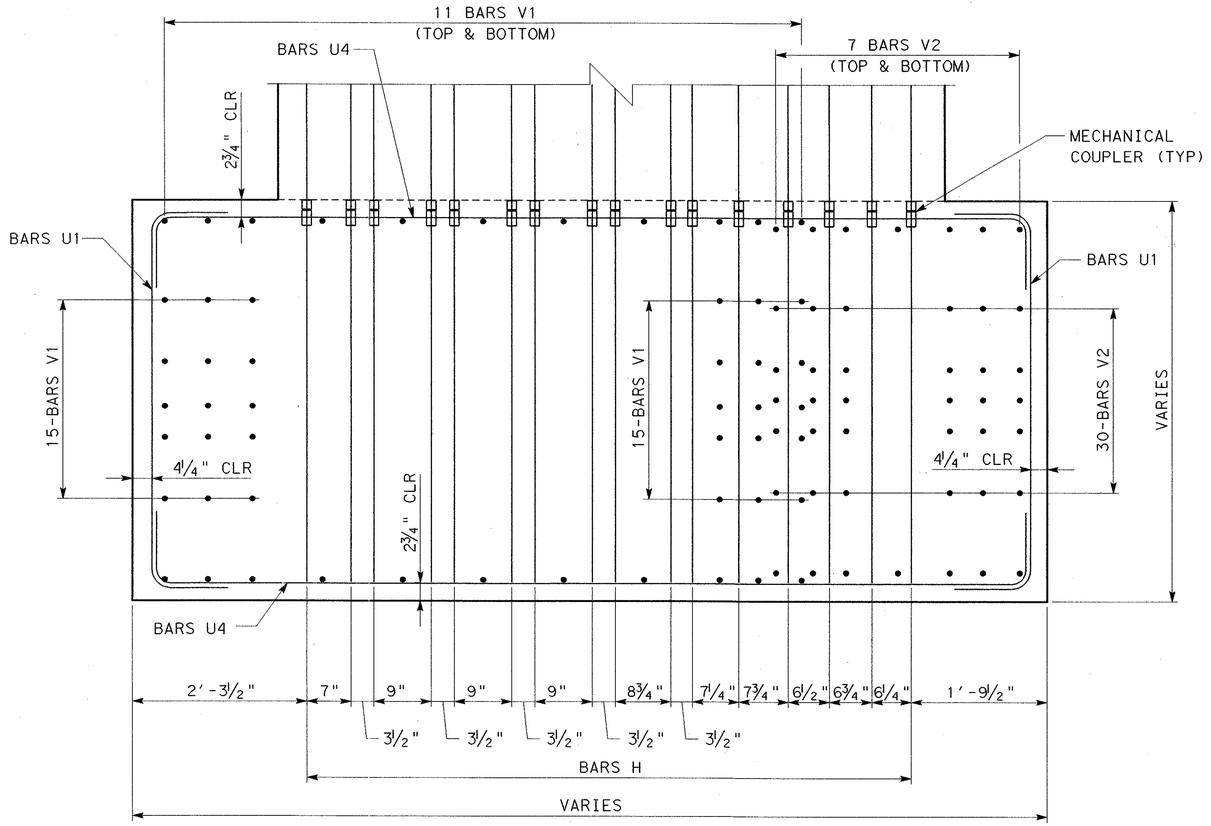

SECTION H-H

STATE OF TEXAS
CLIFF R. HALL
82211
REGISTERED
PROFESSIONAL ENGINEER
7/2/04

264

NO.	DATE	REVISION	APPROV.
1	06/01/04	ADDENDUM CHANGES	CRH

URS GREYSTONE CENTRE
3010 LBJ FREEWAY, SUITE 1300
DALLAS, TX 75234

ARAPAHO ROAD - PHASE III

SURVEYOR BOULEVARD TO ADDISON ROAD

BENTS 9 & 10 DETAILS

SHEET 4 OF 6

TOWN OF ADDISON, TEXAS

Design	Drawn RJB	DATE	SCALE	PROJECT NO.	SHEET NO.
Check	Check	05-07-04	NONE	25768	BR-26

7/2/2004 3:31:41 PM

\\urs\dal\dc1\data\projects\arapaho road bridge\cadd\from tampa\05-24-04\ar3bd0404.dgn