



NORTH ARCH RIB CAMBER DIAGRAM

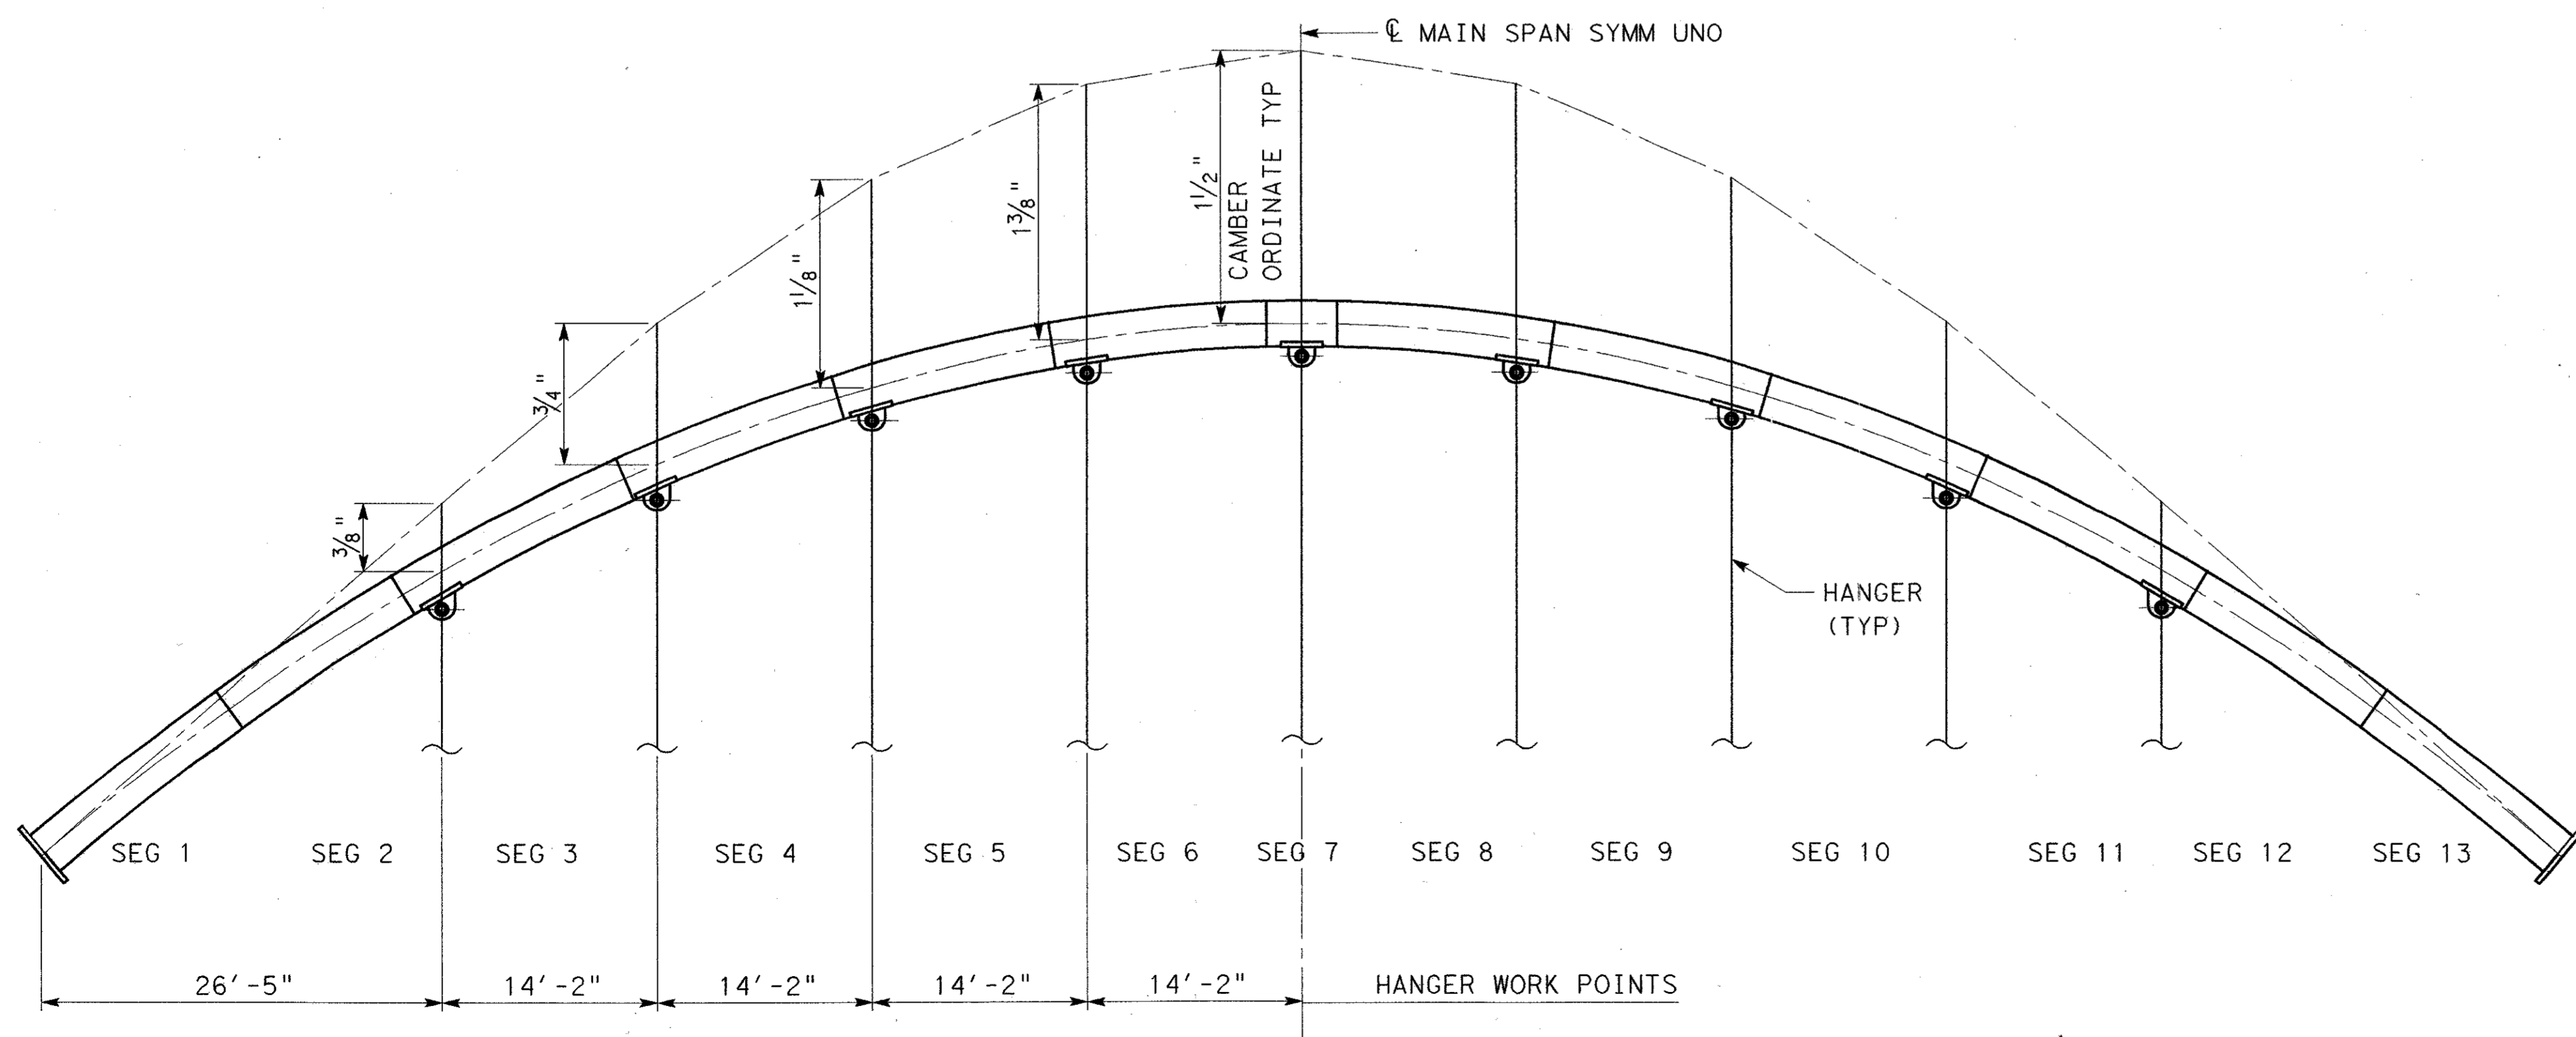

SOUTH ARCH RIB CAMBER DIAGRAM

NOTES

1. CAMBER ORDINATES ARE FOR TOTAL DEAD LOAD (INCLUDING BARRIERS).

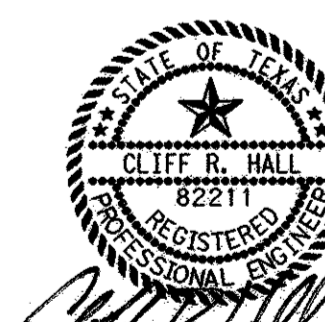

Cliff R. Hall
7/1/04

NO.	DATE	REVISION	APPROV.	277
URS GREYSTONE CENTRE 5010 LBJ FREEWAY, SUITE 1500 DALLAS, TX 75254				
ARAPAHO ROAD - PHASE III SURVEYOR BOULEVARD TO ADDISON ROAD				
ARCH RIB DETAIL UNIT 4				
TOWN OF ADDISON, TEXAS				
Design	Drawn	RJB	DATE	SCALE
Check	Check		05-07-04	NONE
PROJECT NO.			SHEET NO.	
25768			BR-39	