


- LEGEND**
- 614 — EXISTING CONTOUR
  - 612.5 — PROPOSED CONTOUR
  - x 612.42 PROPOSED SPOT GRADE

NOTE:  
 GRADING OUTSIDE PARKING LAYOUT  
 ON THESE PLANS IS FOR ROUGH  
 GRADING. CONTRACTOR TO  
 REFERENCE LANDSCAPE PLANS FOR  
 FINAL GRADES AND ELEVATIONS FOR  
 TRAIL LAYOUT AND LANDSCAPING  
 SCHEME.

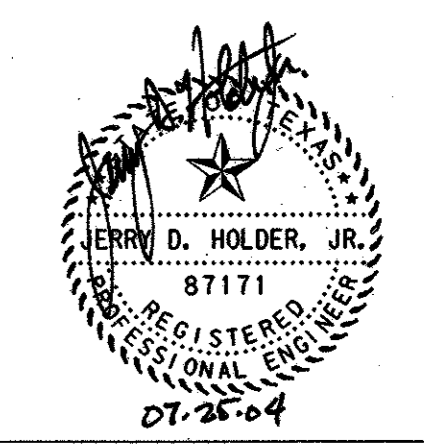

				64	
NO.	DATE	REVISION	APPROV.		
<b>HNTB</b> ARCHITECTS ENGINEERS PLANNERS <i>The HNTB Companies</i>					
<b>ARAPAHO ROAD - PHASE III</b>					
SURVEYOR BOULEVARD TO ADDISON ROAD					
GRADING PLAN PARKING LOT AT ADDISON ROAD					
TOWN OF ADDISON, TEXAS					
Design JSN	Drawn GFS	DATE	SCALE	PROJECT NO.	SHEET NO.
Check JDH	Check JSN	APRIL 04	H: 1" = 20'	25768	G-4

29-JUN-2004 12:30  
 G:\25768-ph3\h1\cds\ar3gd05.dgn