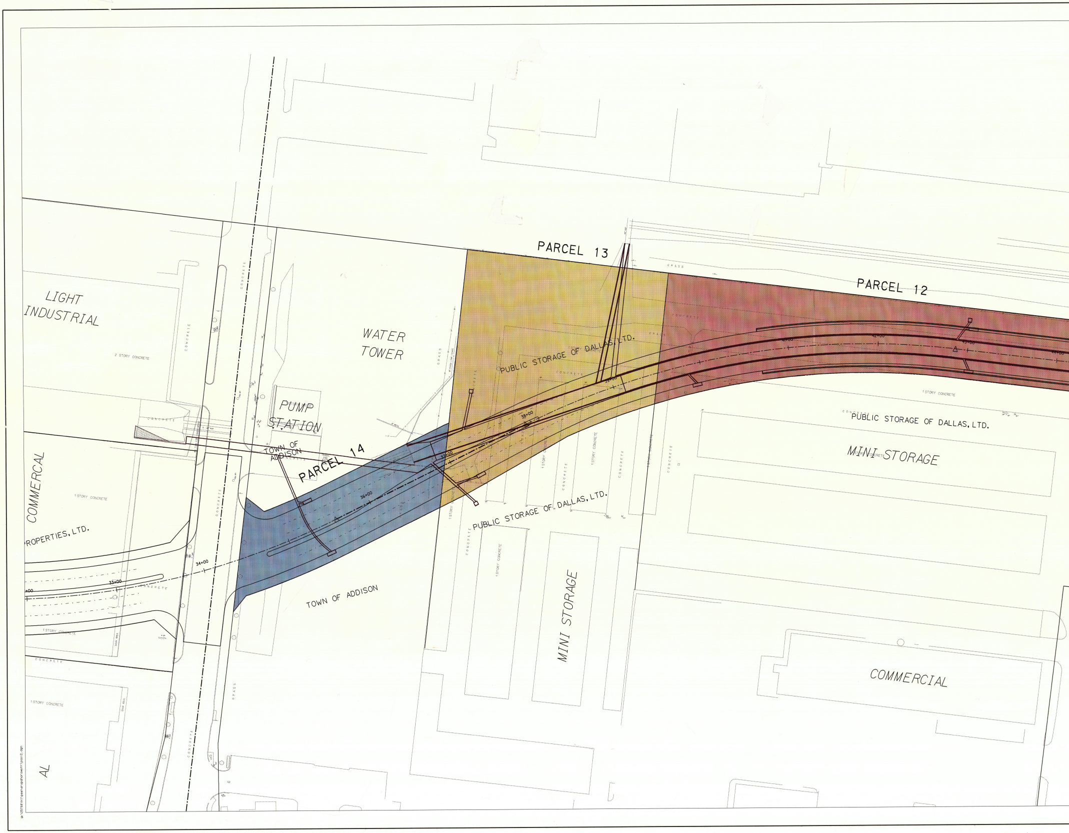
PARCEL 13
PARCEL 12
PARCEL 14
LIGHT INDUSTRIAL
2 STORY CONCRETE
WATER TOWER
PUMP STATION
TOWN OF ADDISON
PUBLIC STORAGE OF DALLAS, LTD.
PUBLIC STORAGE OF DALLAS, LTD.
PUBLIC STORAGE OF DALLAS, LTD.
MINI STORAGE
MINI STORAGE
COMMERCIAL
COMMERCAL
PROPERTIES, LTD.
1 STORY CONCRETE
TOWN OF ADDISON
CONCRETE
GRASS
33+00
34+00
36+00
37+00
38+00
39+00
41+00
42+00
43+00
44+00
AL

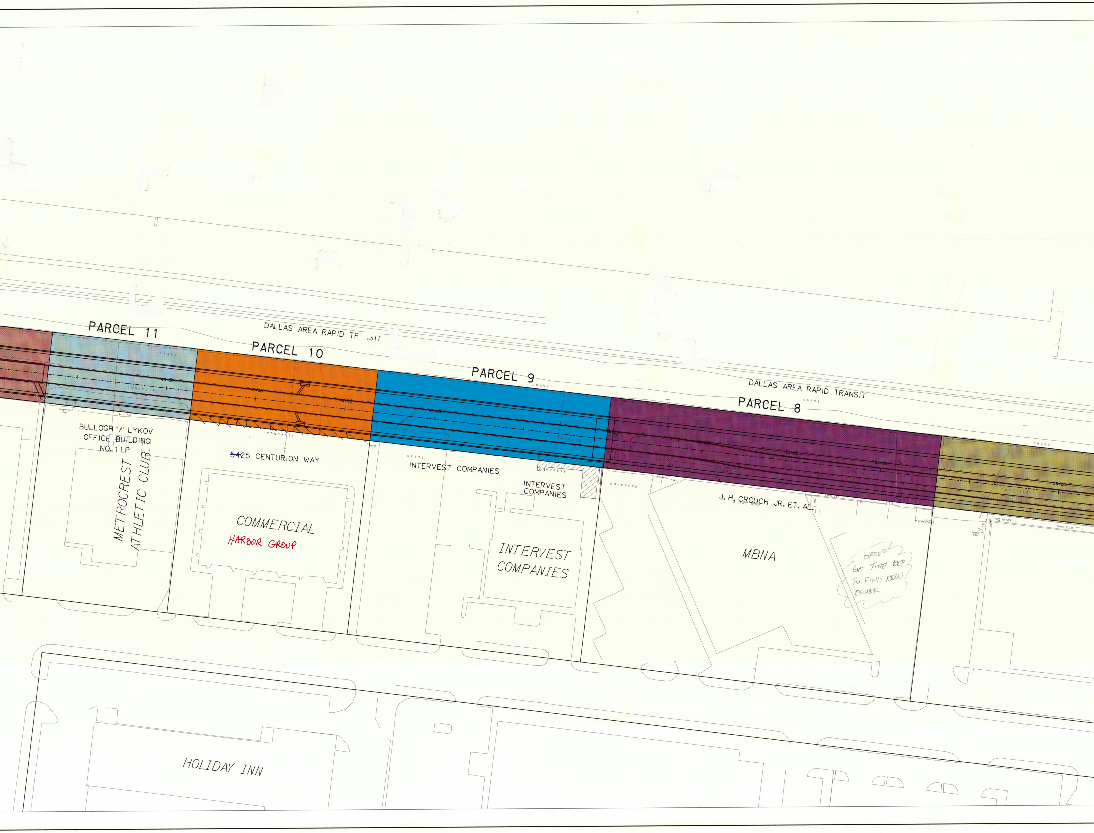
PARCEL 11
DALLAS AREA RAPID TR ..SIT
PARCEL 10
PARCEL 9
DALLAS AREA RAPID TRANSIT
PARCEL 8
GRASS
CONCRETE
BULLOGH / LYKOV
OFFICE BUILDING
NO. 1 LP
METROCREST
ATHLETIC CLUB
5425 CENTURION WAY
COMMERCIAL
HARBOR GROUP
INTERVEST COMPANIES
INTERVEST
COMPANIES
INTERVEST
COMPANIES
J. H. CROUCH JR. ET. AL.
MBNA
ORDER
GET TITLE REP
TO FIND NEW
OWNER
HOLIDAY INN

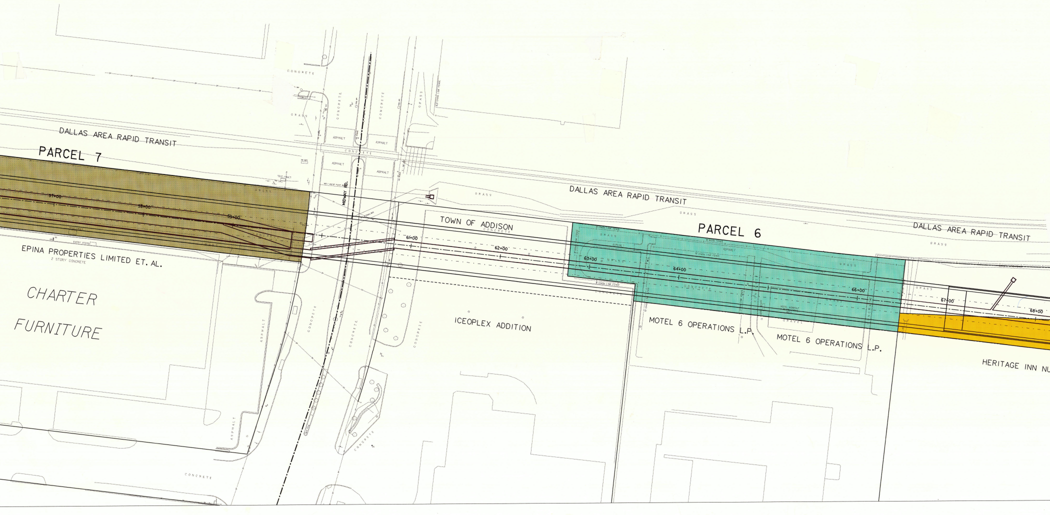
DALLAS AREA RAPID TRANSIT
PARCEL 7
57+00
58+00
59+00
EPINA PROPERTIES LIMITED ET. AL.
2 STORY CONCRETE
CHARTER
FURNITURE
CONCRETE
GRASS
TELE. VAULT
MIDWAY RD.
ASPHALT
ASPHALT
ASPHALT
ASPHALT
CONCRETE
CONCRETE
CONCRETE
GRASS
GRASS
DALLAS AREA RAPID TRANSIT
TOWN OF ADDISON
CONCRETE
61+00
62+00
ICEOPLEX ADDITION
PARCEL 6
GRASS
ASPHALT
ASPHALT
63+00
64+00
66+00
CONCRETE
GRAVEL
MOTEL 6 OPERATIONS L.P.
MOTEL 6 OPERATIONS L.P.
DALLAS AREA RAPID TRANSIT
GRASS
67+00
68+00
HERITAGE INN NU

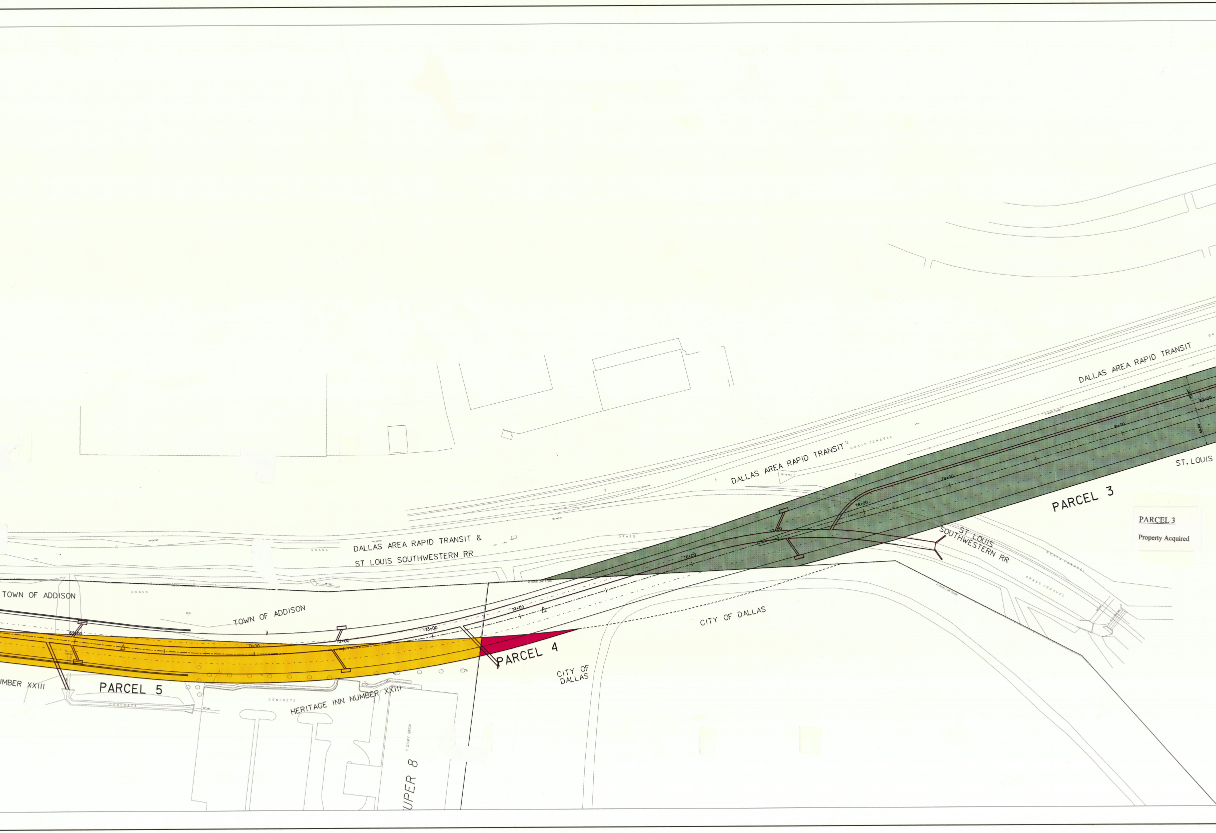
DALLAS AREA RAPID TRANSIT
DALLAS AREA RAPID TRANSIT
DALLAS AREA RAPID TRANSIT &
ST LOUIS SOUTHWESTERN RR
ST. LOUIS
PARCEL 3
PARCEL 3
Property Acquired
ST LOUIS SOUTHWESTERN RR
TOWN OF ADDISON
TOWN OF ADDISON
CITY OF DALLAS
PARCEL 4
CITY OF DALLAS
PARCEL 5
UMBER XXIII
HERITAGE INN NUMBER XXIII
CONCRETE
SUPER 8
GRASS
GRASS/GRAVEL
69+00
71+00
72+00
73+00
74+00
76+00
77+00
78+00
79+00
81+00
82+00

Location 60" Water Main ?

BXJ-13

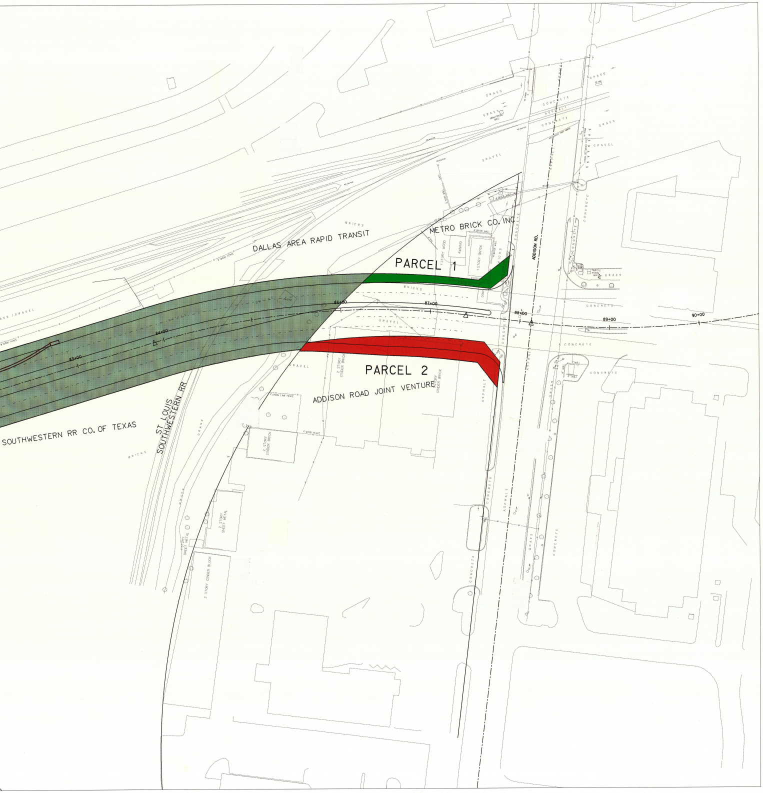
DALLAS AREA RAPID TRANSIT
METRO BRICK CO. INC
PARCEL 1
PARCEL 2
ADDISON ROAD JOINT VENTURE
ST LOUIS SOUTHWESTERN RR
SOUTHWESTERN RR CO. OF TEXAS
ADDISON RD.
83+00
84+00
86+00
87+00
88+00
89+00
90+00
GRASS
GRAVEL
CONCRETE
ASPHALT
BRICKS
2 STORY CINDER BRICK
2 STORY SHEET METAL
2 STORY CINDER BLOCK
1 STORY BRICK
AWNING

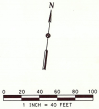
N
0
20
40
60
80
100
1 INCH = 40 FEET

ARAPAHO ROAD

SURVEYOR BLVD TO ADDISON RD
ROW MAP

HNTB
The HNTB Companies