DALLAS AREA RAPID TRANSIT
PROPERTY AQUISITION CORPORATION

NO.	DATE	REVISION	APPROV.
1	06/28/04	REVISED PER ADDENDA	A.K.C.
2	06/28/04	PROFILE REVISED PER G & A	A.K.C.
3			

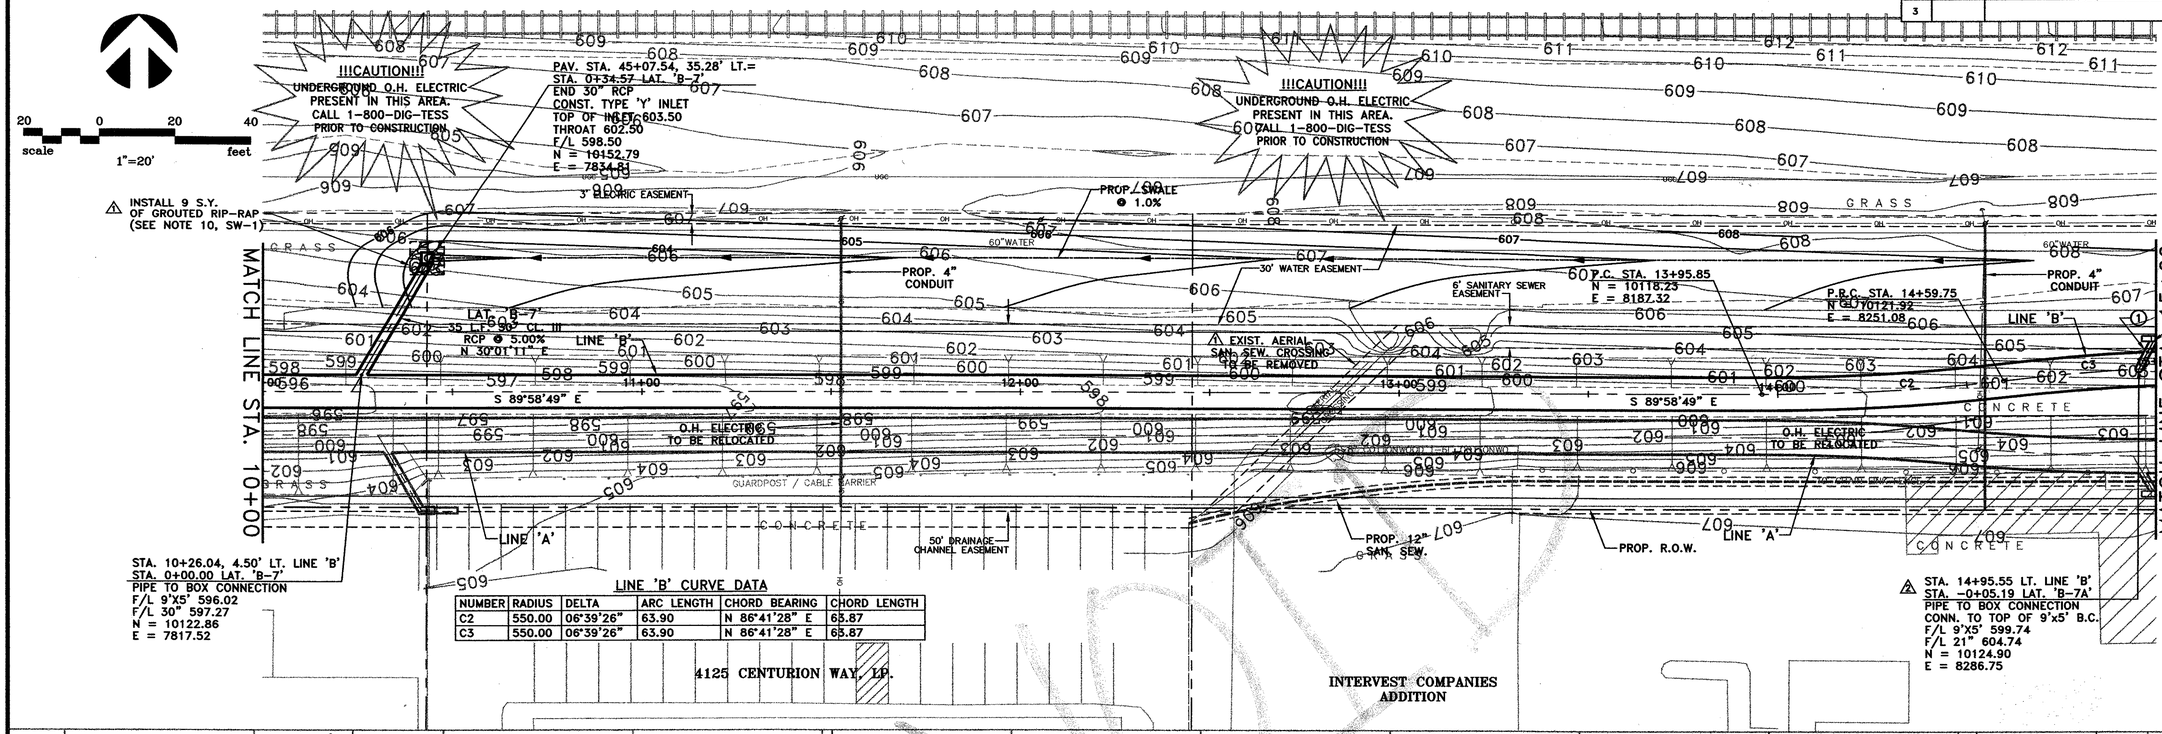

LINE 'B' CURVE DATA

NUMBER	RADIUS	DELTA	ARC LENGTH	CHORD BEARING	CHORD LENGTH
C2	550.00	06°39'26"	63.90	N 86°41'28" E	63.87
C3	550.00	06°39'26"	63.90	N 86°41'28" E	63.87

RECESSED CURB INLET
STANDARD CURB INLET
INLET REFERENCE POINT

① LAT. 'B-7A' 17 L.F. 21" (MEASURED VERTICALLY) CL. III RCP N 27°04'59" E

PAV. STA. 50+83.50, 20' LT.= STA. 0+03.19 LAT. 'B-7A' END 21" RCP CONST. 2 GRATE INLET PER DETAIL TOP OF GRATE 621.62 F/L 21" 617.12 N = 10132.37 E = 8290.57

NOTE
REFER TO SW-1 FOR STORM SEWER NOTES

THE SEAL APPEARING ON THIS DOCUMENT WAS AUTHORIZED BY: A. KATURA CURRY ON 7-21-04.

ALTERATION OF A SEALED DOCUMENT WITHOUT PROPER NOTIFICATION TO THE RESPONSIBLE ENGINEER IS AN OFFENSE UNDER THE TEXAS ENGINEERING PRACTICE ACT.

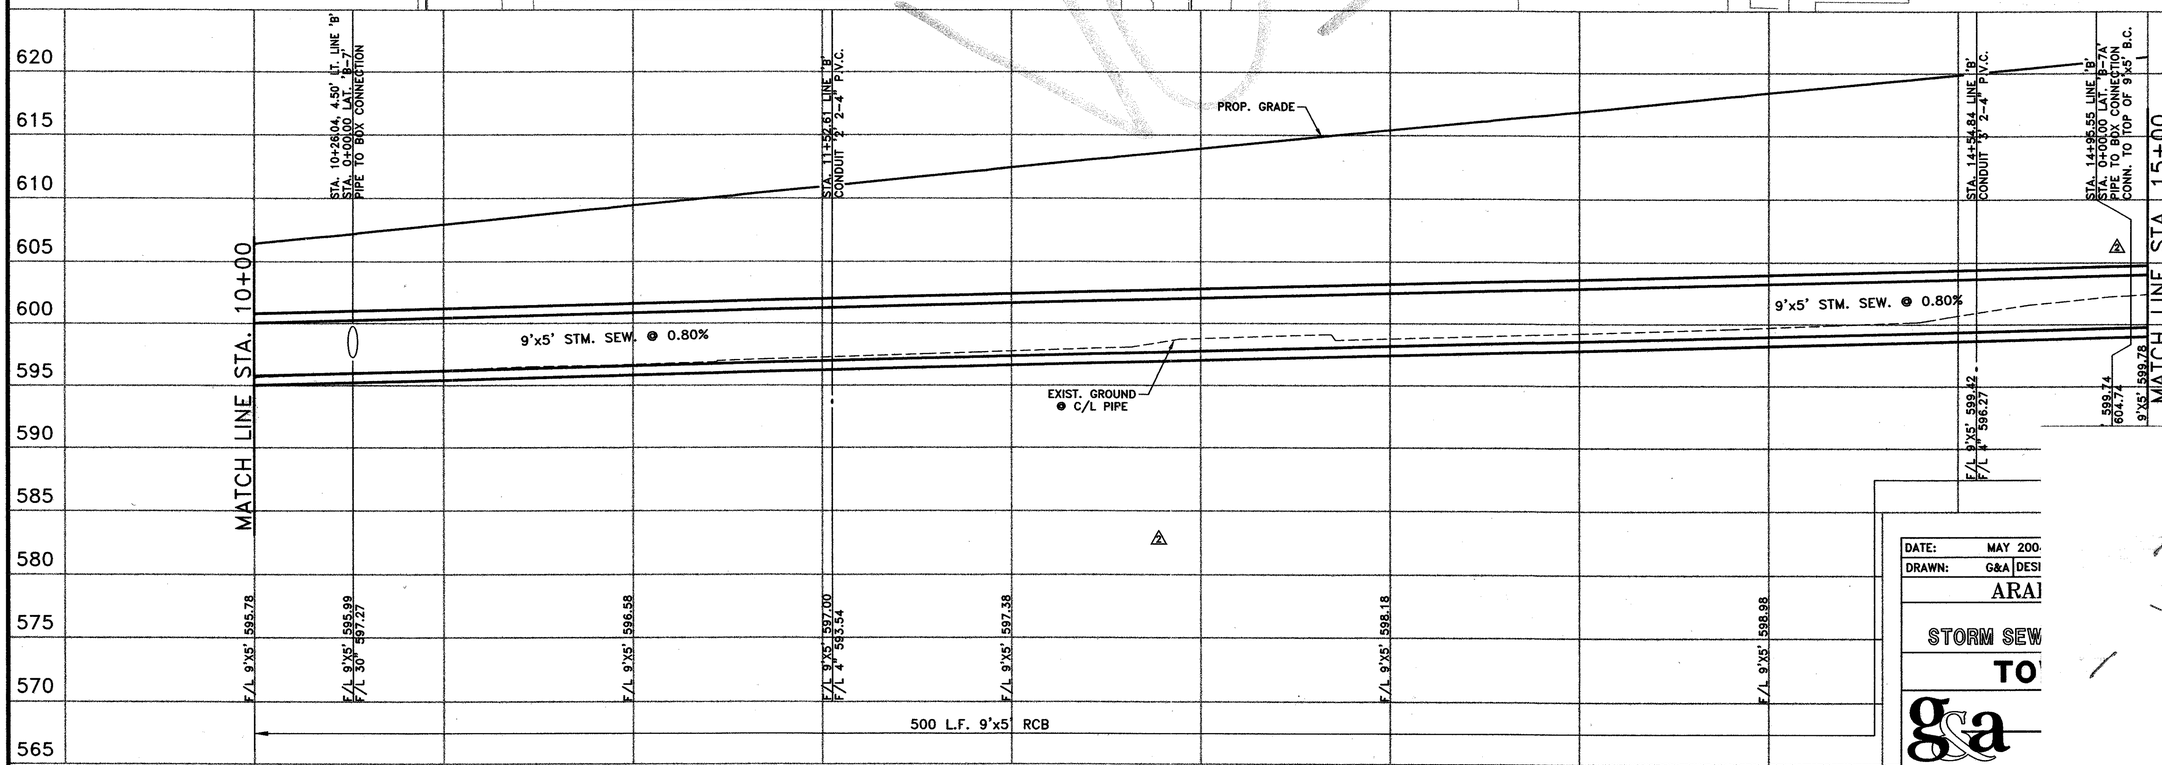

DATE: MAY 200
DRAWN: G&A DESI
ARA
STORM SEW
TO

g&a
1919 S. SHILOH ROAD, SUITE
GARLAND, TEXAS 75042

VOID