


PLANT SCHEDULE		QTY.	COMMON NAME	BOTANICAL NAME	SIZE	CONT.	CONDITION / REMARKS
ORNAMENTAL GRASSES		23	INDIAN GRASS	SORGHASTRUM NUTANS	4" O.C.	5 GAL.	
TURF GRASS		9	LINDHEIMER'S MUHLY	MUHLENBERGIA LINDHEIMERI	4" O.C.	3 GAL.	
COMMON BERMUDA		11,292 SF	COMMON BERMUDA	CYNODON DACTYLON			

VOTED

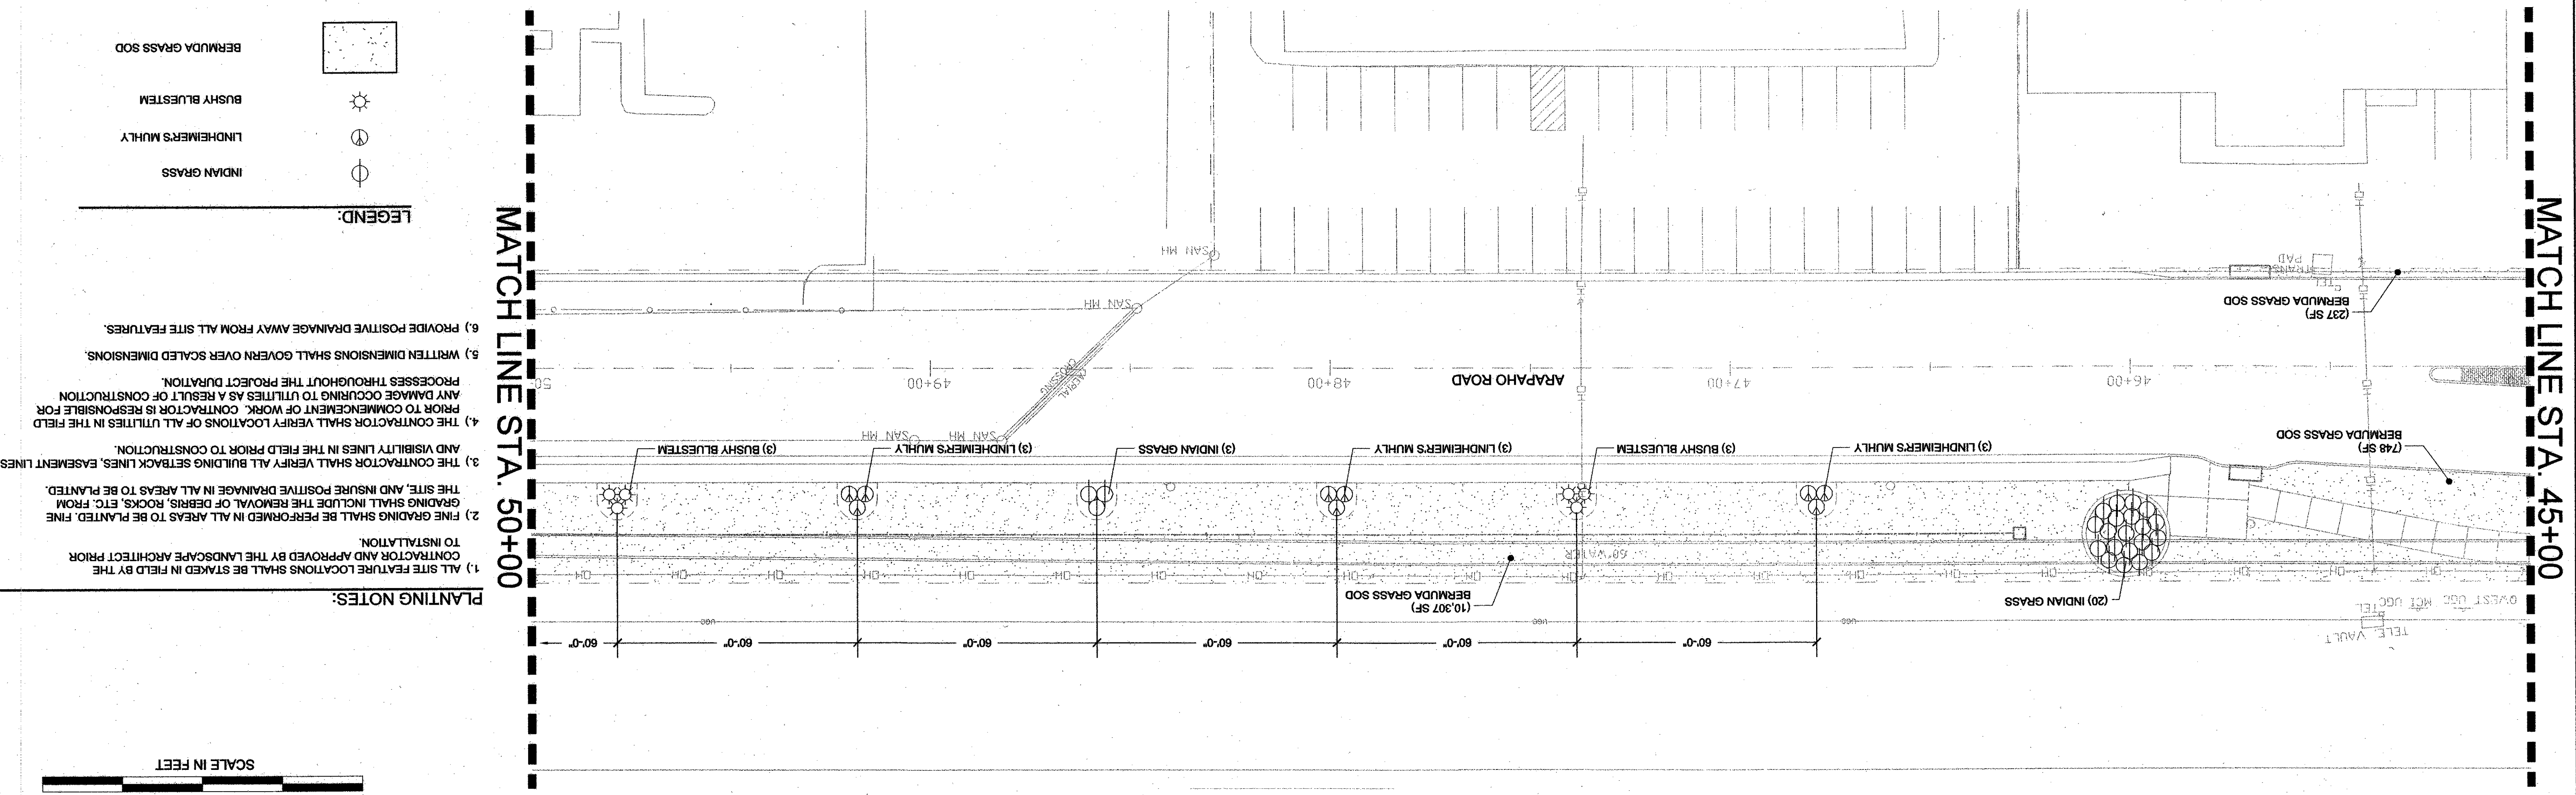


**PLANTING NOTES:**

- 1) ALL SITE FEATURE LOCATIONS SHALL BE STAKED IN FIELD BY THE CONTRACTOR AND APPROVED BY THE LANDSCAPE ARCHITECT PRIOR TO INSTALLATION.
- 2) FINE GRADING SHALL BE PERFORMED IN ALL AREAS TO BE PLANTED. FINE GRADING SHALL INCLUDE THE REMOVAL OF DEBRIS, ROCKS, ETC. FROM THE SITE, AND INSURE POSITIVE DRAINAGE IN ALL AREAS TO BE PLANTED.
- 3) THE CONTRACTOR SHALL VERIFY ALL BUILDING SETBACK LINES, EASEMENT LINES AND VISIBILITY LINES IN THE FIELD PRIOR TO CONSTRUCTION.
- 4) THE CONTRACTOR SHALL VERIFY LOCATIONS OF ALL UTILITIES IN THE FIELD PRIOR TO COMMENCEMENT OF WORK. CONTRACTOR IS RESPONSIBLE FOR ANY DAMAGE OCCURRING TO UTILITIES AS A RESULT OF CONSTRUCTION PROCESSES THROUGHOUT THE PROJECT DURATION.
- 5) WRITTEN DIMENSIONS SHALL GOVERN OVER SCALED DIMENSIONS.
- 6) PROVIDE POSITIVE DRAINAGE AWAY FROM ALL SITE FEATURES.

**LEGEND:**

- BERMUDA GRASS SOD
- BUSHY BLUESTEM
- LINDHEIMER'S MUHLY
- INDIAN GRASS

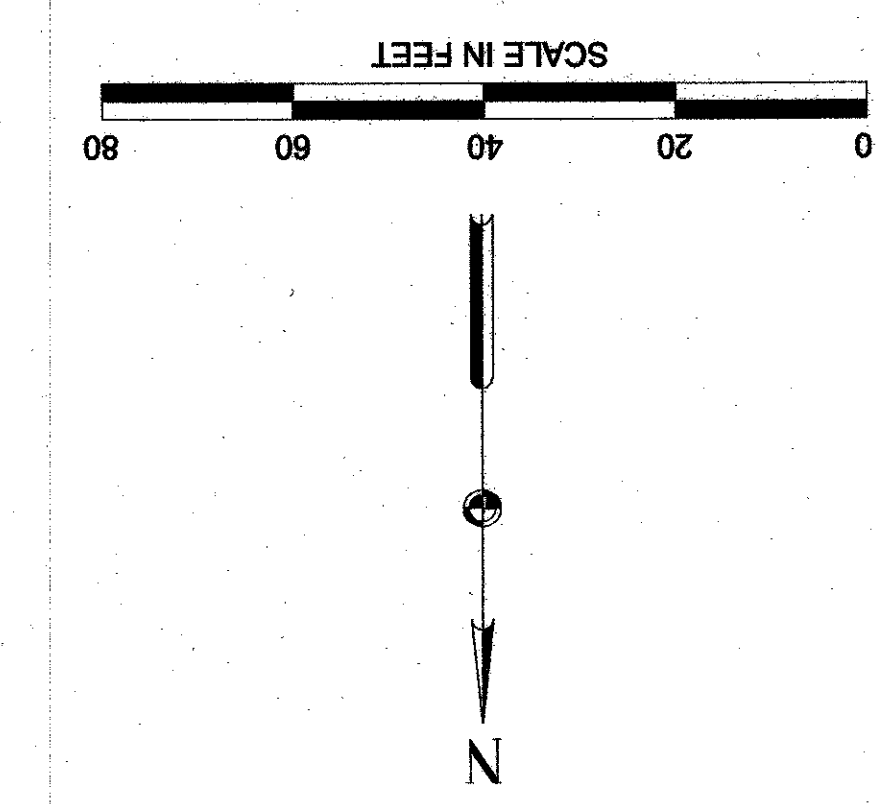

MATCH LINE STA. 45+00

MATCH LINE STA. 50+00

ARAPAHO ROAD

BERMUDA GRASS SOD (237 SF)

BERMUDA GRASS SOD (748 SF)

BERMUDA GRASS SOD (10,307 SF)

(20) INDIAN GRASS

(3) LINDHEIMER'S MUHLY

(3) BUSHY BLUESTEM

(3) INDIAN GRASS

(3) LINDHEIMER'S MUHLY

(3) BUSHY BLUESTEM

TELE. VAULT  
WEST SIDE MET. DUCT TEL.