


QTY.	COMMON NAME	BOTANICAL NAME	SIZE	CONT.	CONDITION / REMARKS
ORNAMENTAL GRASSES					
3	INDIAN GRASS	SORGHASTRUM NUTANS	6 GAL. 4" O.C.		
3	LINDHEIMERS MUHLY	MUHLENBERGIA LINDHEIMERI	3 GAL. 4" O.C.		
TURF GRASS					
4,115 SF	COMMON BERMUDA	CYNODON DACTYLON	SOD		

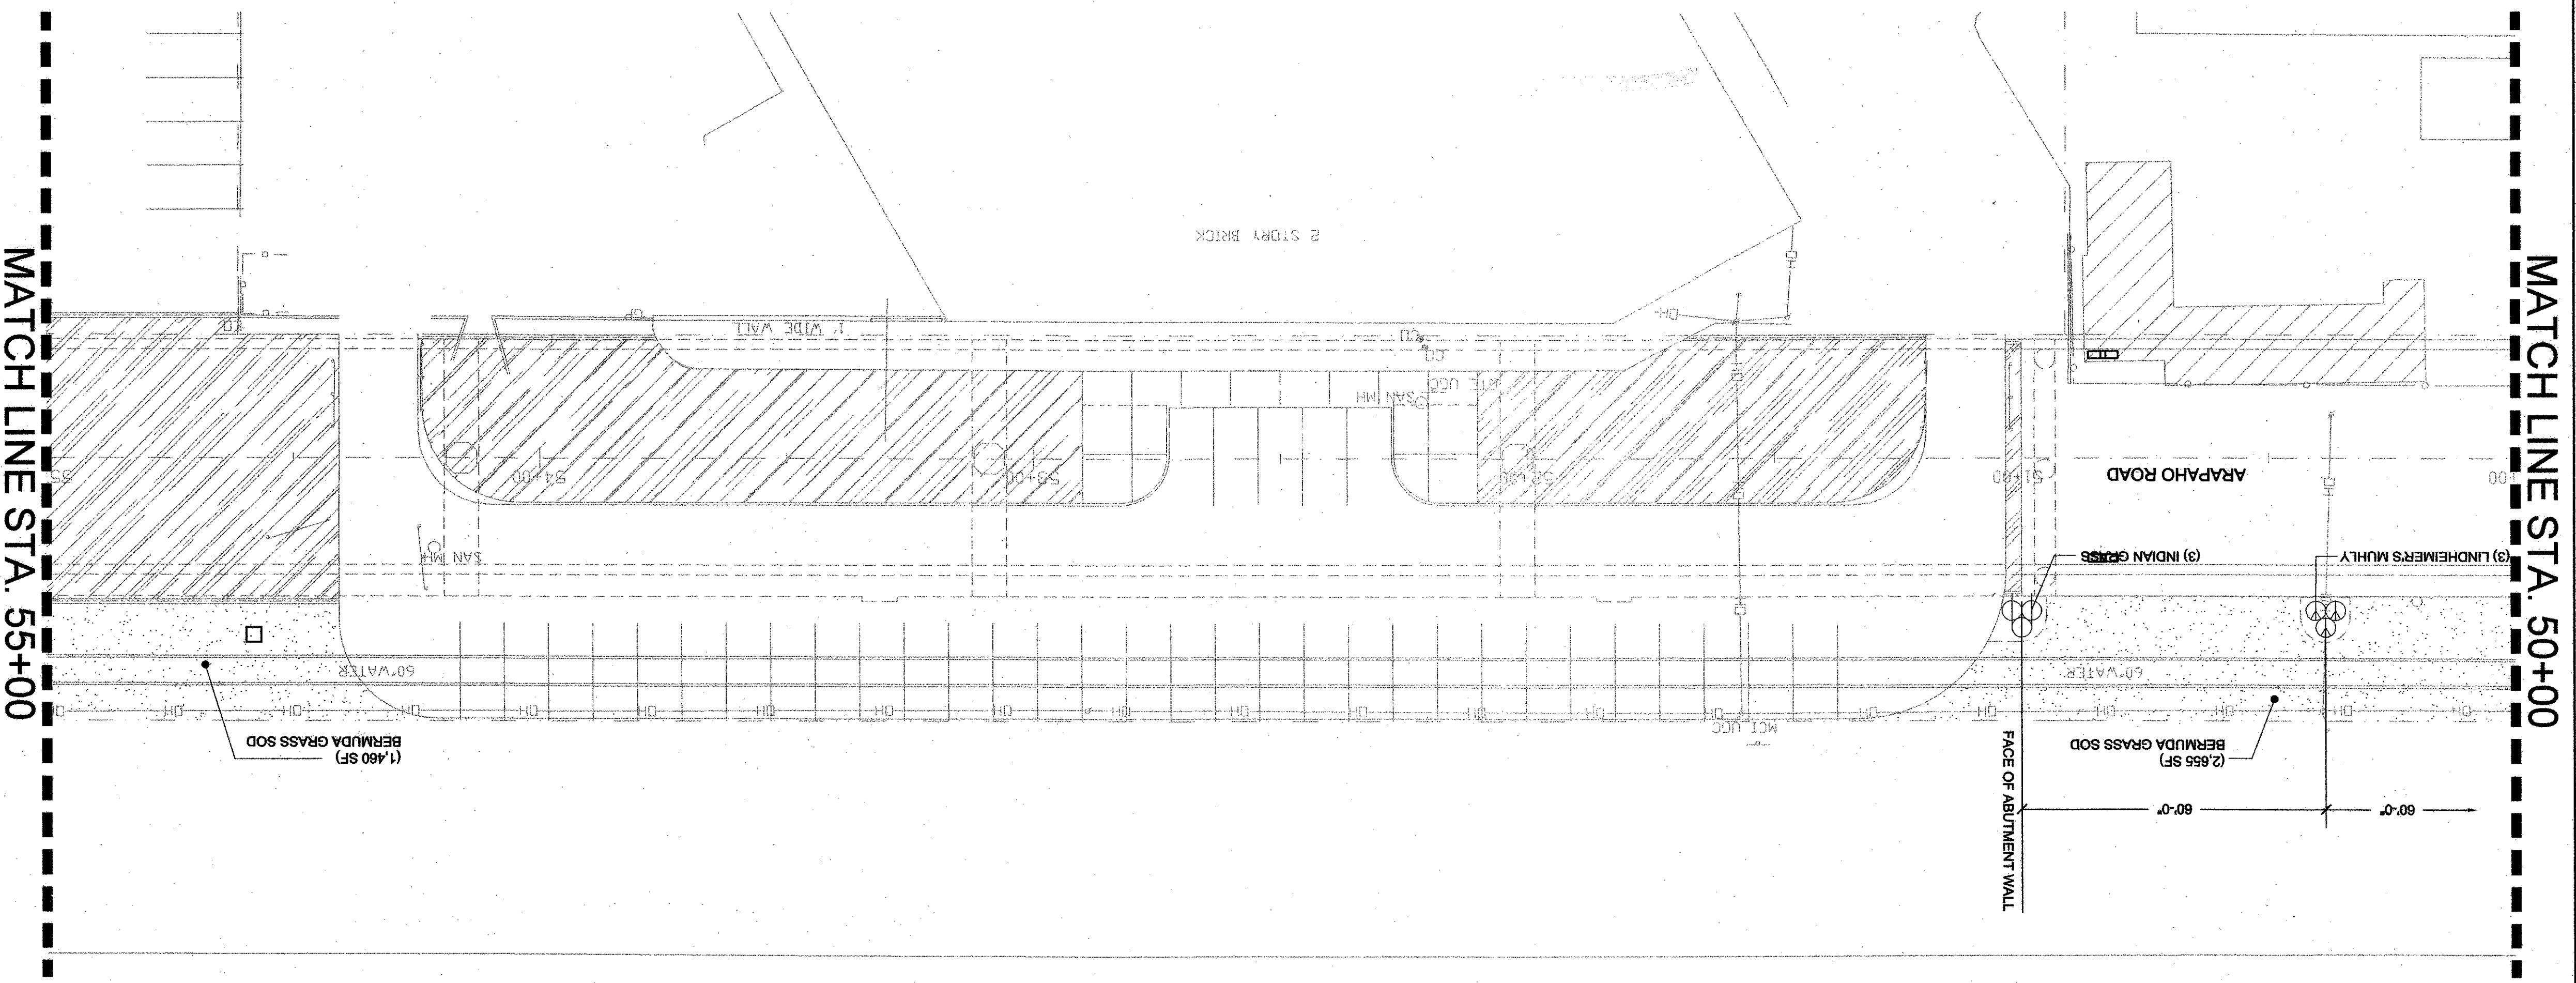



MATCH LINE STA. 55+00

MATCH LINE STA. 50+00

LEGEND:

- INDIAN GRASS
- LINDHEIMERS MUHLY
- BERMUDA GRASS SOD

- PLANTING NOTES:**
- 1) ALL SITE FEATURE LOCATIONS SHALL BE STAKED IN FIELD BY THE CONTRACTOR AND APPROVED BY THE LANDSCAPE ARCHITECT PRIOR TO INSTALLATION.
 - 2) FINE GRADING SHALL BE PERFORMED IN ALL AREAS TO BE PLANTED. FINE GRADING SHALL INCLUDE THE REMOVAL OF DEBRIS, ROCKS, ETC. FROM THE SITE, AND INSURE POSITIVE DRAINAGE IN ALL AREAS TO BE PLANTED.
 - 3) THE CONTRACTOR SHALL VERIFY ALL BUILDING SETBACK LINES, EASEMENT LINES AND VISIBILITY LINES IN THE FIELD PRIOR TO CONSTRUCTION.
 - 4) THE CONTRACTOR SHALL VERIFY LOCATIONS OF ALL UTILITIES IN THE FIELD PRIOR TO COMMENCEMENT OF WORK. CONTRACTOR IS RESPONSIBLE FOR ANY DAMAGE OCCURRING TO UTILITIES AS A RESULT OF CONSTRUCTION PROCESSES THROUGHOUT THE PROJECT DURATION.
 - 5) WRITTEN DIMENSIONS SHALL GOVERN OVER SCALED DIMENSIONS.
 - 6) PROVIDE POSITIVE DRAINAGE AWAY FROM ALL SITE FEATURES.

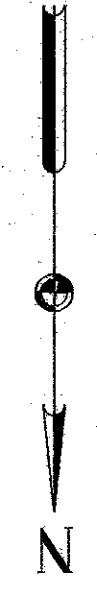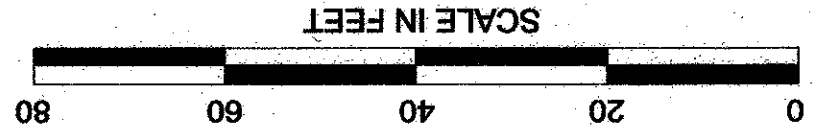

VOID